





Health Dept.

RO 823

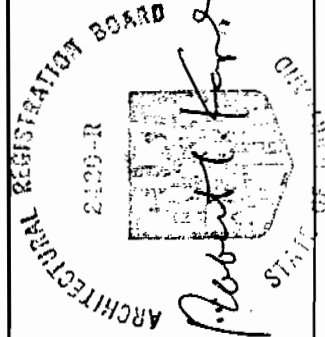

- DATA FROM SURVEY DATED 11/15/05 BY HICKS ENGINEERING ASSOC.  
 - FLOOD ZONE C

*B00158871  
 2nd Story Addition  
 NO new bedrooms  
 OK'D BY  
 MIKE DAVIS  
 4/24/06*

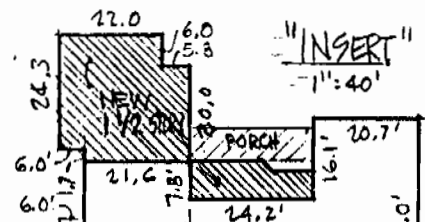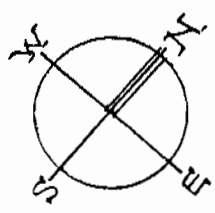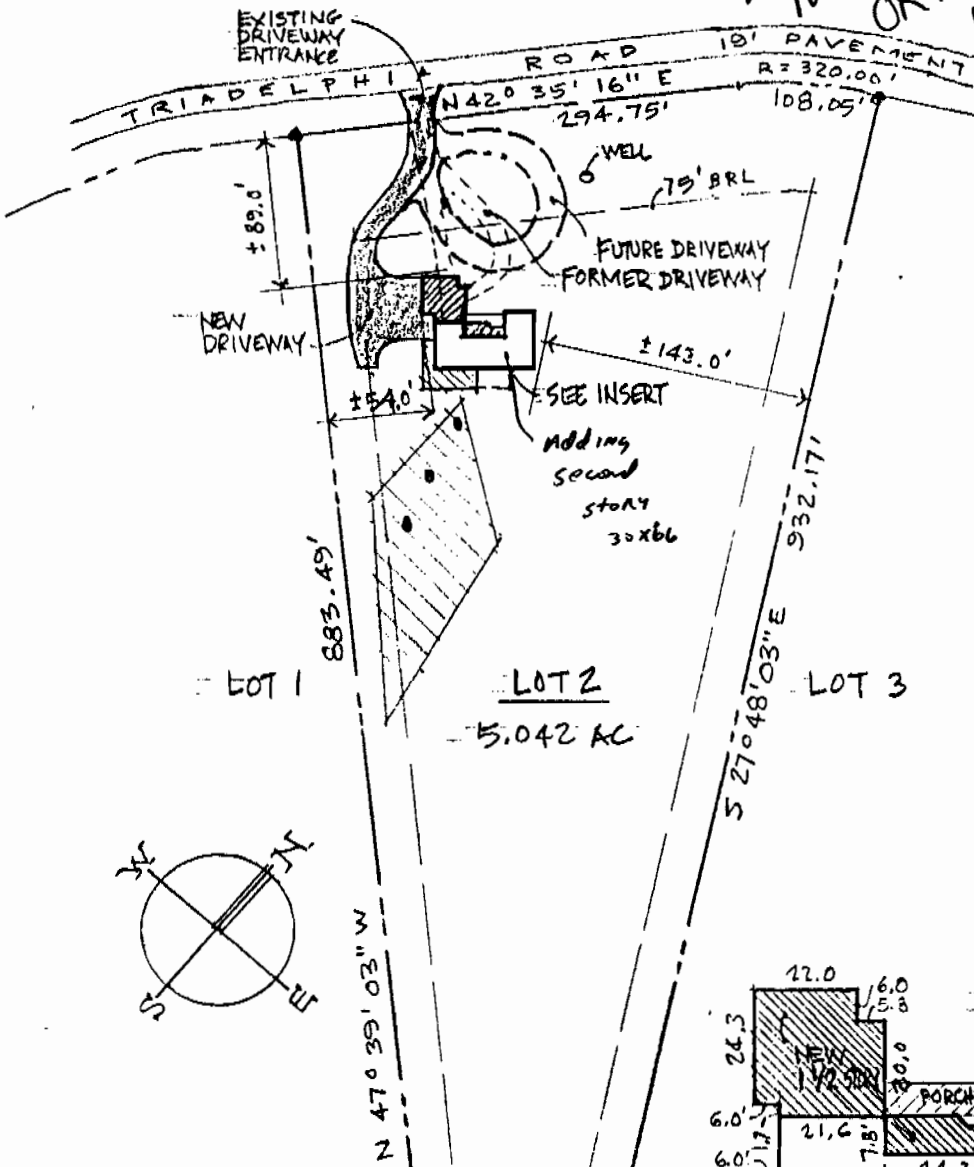

# HECHT RESIDENCE

14895 TRIADELPHIA ROAD, GLENELG, MARYLAND 21737