

6/23/76
1:30 P.M.

APPLICATION

A 23080

P

SEWAGE DISPOSAL TESTING

STATE OF MARYLAND - DEPARTMENT OF HEALTH AND MENTAL HYGIENE

HOWARD COUNTY HEALTH DEPARTMENT
ENVIRONMENTAL HEALTH SERVICES

P. O. BOX 476, ELLICOTT CITY, MARYLAND 21043
TELEPHONE: 465-5000, EXT. 356

DISTRICT 3

DATE 4/7/76

RETEST REQ'D
UNABLE TO
CONFIRM
TESTED LOCATION
TOPOGRAPHY
ETC

9/8/77
Cancelled

4/8/76
4:30
5/27/76 Not perked
9:30
6/15/76
1:30
11:30
CANCELLED

TO: THE COUNTY HEALTH OFFICER
ELLICOTT CITY, MARYLAND

I, HEREBY, APPLY FOR THE NECESSARY TEST IN ORDER TO CONSTRUCT (OR RECONSTRUCT) A SEWAGE DISPOSAL SYSTEM.

PROPERTY OWNER Mark Joseph Belisle, et. al.

ADDRESS _____ PHONE _____
Any questions call:
John Owings, Jr.
922-6800

PROPERTY LOCATION:

SUBDIVISION _____ LOT NO. X(5)

ROAD AND DESCRIPTION Henryton Road - 2 miles North of Md. Rt. 99 - corner of
Colonial Gas Pipe Line & Henryton Rad.

SIZE OF LOT 10.001 acres TYPE BLDG. 3 or 4

NUMBER OF BEDROOMS

IF NOT SINGLE RESIDENCE DESCRIBE _____ (Single Fmly. Dwllg.)

THE SYSTEM INSTALLED UNDER THIS APPLICATION IS ACCEPTABLE ONLY UNTIL PUBLIC FACILITIES BECOME AVAILABLE.

SIGNATURE OF APPLICANT /s/ John Owings, Jr.

APPROVED BY R. Monfild FOR D.W. Trend DATE 6/23/76
(KIND OF SYSTEM)

REJECTED BY _____ FOR _____ DATE _____
(KIND OF SYSTEM)

HOLD PENDING FURTHER TESTS _____ DATE _____

REASONS FOR REJECTION OR HOLDING _____

THIS IS NOT A PERMIT

APPLICATION

A 23080

SEWAGE DISPOSAL TESTING

P _____

STATE OF MARYLAND - DEPARTMENT OF HEALTH AND MENTAL HYGIENE

HOWARD COUNTY HEALTH DEPARTMENT
ENVIRONMENTAL HEALTH SERVICES
P. O. BOX 476, ELLICOTT CITY, MARYLAND 21043
TELEPHONE: 465-5000, EXT. 356

DISTRICT 3

DATE 4/7/76

TO: THE COUNTY HEALTH OFFICER
ELLICOTT CITY, MARYLAND

I, HEREBY, APPLY FOR THE NECESSARY TEST IN ORDER TO CONSTRUCT (OR RECONSTRUCT) A SEWAGE DISPOSAL SYSTEM.

PROPERTY OWNER Mark Joseph Belisla, et. al.

ADDRESS _____ PHONE Any questions call:
John Owings, Jr.
922-6800

PROPERTY LOCATION:

SUBDIVISION _____ LOT NO. X (5)

ROAD AND DESCRIPTION Henryton Road - 2 miles North of Md. Rt. 99 - corner of
Colonial Gas Pipe Line & Henryton Rd.

SIZE OF LOT 10.001 acres TYPE BLDG. 3 or 4

NUMBER OF BEDROOMS

IF NOT SINGLE RESIDENCE DESCRIBE (Single Fmly. Dwllg.)

THE SYSTEM INSTALLED UNDER THIS APPLICATION IS ACCEPTABLE ONLY UNTIL PUBLIC FACILITIES BECOME AVAILABLE.

SIGNATURE OF APPLICANT /s/ John Owings, Jr.

APPROVED BY _____ FOR _____ DATE _____
(KIND OF SYSTEM)

REJECTED BY _____ FOR _____ DATE _____
(KIND OF SYSTEM)

HOLD PENDING FURTHER TESTS _____ DATE _____

REASONS FOR REJECTION OR HOLDING _____

THIS IS NOT A PERMIT

INDICATE NORTH. - NAME ADJOINING ROADWAY AS BASE LINE.


DATE	TEST NO.	DEPTH	PRE-WET		TEST - 1" DROP		TIME
			START	STOP	START	STOP	

REMARKS _____

TYPE OF SOIL _____

TESTED BY _____ ALSO PRESENT: _____

0-4
 clay
 3-4
 sand
 (micaceous)
 3'
 0-1
 clay / loam
 3-5
 low clay
 more sand
 sandy
 2
 rocky (lime
 nodules, range
 deep, with
 dipping base)

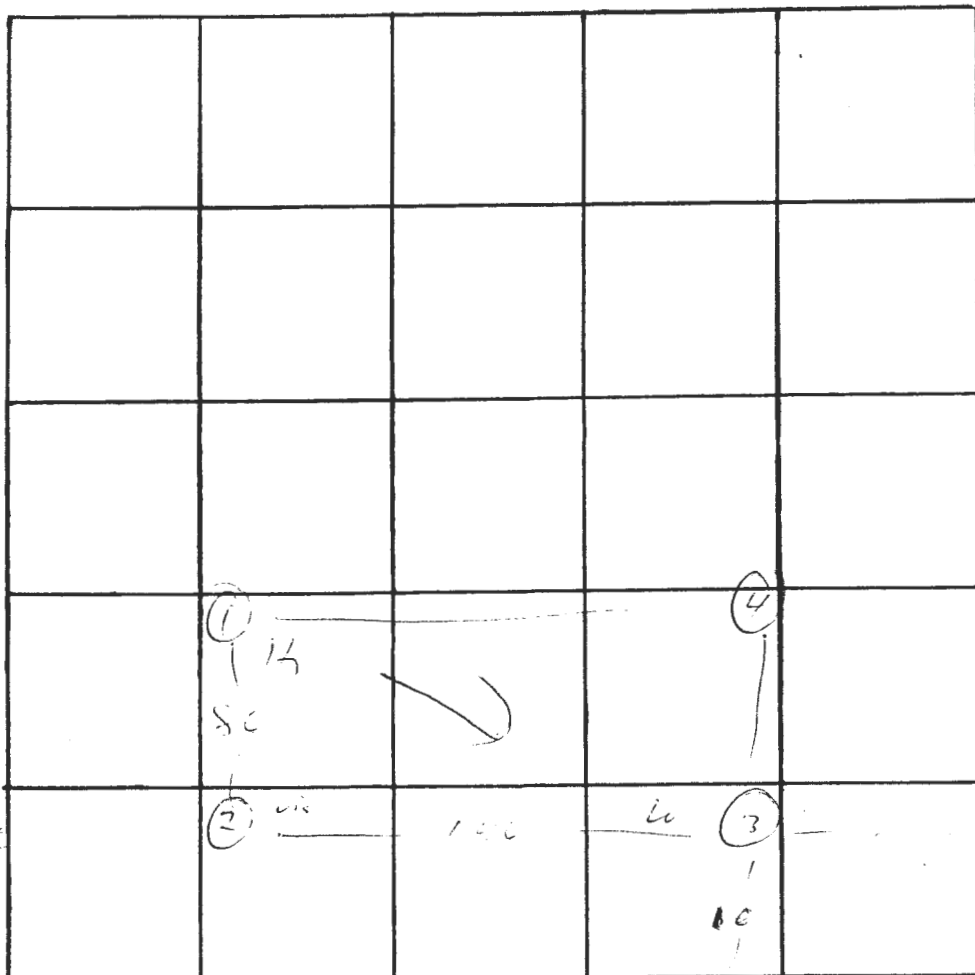

INDICATE NORTH. - NAME ADJOINING ROADWAY AS BASE LINE.

See plat of highway 1-1

DATE	TEST NO.	DEPTH	PRE-WET		TEST - 1" DROP		TIME
			START	STOP	START	STOP	
6/23	1	41	3 ¹⁶	3 ¹⁷	3 ¹⁷	3 ¹⁸	1
	1A	13	3 ¹⁸	3 ¹⁹	3 ¹⁹	3 ²¹	2
	2	13	vis	same (dry)			
	3	3	3 ²⁵	3 ³²	1/4" drop		3x
	3A	12	vis	rocky @ Bottom (quantity checked)			
	3B	10	3 ²⁹	3 ³¹	3 ³¹	3 ³⁵	4
	3C	4	3 ³²	3 ³⁸	3 ³⁸	3 ⁴²	10
	4	4	3 ³⁶	3 ³⁷	3 ³⁷	3 ³⁹	2
	5	14	3 ³⁸	3 ⁴⁰	3 ⁴⁰	3 ⁴²	4

REMARKS _____

TYPE OF SOIL _____

TESTED BY R. M. ALSO PRESENT: C. M.




W. J. Purdum
PURDUM & JESCHKE
ENGINEERS & LAND SURVEYORS
3697 PARK AVENUE
ELLICOTT CITY, MARYLAND 21043

PARCEL NO. 5
PROPERTY OF
DAVID A. CARNEY, ET AL.
3RD ELECTION DISTRICT
HOWARD COUNTY, MARYLAND
MAY 25, 1976
SCALE: 1" = 100'

APPROVED: For private water and private
sewerage systems. Howard County Health Dept.

County Health Officer _____ Date _____

NOTE: The lot shown hereon complies
with minimum ownership width and lot
area as required by the Maryland State
Department of Health Regulations.

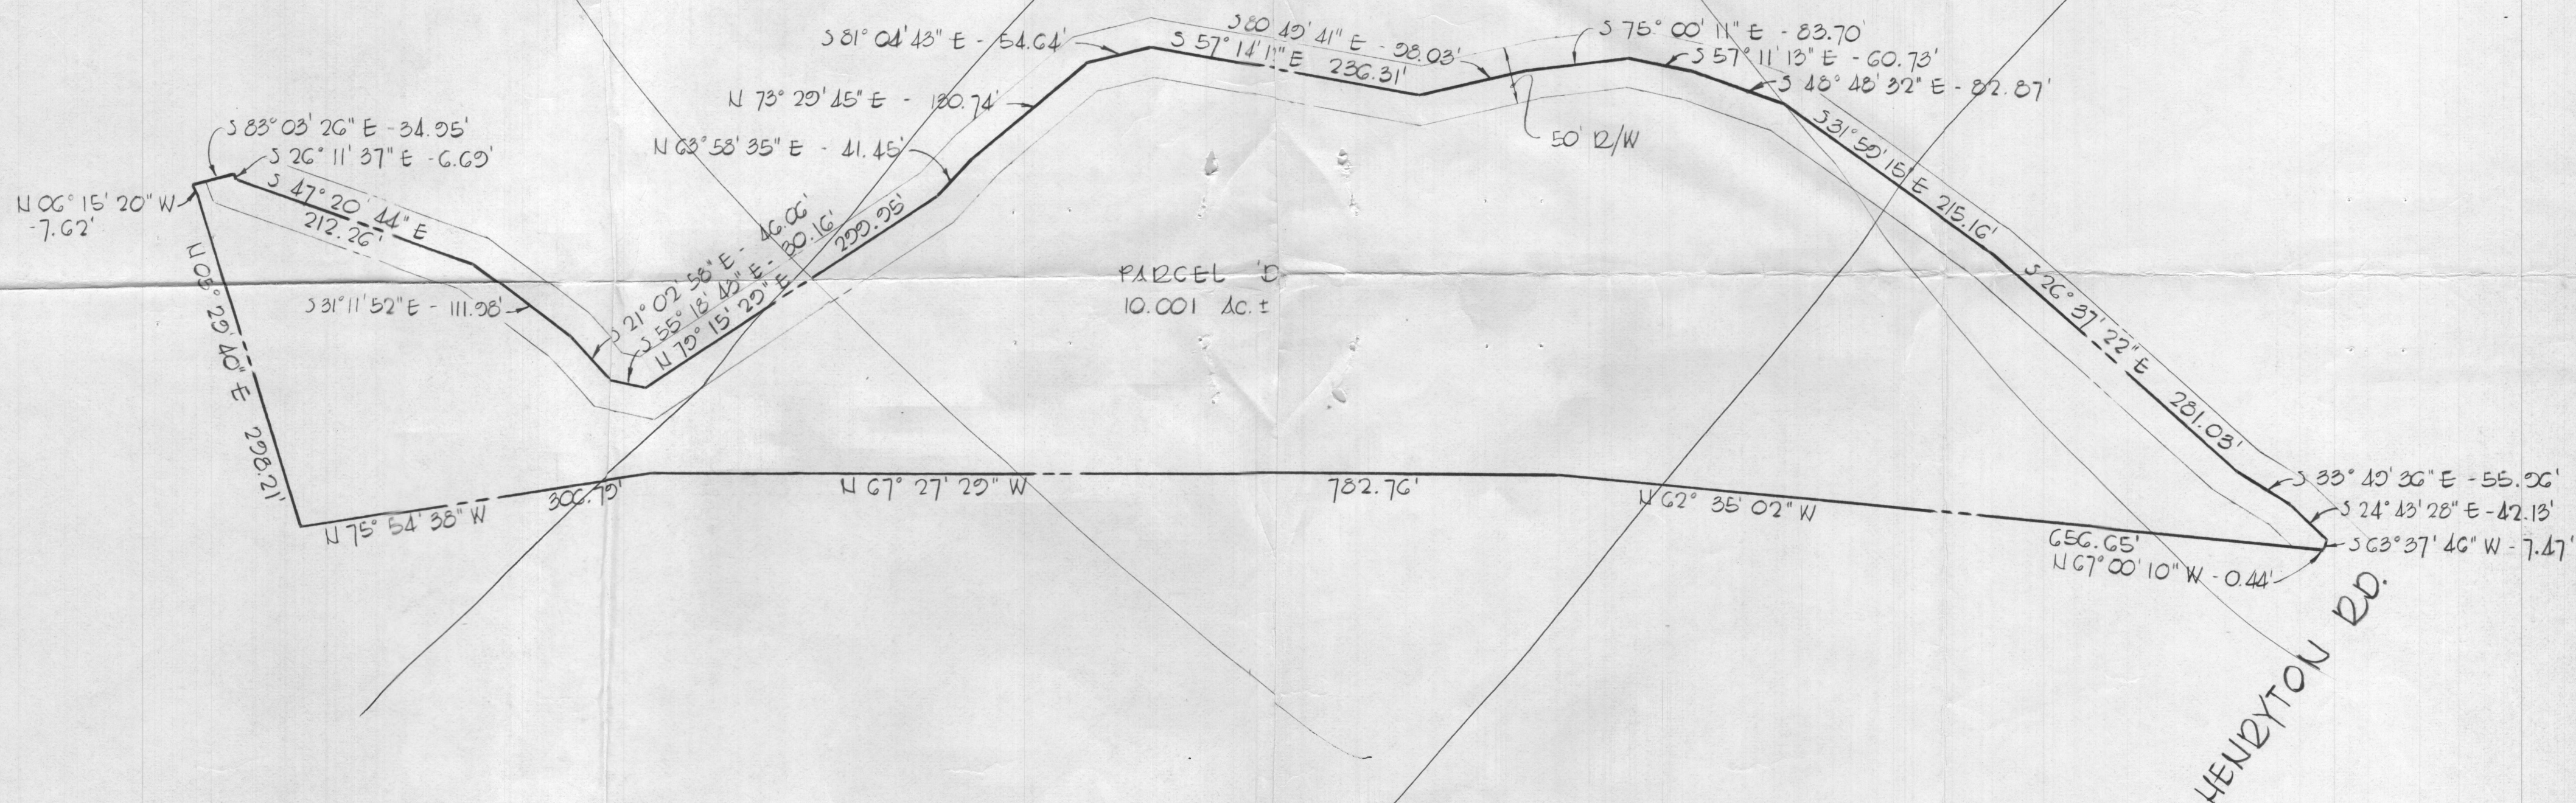

PURDUM & JESCHKE
CONSULTING ENGINEERS
AND LAND SURVEYORS
1023 N. Calvert Street
Baltimore, Maryland #21202

William C. Rasch II 3/5/76
William C. Rasch II Reg. No. 4575 Date

Any questions
please:
John A. ...
922-8800
PARCEL 'D'
PROPERTY OF
MARK JOSEPH BELISLE, ET. AL.
THIRD ELECTION DISTRICT HOWARD COUNTY, MD
March 4, 1976
Scale: 1" = 100'