

3/26/75

app. 3-31-75  
JLM

# PERMIT

SEWAGE DISPOSAL SYSTEM

MARYLAND STATE DEPARTMENT OF HEALTH

HOWARD COUNTY

## INDEXED

P. 21056

A. 18190

ELLICOTT CITY

DISTRICT 2

DATE 12/27/74

Emerson Feaga IS PERMITTED TO INSTALL  ALTER

ADDRESS Old Frederick Road, Woodstock, Md. PHONE 320-2481

A SEWAGE DISPOSAL SYSTEM LOCATED AT \_\_\_\_\_

SUBDIVISION Mt. Hebron ROAD Furrow Drive LOT 5, Blk. H,

Sec. 14

PROPERTY OWNER Mt. Hebron, Inc.

ADDRESS \_\_\_\_\_

SPECIFICATIONS - 4 bedrooms

DRAIN FIELD \_\_\_\_\_ DEPTH \_\_\_\_\_ FEET. BOTTOM AREA \_\_\_\_\_ SQ. FT.

SEEPAGE PITS \_\_\_\_\_ ABSORBENT SIDE-WALL AREA \_\_\_\_\_ SQ. FT.

SEPTIC TANK CAPACITY 1250 GALLONS

FOR GARBAGE GRINDER, INCREASE DISPOSAL AREA 22% & TANK CAPACITY 50%.

OTHER Dry well - 144 sq. ft. absorbent sidewall area per bedroom to begin below

the first 4 ft. of non porous soil. Max. depth permitted is 11 ft. Locate dry well 136 ft.

from rear lot line and 19 ft. from right side line as seen from Furrow Drive.

NOTE: ALL PIPE FROM HOUSE TO DISPOSAL AREA MUST BE CAST IRON.

PERMIT VOID AFTER THREE YEARS.

NOTE: INSTALL STAND PIPES ON SEPTIC TANK AND DRY WELL - STAND PIPES MUST BE 6" IN DIA.  
CAST IRON, CONCRETE OR TERRA COTTA ACCEPTED.


PLANS APPROVED BY Robert Torae/D. Monaghan DATE 8/15/74

FILL SEPTIC TANK AND DISTRIBUTION BOX WITH WATER BEFORE CALLING FOR AN INSPECTION. COVER NO WORK UNTIL INSPECTED AND APPROVED.

NEITHER THE HOWARD COUNTY COMMISSIONERS NOR THE HEALTH DEPARTMENT IS RESPONSIBLE FOR THE SUCCESSFUL OPERATION OF ANY SYSTEM.

A 18190

*[Handwritten signatures and notes at the bottom of the page]*

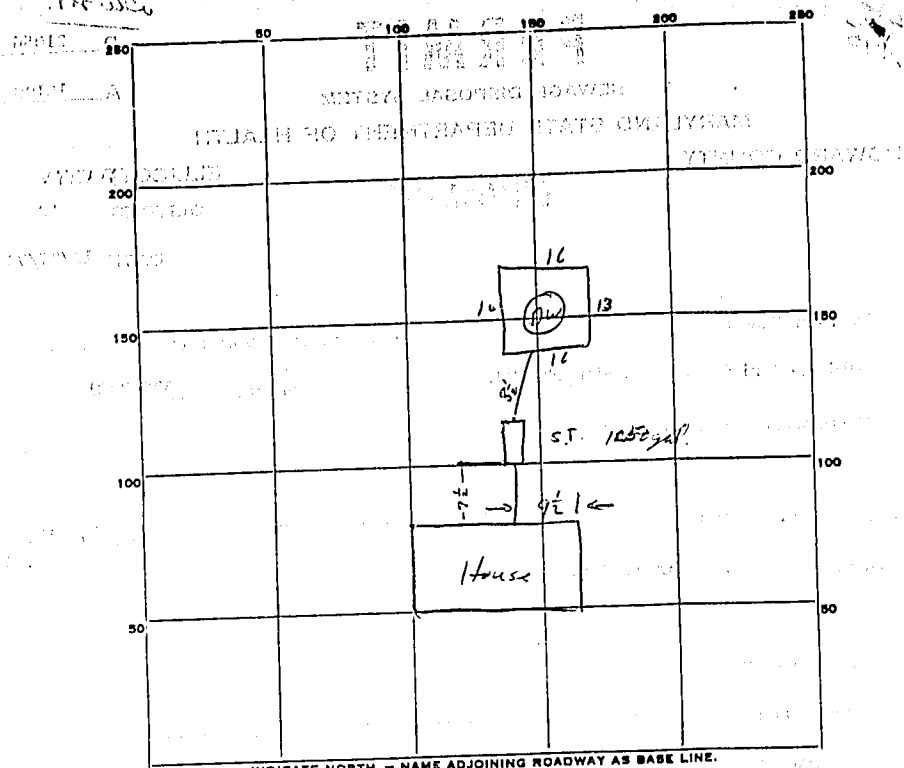

INDICATE NORTH. - NAME ADJOINING ROADWAY AS BASE LINE.

← Furrow Dr. →

PERMIT CARD

SEPTIC TANK, LEVEL  CLEANOUTS

DISTRIBUTION BOX, LEVEL \_\_\_\_\_

TILE FIELD, DEPTH \_\_\_\_\_ FT. TRENCH WIDTH \_\_\_\_\_ FT.

GRAVEL DEPTH \_\_\_\_\_ IN. TOTAL LENGTH \_\_\_\_\_ FT.

NUMBER OF TRENCHES \_\_\_\_\_ TOTAL BOTTOM AREA \_\_\_\_\_

SEEPAGE PITS, INSIDE DIAMETER Perimeter 61 FT. DEPTH BELOW INLET 10 1/2 FT. (14 1/2' deep)

ABSORBENT AREA 427 SQ. FT. / 640 sq ft if allowed (7' ok to use)

144  
876

REMARKS

150 sq ft short

(2) 3 1/2 ft too deep

R.M.

DATE SYSTEM APPROVED 3/3/75 INSPECTOR W. Money

PRELIMINARY

# APPLICATION

A 18190

## SEWAGE DISPOSAL TESTING

P \_\_\_\_\_

STATE OF MARYLAND DEPARTMENT OF HEALTH AND MENTAL HYGIENE

HOWARD COUNTY HEALTH DEPARTMENT  
ENVIRONMENTAL HEALTH SERVICES  
P. O. BOX 476, ELLICOTT CITY, MARYLAND 21043  
TELEPHONE: 465-5000, EXT. 356

DISTRICT 2nd

DATE 3/28/73

TO: THE COUNTY HEALTH OFFICER  
ELLICOTT CITY, MARYLAND

I, HEREBY, APPLY FOR THE NECESSARY TEST IN ORDER TO CONSTRUCT (OR RECONSTRUCT) A SEWAGE DISPOSAL SYSTEM.

PROPERTY OWNER Mt. Hebron, Inc.

ADDRESS 2417 Mt. Hebron Drive, Ellicott City, Md. PHONE 465-2869

PROPERTY LOCATION:

SUBDIVISION Mt. Hebron LOT NO. Lot 5, Blk. G, Sect. 14  
2075 2869

ROAD AND DESCRIPTION Furrow Drive

SIZE OF LOT 23,700 sq. ft. TYPE BLDG. 3 or 4 bedrooms  
NUMBER OF BEDROOMS

IF NOT SINGLE RESIDENCE-DESCRIBE \_\_\_\_\_

THE SYSTEM INSTALLED UNDER THIS APPLICATION IS ACCEPTABLE ONLY UNTIL PUBLIC FACILITIES BECOME AVAILABLE.

SIGNATURE OF APPLICANT /s/ H. J. Baker, Jr.

APPROVED BY \_\_\_\_\_ FOR \_\_\_\_\_ DATE \_\_\_\_\_  
(KIND OF SYSTEM)


REJECTED BY \_\_\_\_\_ FOR \_\_\_\_\_ DATE \_\_\_\_\_  
(KIND OF SYSTEM)

HOLD PENDING FURTHER TESTS \_\_\_\_\_ DATE \_\_\_\_\_

REASONS FOR REJECTION OR HOLDING \_\_\_\_\_

# THIS IS NOT A PERMIT

MOITAB 1199A

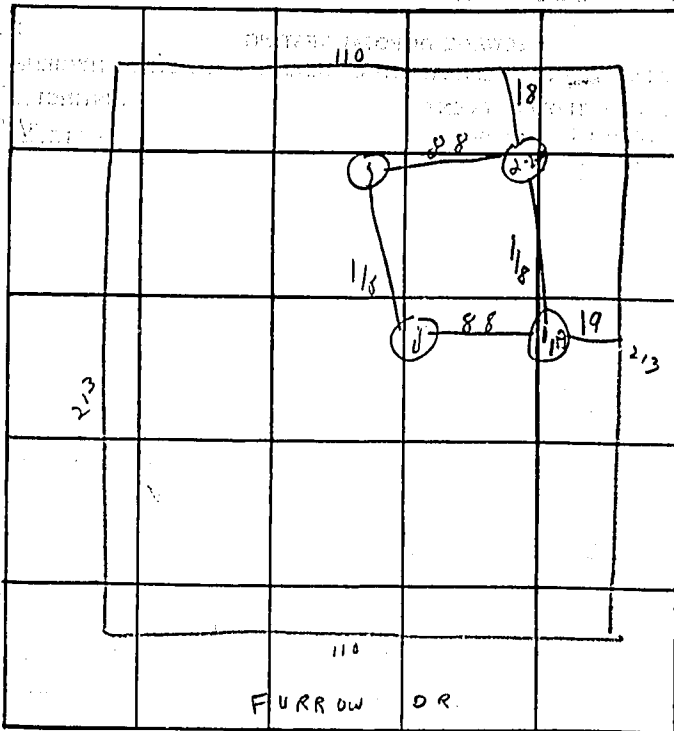

INDICATE NORTH. - NAME ADJOINING ROADWAY AS BASE LINE.

LOT 5  
R.C.G.

DATE	TEST NO.	DEPTH	PRE-WET		TEST - 1" DROP		TIME	
			START	STOP	START	STOP		
3-9-97	1	4'	11 26	11 44	11 44	11 58	14 min	
	1A	11'	11 36	11 40	11 40	11 47	7 min	
	2	4'	11 43	11 48	11 48	12 00	12 min	
	2A	10'	11 43	11 47	11 47	11 57	10 min	
	3	good soil water						
	4							



Aug 2 min  
11 min  
Total 44 min

REMARKS \_\_\_\_\_

TYPE OF SOIL \_\_\_\_\_

TESTED BY D.M.M. ALSO PRESENT: \_\_\_\_\_

A18190

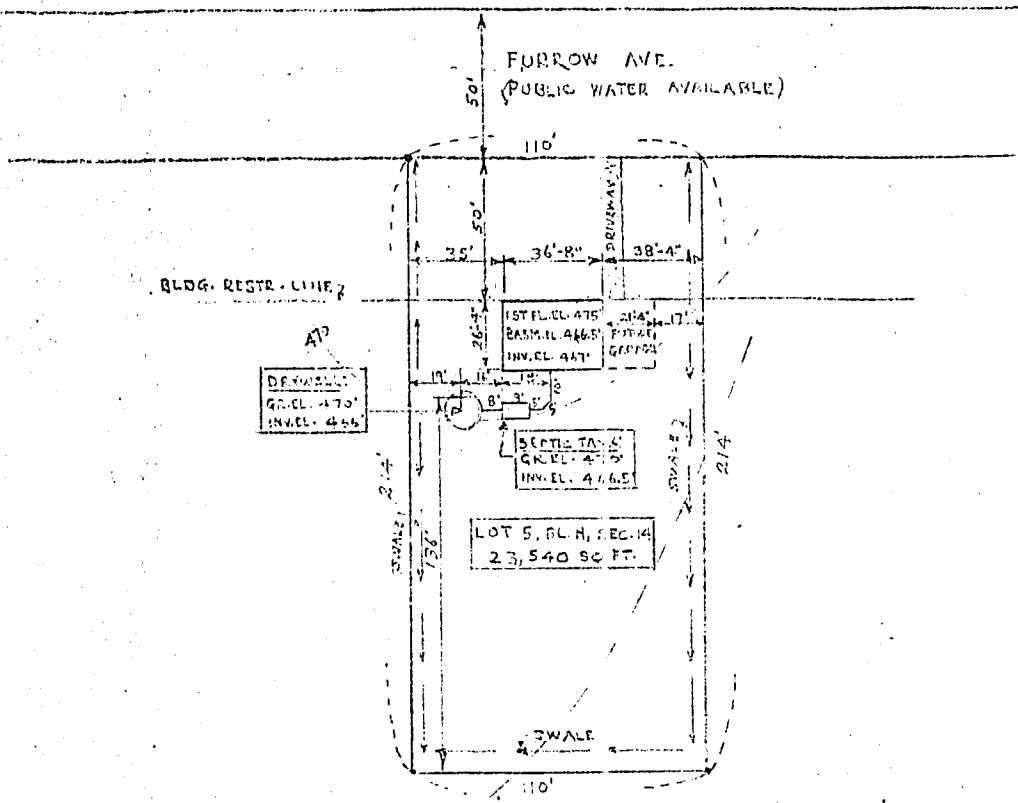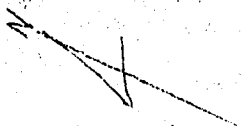

465 "MT. HEBRON"

PREPARED BY: C. N. BURGESS - 465-9044 OR  
 CALL H. J. BAKER - 465-2884  
 THORNBROOK CORP.  
 2106 MT. HEBRON RD.  
 ELLICOTT CITY, MD.

Approved  
11/20/74

R.T.