

APPLICATION

PERCOLATION TESTING

HOWARD COUNTY HEALTH DEPARTMENT
BUREAU OF ENVIRONMENTAL HEALTH
P.O. BOX 476 ELLICOTT CITY, MARYLAND 21043
TELEPHONE: 461-9933

A 40235

P _____

DISTRICT 5TH

DATE 10/15

TO: THE COUNTY HEALTH OFFICER
ELLICOTT CITY, MARYLAND

I, HEREBY, APPLY FOR THE NECESSARY TEST IN ORDER TO CONSTRUCT (OR RECONSTRUCT) A SEWAGE DISPOSAL SYSTEM.

PROPERTY OWNER Smith Roberts + Assoc

ADDRESS 8307 Main St Ellicott City PHONE 465-5855

PROSPECTIVE BUYER N/A

ADDRESS _____ PHONE _____

PROPERTY LOCATION:

SUBDIVISION Talbott Property Sec I LOT NO. 37 *Preliminary 10/23/87*
REVISED

ROAD AND DESCRIPTION Ten Oaks Rd *FINAL*

TAX MAP 28 PARCEL # 46 B

SIZE OF LOT 3 acres TYPE BLDG. SFD
(SINGLE FAMILY DWELLING OR COMMERCIAL)

THE SYSTEM INSTALLED UNDER THIS APPLICATION IS ACCEPTABLE ONLY UNTIL PUBLIC FACILITIES BECOME AVAILABLE. I FULLY UNDERSTAND THE

FEE CONNECTED WITH THE FILING OF THIS PERC TEST APPLICATION IS NON-REFUNDABLE UNDER ANY CIRCUMSTANCES. I ALSO AGREE TO COMPLY

WITH ALL M.O.S.H.A. REQUIREMENTS IN TESTING THIS LOT. M. J. Reid
(SIGNATURE OF APPLICANT)

APPROVED BY Jane E. Madson FOR Deep trenches DATE 8-18-88


REJECTED BY _____ FOR _____ DATE _____

HOLD PENDING FURTHER TESTS _____ DATE _____

REASONS FOR REJECTION OR HOLDING 10/21/87 Perc OK Hold for Per A/H

THIS IS NOT A PERMIT

103

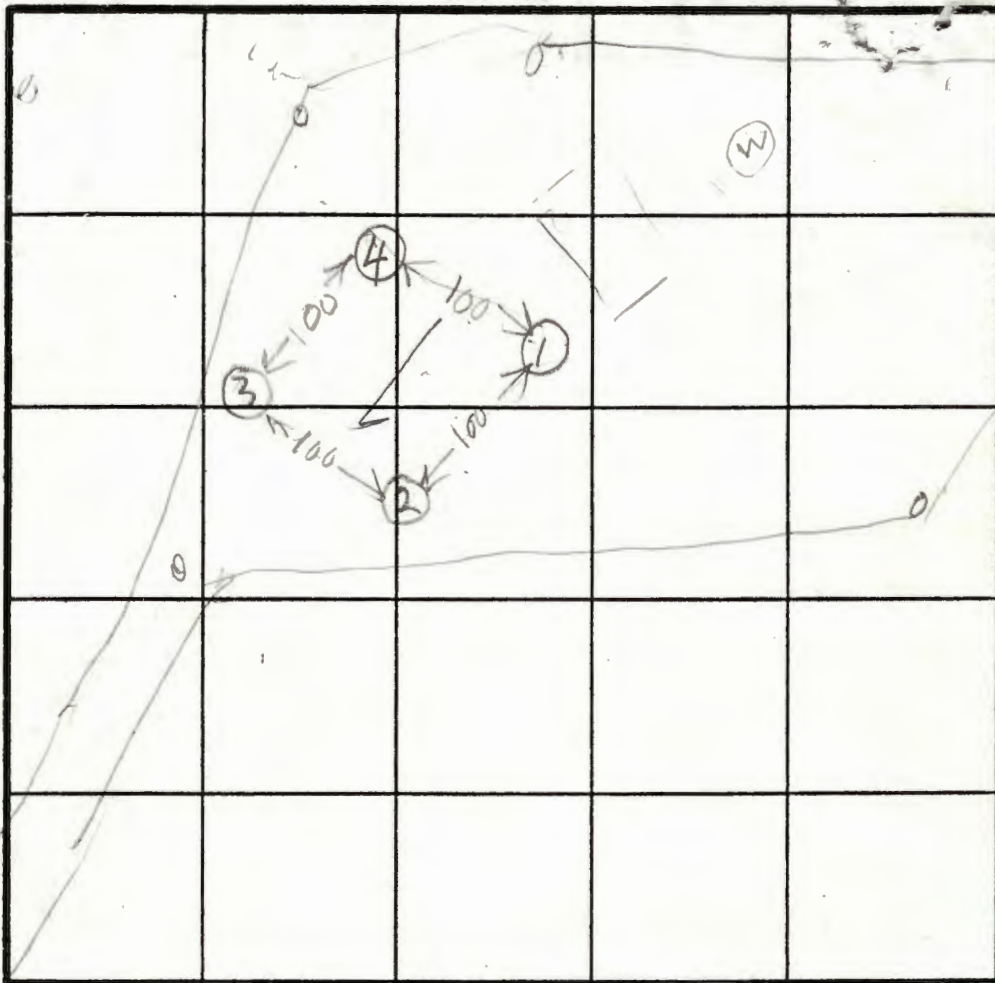

SOIL PROFILE

0
BROWN
CLAY
3
PINIL
BROWN
SAND
MICA
LOAM
12

0
DARK
BROWN CLAY
3
GRAY
BROWN
MICA
LOAM

0
BROWN
CLAY
3
GRAY
BROWN
SAND
MICA
LOAM

0
PINIL
GRAY
BROWN
SAND
MICA
LOAM
2

Hole Elevations

①④ = High

②③ = Low

X PERC

9min

INLET 3.5'

BOTTOM 8.0'

180 #/BR

INDICATE NORTH - NAME ADJOINING ROADWAY AS BASE LINE

DATE	TEST NO.	DEPTH	PRE-WET		TEST - 1" DROP		TIME
			START	STOP	START	STOP	
10/8/87	IV	12	OK				
10/8/87	2S	4	304	311	311	331	20
	2V	13	OK				
	3S	3.5	308	316	316	323	7
	3V	12	OK				
	4S	4	325	327	327	332	4
	4D	8	325	327	327	332	4
10/8/87	4V	12.5	OK				

REMARKS

Holer dug per Surveyor Plat

TYPE OF SOIL

TESTED BY

RITANCCI

ALSO PRESENT

MARK DAVE POY
OLEN

EH-12-1079