

ATLANTIC BLUE WATER SERVICES

1808 Baltimore Boulevard, Westminster, MD 21157 – (410)840-2583

Reference: Tracey Vickers

Location: 5617 Trotter Road
Clarksville, MD. 21029

Date Reported: 11/29/2022

Date Collected: 11/25/2022

Source: Well

Site: Hose

Collected By: K. KLUETZ

Treatment: Not Listed

Field pH: 5.5

Field Chlorine:

PARAMETERS	RESULTS	UNITS	MCL/SMCL	PASS/FAIL	METHOD
Total Coliform Bacteria	Absent	CFU	Present	Pass	Colitag
E. Coli Bacteria	Absent	CFU	Present	Pass	Colitag
Nitrates	2.0	mg/L	10	Pass	8171
Lead	<0.002	mg/L	0.015	Pass	200.8

*They are certified by state, missing
lab credentials on this format sheet.
gb*


NOTES:

- 1 mg/L = milligrams per liter (equivalent to parts per million (ppm))
- 2 MPN/ 100 ml = Most Probable Number [of viable bacteria] per 100 ml of sample.
- 3 MCL = Maximum Contaminant Level; SMCL = Secondary Maximum Contaminant Level
- 4 **Results less than or within the MCL/SMCL range are considered satisfactory and within potable limits at the time of sampling.
- 5 ND = None Detected; NT = Not Tested
- 6 Sample collected by a certified sampler, analyzed as received

SITE INSPECTION SHEET

OWNER: Tracy Vickers PHONE #: _____
ADDRESS: 5617 Trotter Rd CONTRACTOR: _____
Clarksville WELL TAG #: None
SUBDIVISION: Forest Hills LOT: 12 COUNTY #: Howard
PROPOSAL: Powder room and interior renovations

LOCATION DIAGRAM

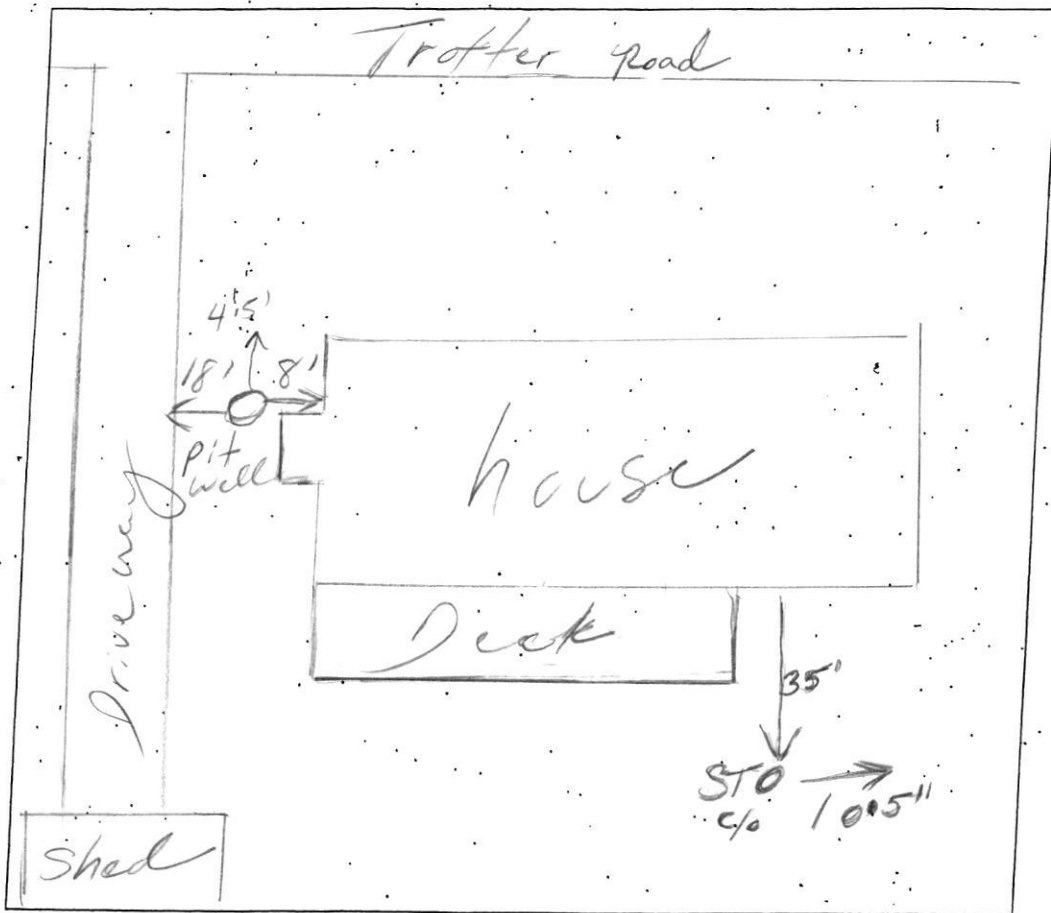

COMMENTS: Front yard ground disturbance. Dense
vegetative growth in backyard. Ephemeral channel
formation near septic drainfield. Septic tank
chamber cracked needs repaired.

DATE: 3/10/23 INSPECTOR: Mike Eschberg