

Record Detail * (This section is required.)

Permit Type	Permit Number	Opened Date
Building/Residential/Misc/Deck	B23001422	04/25/2023
Description of Work		
SFD/ CONSTRUCT AN IRREGULAR SHAPED 26' X 24'8" OPEN DECK WITH CASCADING BOX STEPS TO GRADE ON REAR OF HOUSE. CONSTRUCT A 5' X 5' LANDING WITH STEPS TO GRADE ON SIDE OF HOUSE.		
check spelling		

Address * (This section is required.)

Search Reset Clear Get Parcel & Owner

Street #	Street Name	Street Type
14770	MCCANN FARM	RD
Unit Type	Unit #	X Coordinate
--Select--		-77.02663
		Y Coordinate
		39.33497
City	State	Zip Code
WOODBINE	MD	21797
	Primary	
	Yes	

Parcel * (This section is required.)

Search Reset Clear Get Address & Owner

GIS ID *	Parcel	Parcel Area	Land Value	Improved Value	Exemption Value	Plan Area
11061525	27	0	0	0	0	RURAL
Legal Description						
check spelling						

Block	Lot	Census Tract	Council Dist	Inspection Dist	Supervisor Dist	Map #	DAP Zone
10	1	604001	5				
Plan Area	State Tax Id	Subdivision Name					
		McCann Estates - West					
Section	Area	Tax Map					
		8					
Grid	Zoning District	ADC Map					
8-10	RC-DEO	4692-F7					
SDP No.	Final Plan No.	WP File No.					
	ECP-19-045						
Record Plat No.	WS Contract No.	FDP No.	Primary				
25930			Yes				
Owner Occupied	Year Built	Historic District					
<input type="radio"/> Yes <input type="radio"/> No		<input checked="" type="radio"/> Yes <input type="radio"/> No					
Historic District Registry No.	Stat Area	Flood Plain					
	4-02	<input type="radio"/> Yes <input checked="" type="radio"/> No					
Building No							

Owner * (This section is required.)

Search Reset Clear

Name
PAYNE CRISTY LYNN

Address Line 1
14770 MCCANN FARM RD

Address Line 2

Address Line 3

Mail City WOODBINE	Mail State MD	Mail Zip Code 21797
Phone 410-969-4444	Primary Yes	
E-mail PERMITS@FENCEDECKCONNECT.COM		
Cell Number	Fax Number	

Professionals (This section is not required.)

License # 08050045780	Business Name FENCE & DECK CONNECTION		
License Type MHIC Co	First Name JAMES	Middle Name W	Last Name RUBUSH
Primary Yes	Address Line 1 8057 VETERANS HIGHWAY		
	Address Line 2		
	City MILLERSVILLE	State MD	ZIP Code 21108
	Phone 1 4109694444	Phone 2	Fax 4109694448
	E-mail DFISH@FENCEDECKCONNECT.COM		

Applicant (This section is not required.)

Search As Owner As Lic. Prof As Contact

Type Applicant	First Name JESSICA	MI	Last Name OWENBY
Relationship Applicant	Full Name JOSH SIMPSON		
Primary Yes	Organization Name FENCE & DECK CONNECTION		
	Street Address 8057 VETERANS HIGHWAY		
	Address Line 2		
	City MILLERSVILLE	State MD	Zip Code 21108
	Phone 410-969-4444	Cell	Fax
	E-mail permits@fencedeckconnect.com		

Addtl Info


Est Construction Cost 31400	Housing Units 0	Number of Buildings 0	Public Owned No
Construction Type --Select--			

MISC PERMIT INFO

MISCELLANEOUS PERMIT INFORMATION

Capital Project-No Fee <input type="radio"/> Yes <input checked="" type="radio"/> No	Capital Project Number <input type="text"/>	Fee Exempt <input type="radio"/> Yes <input checked="" type="radio"/> No	Roadside Tree Project Permit <input type="radio"/> Yes <input checked="" type="radio"/> No	Roadside Tree Project Permit # <input type="text"/>
Existing Use SFD	Water Private	Sewage Private	Expiration Date 10/23/2023	<input type="text"/>

Submit Cancel



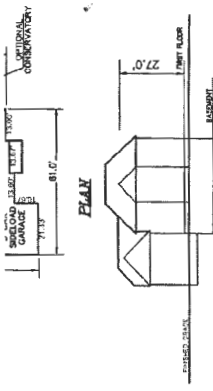


OPERATION AND MAINTENANCE SCHEDULE FOR DRY WELLS (M-5)


THE OWNER SHALL INSPECT THE HOLDING TANKS AND STRUCTURES ON A QUARTERLY BASIS AND WRITE HEAVY STONE TANKS. THE OWNER SHALL RECORD THE WATER LEVELS AND EXCESSIVE BACK-UP IN THE MONITORING WELLS OVER A PERIOD OF SEVERAL DAYS TO DETERMINE PROGRESSIVE PROBLEMS. WHEN A LOW BODY TO DETERMINE THE RATE AT WHICH THE WELLS ARE FILLING. WHEN THE FACILITY BECOMES CLOGGED SO THAT IT DOES NOT DRAIN DOWN WITHIN A 72-HOUR TIME PERIOD, CORRECTIVE ACTION SHALL BE TAKEN. THE MAINTENANCE LOG BOOK SHALL BE AVAILABLE TO ANY MEMBER OF THE COUNTY FOR INSPECTION. THE MAINTENANCE LOG BOOK SHALL BE MAINTAINED AT THE FACILITY. THE MAINTENANCE LOG BOOK SHALL BE MAINTAINED AT THE FACILITY. THE MAINTENANCE LOG BOOK SHALL BE MAINTAINED AT THE FACILITY.

MICRO-BIODEGRADATION SCHEDULE

FACILITY	TYPE	AREA (SQ. FT.)	NO. OF	NO. OF	NO. OF	NO. OF	NO. OF
M-5	1	84,000	42,000	21,000	10,500	5,250	2,625

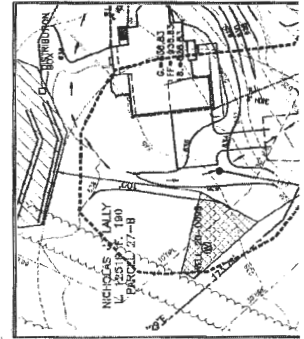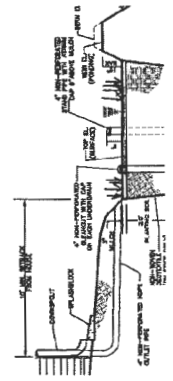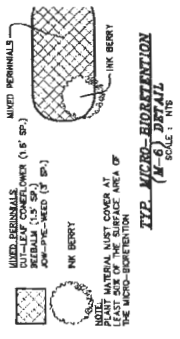

AREA OF SEPTIC EXHAUST DRY-WELL (M-5)

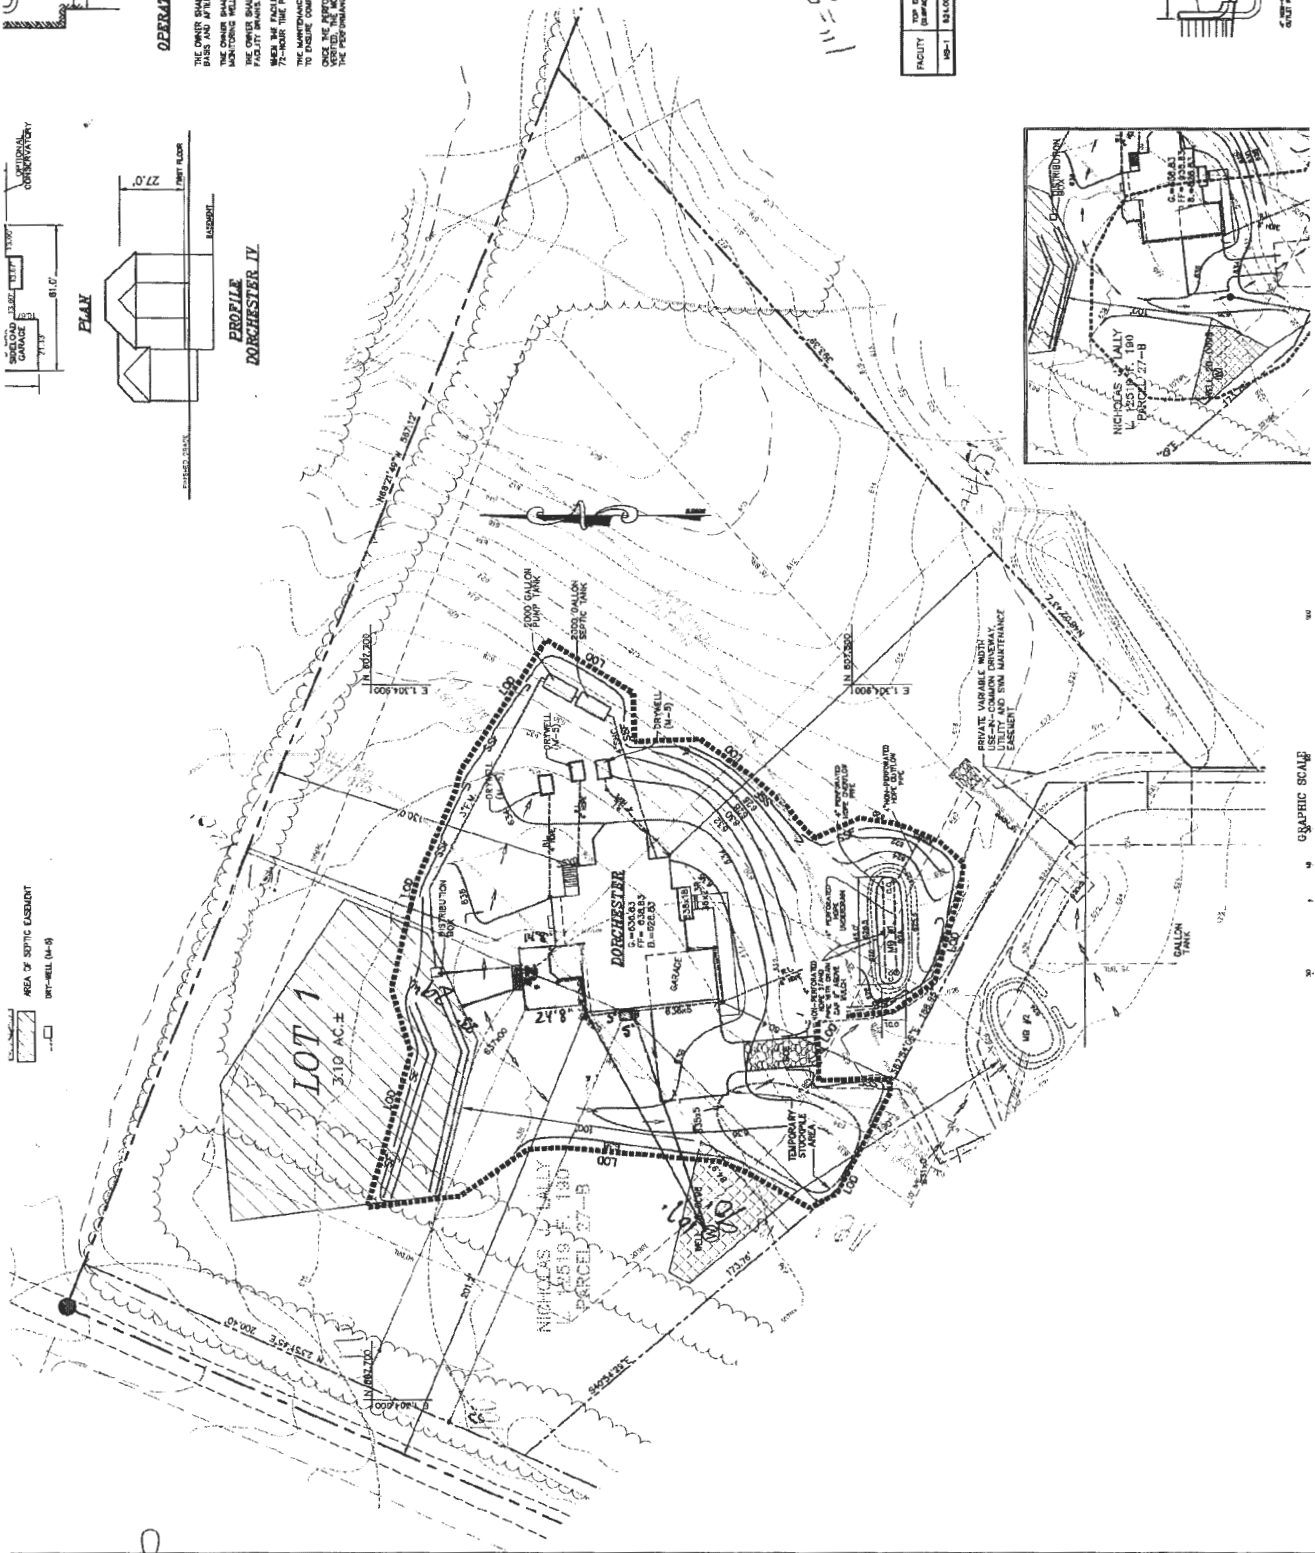

GRAPHIC SCALE

Boyer

11=50