

# APPLICATION

PERCOLATION TESTING

A 36445

P \_\_\_\_\_

DISTRICT 4<sup>TH</sup>

DATE 1/22/86

HOWARD COUNTY HEALTH DEPARTMENT  
BUREAU OF ENVIRONMENTAL HEALTH  
P.O. BOX 476 ELLICOTT CITY, MARYLAND 21043  
TELEPHONE: 461-9933

TO: THE COUNTY HEALTH OFFICER  
ELLICOTT CITY, MARYLAND

I, HEREBY, APPLY FOR THE NECESSARY TEST IN ORDER TO CONSTRUCT (OR RECONSTRUCT) A SEWAGE DISPOSAL SYSTEM.

PROPERTY OWNER ELIZA HOBBS

ADDRESS 2650 HOBBS, RD. PHONE 926 8520

PROSPECTIVE BUYER CHARLES A. HOBBS IV

ADDRESS 2555 M<sup>R</sup> KENDREE RD. PHONE 442-5510

PROPERTY LOCATION:

SUBDIVISION \_\_\_\_\_ LOT NO. 1

ROAD AND DESCRIPTION 2650 HOBBS RD.

TAX MAP \_\_\_\_\_ PARCEL # \_\_\_\_\_

SIZE OF LOT 1 ACRE TYPE BLDG. SINGLE  
(SINGLE FAMILY DWELLING OR COMMERCIAL)

THE SYSTEM INSTALLED UNDER THIS APPLICATION IS ACCEPTABLE ONLY UNTIL PUBLIC FACILITIES BECOME AVAILABLE. I FULLY UNDERSTAND THE FEE CONNECTED WITH THE FILING OF THIS PERC TEST APPLICATION IS NON-REFUNDABLE UNDER ANY CIRCUMSTANCES. I ALSO AGREE TO COMPLY WITH ALL M.O.S.H.A. REQUIREMENTS IN TESTING THIS LOT. Charles A. Hobbs IV  
(SIGNATURE OF APPLICANT)

APPROVED BY \_\_\_\_\_ FOR \_\_\_\_\_ DATE \_\_\_\_\_

REJECTED BY \_\_\_\_\_ FOR \_\_\_\_\_ DATE \_\_\_\_\_

HOLD PENDING FURTHER TESTS \_\_\_\_\_ DATE \_\_\_\_\_

REASONS FOR REJECTION OR HOLDING 2-6-86 Perc Satisfactory For Shallow System only; Hold For certified hole location, house + well site S. Age


# THIS IS NOT A PERMIT

2/6/86  
1:30pm

①  
SOIL PROFILE

0'	AP
1'	RED YELLOW SAND SILT CLAY 110% FRAGMENTS
2'	Yellow BR SAND LOAM 10-20% COARSE FRAGMENTS
10'	Yellow BR SAND LM, 50% COARSE FRAGMENTS HARD BOTTOM
11'	

0'	④ AP
1'	Yellow BR. CLAY SILT LM. 10% FRAGMENTS
2'	Yellow BR. SAND LM. 10% FRAGMENTS
11'	Yellow BR. SAND LM. 20-30% COARSE FRAGMENTS
12'	ROCK AT 12'

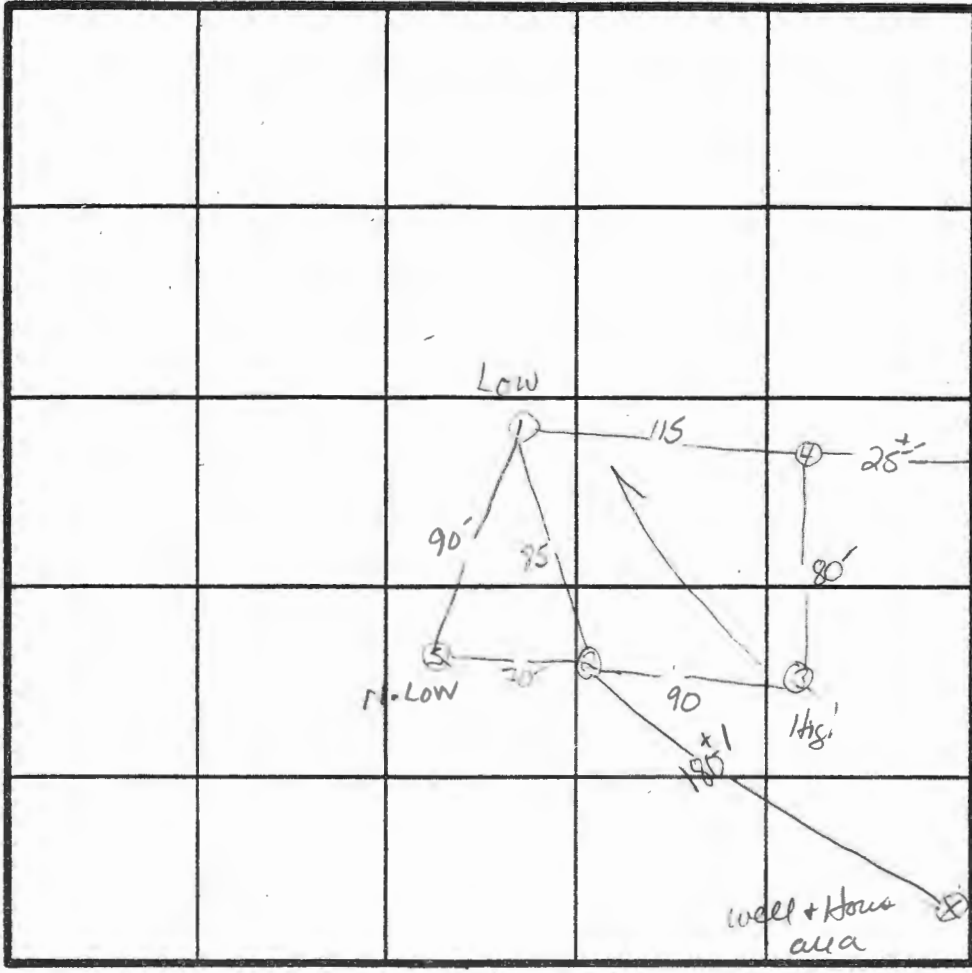

INDICATE NORTH - NAME ADJOINING ROADWAY AS BASE LINE.  
HOBBS Rd.

0'	② AP
1'	RED yellow SILT CLAY LM. 110% FRAGMENTS
2'	Yellow BR SAND SILT LM. 10-20% COARSE FRAGMENT
11'	COARSE FRAGMENTS 30-40%
12'	

0'	③ AP
1'	Yellow BR SAND CL LM. 110% FRAGMENTS
2'	BR. Yellow SAND LOAM 110% FRAGMENTS
12'	

DATE	TEST NO.	DEPTH	PRE-WET		TEST - 1" DROP		TIME	X Perc Smin INLET 3" Bottom 4.5' 158 #/BR
			START	STOP	START	STOP		
2/6/86	1 S	2'	11:22	11:24	11:24	11:28	4min	
	1 M	6'	11:21	11:25	11:25	11:30	5min	
	1 V	11'	ROCK BOTTOM AT 11'		See Profile			
	2 S	2'	11:30	11:35	11:35	11:40	5min	
	2 M	6'	11:30	11:34	11:34	11:41	7min	
	2 V	12'	ROCK BOTTOM 12'		See Profile			
	3 S	2'	11:42	11:46	11:46	11:52	6min	
	3 M	6'	11:42	11:44	11:44	11:47	3min	
	3 V	12'	see Profile					
	4 S	2'	11:55	11:58	11:58	12:03	5min	
	4 M	6'	11:54	11:56	11:56	11:59	3min	
	4 V	12'	ROCK BOTTOM		see profile			
	5 V							

REMARKS SHALLOW SYSTEM ONLY

TYPE OF SOIL Glennq | MANOR

TESTED BY S. Abel KEN ALLEN, MR. HOBBS

ALSO PRESENT

EH-12-1079

# APPLICATION

PERCOLATION TESTING

HOWARD COUNTY HEALTH DEPARTMENT  
BUREAU OF ENVIRONMENTAL HEALTH  
P.O. BOX 476 ELLICOTT CITY, MARYLAND 21043  
TELEPHONE: 461-9933

A 36445

P \_\_\_\_\_

DISTRICT 4TH

DATE 1/22/86

TO: THE COUNTY HEALTH OFFICER  
ELLICOTT CITY, MARYLAND

I, HEREBY, APPLY FOR THE NECESSARY TEST IN ORDER TO CONSTRUCT (OR RECONSTRUCT) A SEWAGE DISPOSAL SYSTEM.

PROPERTY OWNER ELIZA HOBBS

ADDRESS 2650 HOBBS, RD. PHONE 926 8520

PROSPECTIVE BUYER CHARLES A. HOBBS, IV

ADDRESS 2555 MC KENDREE RD. PHONE 442-5510

PROPERTY LOCATION:

SUBDIVISION \_\_\_\_\_ LOT NO. 1

ROAD AND DESCRIPTION 2650 HOBBS, RD.

TAX MAP \_\_\_\_\_ PARCEL # \_\_\_\_\_

SIZE OF LOT 1 ACRE TYPE BLDG. SINGLE  
(SINGLE FAMILY DWELLING OR COMMERCIAL)

THE SYSTEM INSTALLED UNDER THIS APPLICATION IS ACCEPTABLE ONLY UNTIL PUBLIC FACILITIES BECOME AVAILABLE. I FULLY UNDERSTAND THE FEE CONNECTED WITH THE FILING OF THIS PERC TEST APPLICATION IS NON-REFUNDABLE UNDER ANY CIRCUMSTANCES. I ALSO AGREE TO COMPLY WITH ALL M.O.S.H.A. REQUIREMENTS IN TESTING THIS LOT. Charles A. Hobbs, IV  
(SIGNATURE OF APPLICANT)

APPROVED BY \_\_\_\_\_ FOR \_\_\_\_\_ DATE \_\_\_\_\_


REJECTED BY \_\_\_\_\_ FOR \_\_\_\_\_ DATE \_\_\_\_\_

HOLD PENDING FURTHER TESTS \_\_\_\_\_ DATE \_\_\_\_\_

REASONS FOR REJECTION OR HOLDING \_\_\_\_\_

# THIS IS NOT A PERMIT



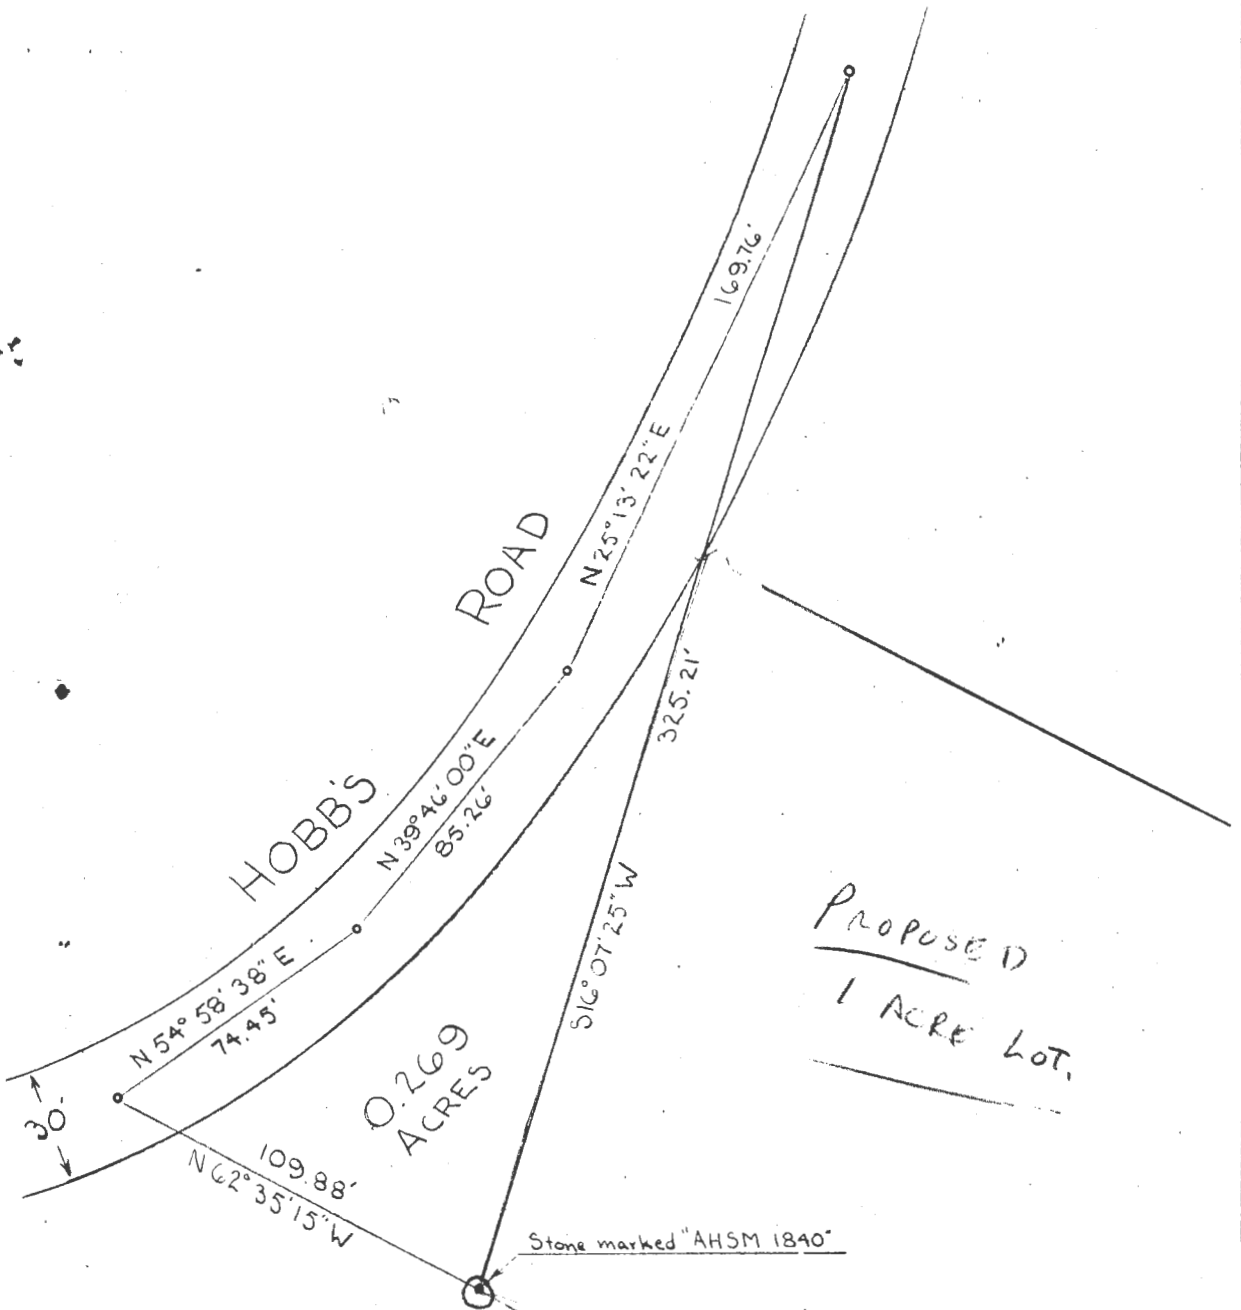

*Charles M. Stearns*

February 10, 1986

Mrs. Eliza Hobbs  
2650 Hobbs Road  
Glenwood, Maryland 21738

RE: Percolation Testing  
Tax Map 14, Parcel 55  
Lot 1

Dear Mrs. Hobbs:

Percolation testing conducted February 6, 1986 on the above referenced lot indicated satisfactory soil conditions.

Approval of the lot is contingent upon submission by a registered engineer of a plat showing certified test hole locations and a suitable house and well site.

This should be submitted within sixty (60) days to allow field verification if necessary.

If you have any questions regarding this matter, please feel free to contact me at the above address or by calling 461-9933.

Very truly yours,

Craig Williams, Director  
Water and Sewerage Program

CW:JR