

APPLICATION

SEWAGE DISPOSAL TESTING

MARYLAND STATE DEPARTMENT OF HEALTH

HOWARD COUNTY

ELLICOTT CITY

DISTRICT 3

DATE 7-26-63

TO: THE COUNTY HEALTH OFFICER
ELLICOTT CITY, MARYLAND

I, HEREBY, APPLY FOR THE NECESSARY TESTS IN ORDER TO CONSTRUCT (OR RECONSTRUCT) A SEWAGE DISPOSAL SYSTEM.

PROPERTY OWNER

Robert Haynes

ADDRESS

337 Melvin Ave. - Apt A - Catonsville 28 / Ri 7-6589

PROPERTY LOCATION:

SUBDIVISION

LOT NO.

ROAD AND DESCRIPTION

Trindolph Rd - 100 yds west of Rose Mary Lane on right

OCCUPANT

PHONE

PERSON TO CONSTRUCT SYSTEM

ADDRESS

PHONE

SIZE OF LOT

1 acre

TYPE BLDG.

NUMBER OF BEDROOMS

3

IF NOT SINGLE RESIDENCE DESCRIBE

SIGNATURE OF APPLICANT

Robert M. Haynes

APPROVED BY

FOR

(KIND OF SYSTEM)

DATE

REJECTED BY

FOR

(KIND OF SYSTEM)

DATE


HOLD PENDING FURTHER TESTS

DATE

REASONS FOR REJECTION OR HOLDING

7-26-63 5th floor below drainage pt.

THIS IS NOT A PERMIT

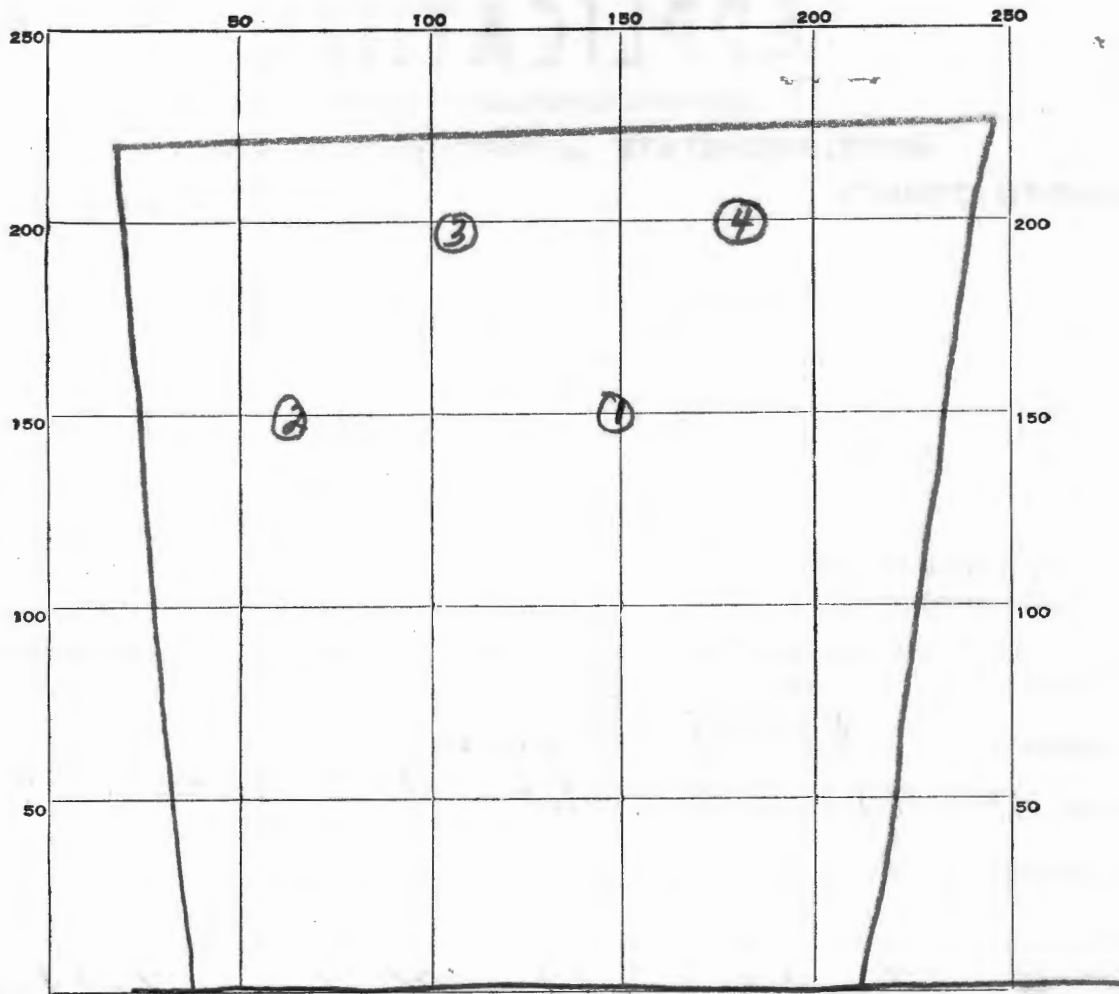

INDICATE NORTH. - NAME ADJOINING ROADWAY AS BASE LINE.

TRIDELPHIA ROAD

DATE	TEST NO.	DEPTH	PRE-WET		TEST - 1" DROP		TIME
			START	STOP	START	STOP	
7-31-63	1	3 FT	9:48	10:12	10:12	overtime	
	2		9:53	10:13	10:13	10:52	39 min.
	3		9:56	10:22	10:22	overtime	
	4		9:58	10:03	10:03	10:16	13 min.

SOIL AUGER FINDING _____

TESTED BY *JH*

REMARKS _____

ALSO PRESENT *7-31-63 RA Haynes*

LOT NO. _____

7/31/63

9:30

APPLICATION

A 07202

P _____

SEWAGE DISPOSAL TESTING

MARYLAND STATE DEPARTMENT OF HEALTH

HOWARD COUNTY

ELLICOTT CITY

DISTRICT 3DATE 7-26-63TO: THE COUNTY HEALTH OFFICER
ELLICOTT CITY, MARYLAND

I, HEREBY, APPLY FOR THE NECESSARY TESTS IN ORDER TO CONSTRUCT (OR RECONSTRUCT) A SEWAGE DISPOSAL SYSTEM.

PROPERTY OWNER

Robert Haynes

ADDRESS

337 Melrose Ave - Apt A - Catonsville 28 / R: 7-6589

PROPERTY LOCATION:

SUBDIVISION

LOT NO.

ROAD AND DESCRIPTION

Trindolph Rd - 100 yds west of Rose Mary Lane on right

OCCUPANT

PHONE

PERSON TO CONSTRUCT SYSTEM

ADDRESS

PHONE

SIZE OF LOT

1 acre

TYPE BLDG.

NUMBER OF BEDROOMS 3

IF NOT SINGLE RESIDENCE DESCRIBE

SIGNATURE OF APPLICANT

Robert Haynes

APPROVED BY

FOR

DATE

(KIND OF SYSTEM)

REJECTED BY

FOR

DATE

(KIND OF SYSTEM)

 
HOLD PENDING FURTHER TESTS

DATE

REASONS FOR REJECTION OR HOLDING

7-31-63 5 holes holes didn't pass. J.H.

THIS IS NOT A PERMIT

[illegible]

TESTED BY

REMARKS

ALSO PRESENT

LOT NO.