

Repair permit
6/3/70
9:30

APPLICATION

SEWAGE DISPOSAL TESTING

MARYLAND STATE DEPARTMENT OF HEALTH

HOWARD COUNTY

ELLICOTT CITY

DISTRICT 6

DATE 5/12/70

TO: THE COUNTY HEALTH OFFICER
ELLICOTT CITY, MARYLAND

I, HEREBY, APPLY FOR THE NECESSARY TESTS IN ORDER TO CONSTRUCT (OR RECONSTRUCT) A SEWAGE DISPOSAL SYSTEM.

PROPERTY OWNER

Frank Hunt

ADDRESS

P.O. Box 401 - Savage, Md.

PHONE

725-4050

PROPERTY LOCATION:

SUBDIVISION

LOT NO.

ROAD AND DESCRIPTION

Vollenhausen Road -

1st house after crossing bridge - site near road

OCCUPANT

white with alum. siding

PHONE

PERSON TO CONSTRUCT SYSTEM

ADDRESS

PHONE

SIZE OF LOT

1 acre +

TYPE BLDG.

Existing house
37

NUMBER OF BEDROOMS

IF NOT SINGLE RESIDENCE DESCRIBE

SIGNATURE OF APPLICANT

Jean Hunt

APPROVED BY

FOR

DATE

REJECTED BY

Robert V. Ture

FOR

(KIND OF SYSTEM)

Dry system

(KIND OF SYSTEM)

DATE


6/3/70

HOLD PENDING FURTHER TESTS

DATE

REASONS FOR REJECTION OR HOLDING

THIS IS NOT A PERMIT

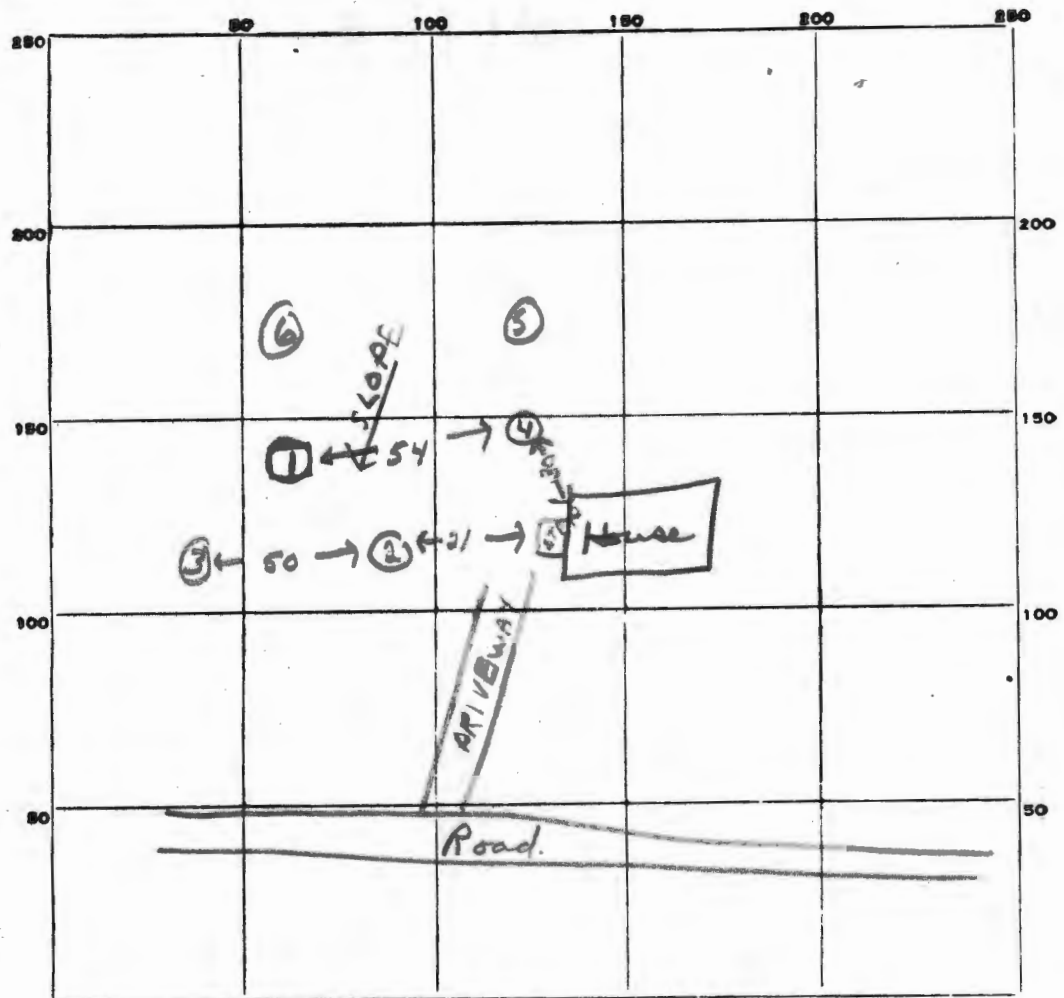

INDICATE NORTH. - NAME ADJOINING ROADWAY AS BASE LINE.

DATE	TEST NO.	DEPTH	PRE-WET		TEST - 1" DROP		TIME
			START	STOP	START	STOP	
6/3/70	1	3 ft.	Water	+ Clay			
	2	2 1/4 ft.	10 ¹⁵	10 ³⁵	1/2 inch		
	3	1 ft.	Water	- Owner said this water was from rain last year			
	4	4 ft.	Water	+ Clay			
	5	3 ft.	Clay	- To much grade to reach with			
	6	3 ft.	Clay	- " " " drain field			
			Discussed with Wane and Hodges.				
			Best to wait for public sewage				

SOIL AUGER FINDING

TESTED BY

R. Toner

REMARKS

To R.H. on 5-8-70

Bull
P.33

FILE Sewage DATE REPORTED 5/7/70
PROPERTY OWNER Frank Hunt
P. O. ADDRESS Collinsburg Rd. PO BOX 401 SAVAGE TELEPHONE
DIRECTIONS TO PROPERTY Savage Mt. Parcel # 639


INFORMANT _____
Public sources not available.

Mrs. James Whitley
Collinsburg Rd.
725-3411
CONDITION FOUND _____
2 homes & a trailer already on this property - moved another house on property - bldg. says cannot be occupied per Mrs. W. Says stretch from creek in back of this property terrible when hot.

5/8/70 - Visited Trailer - Vacant - Trailer has permit to be used for storage & workshop issued 4 April 70
ACTION TAKEN Foundation for house dug next to trailer & vacant
& House setting next to foundation. There is a long ditch dug beside foundation to drain off under ground water. Sewer line from trailer is connected to this ditch most likely
Visited Hunt No one home. Visited Bennet. Mrs Bennet Pents from Hunt
Large quantity of sewage found near driveway & near Bennet House See other side. Note left on door of Frank Hunt House
FINAL DISPOSITION _____

"ALL OVERFLOWING SEWAGE DISPOSAL SYSTEMS ON THE PROPERTY WILL BE REPAIRED AND
" Each building or trailer which has running water must have private sewage disposal system to dispose of the waste water "

SEWAGE

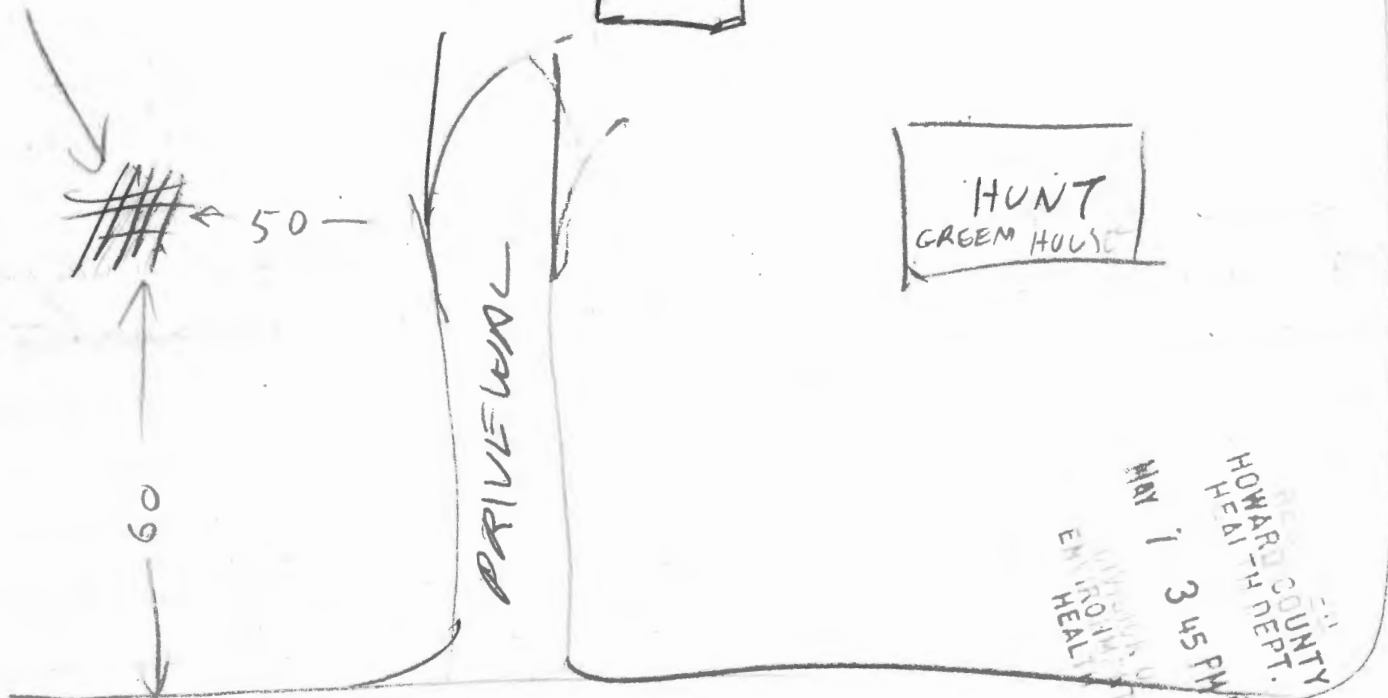

House 4 yrs

Pearl Kisonick
Vollmerhaugen Rd