



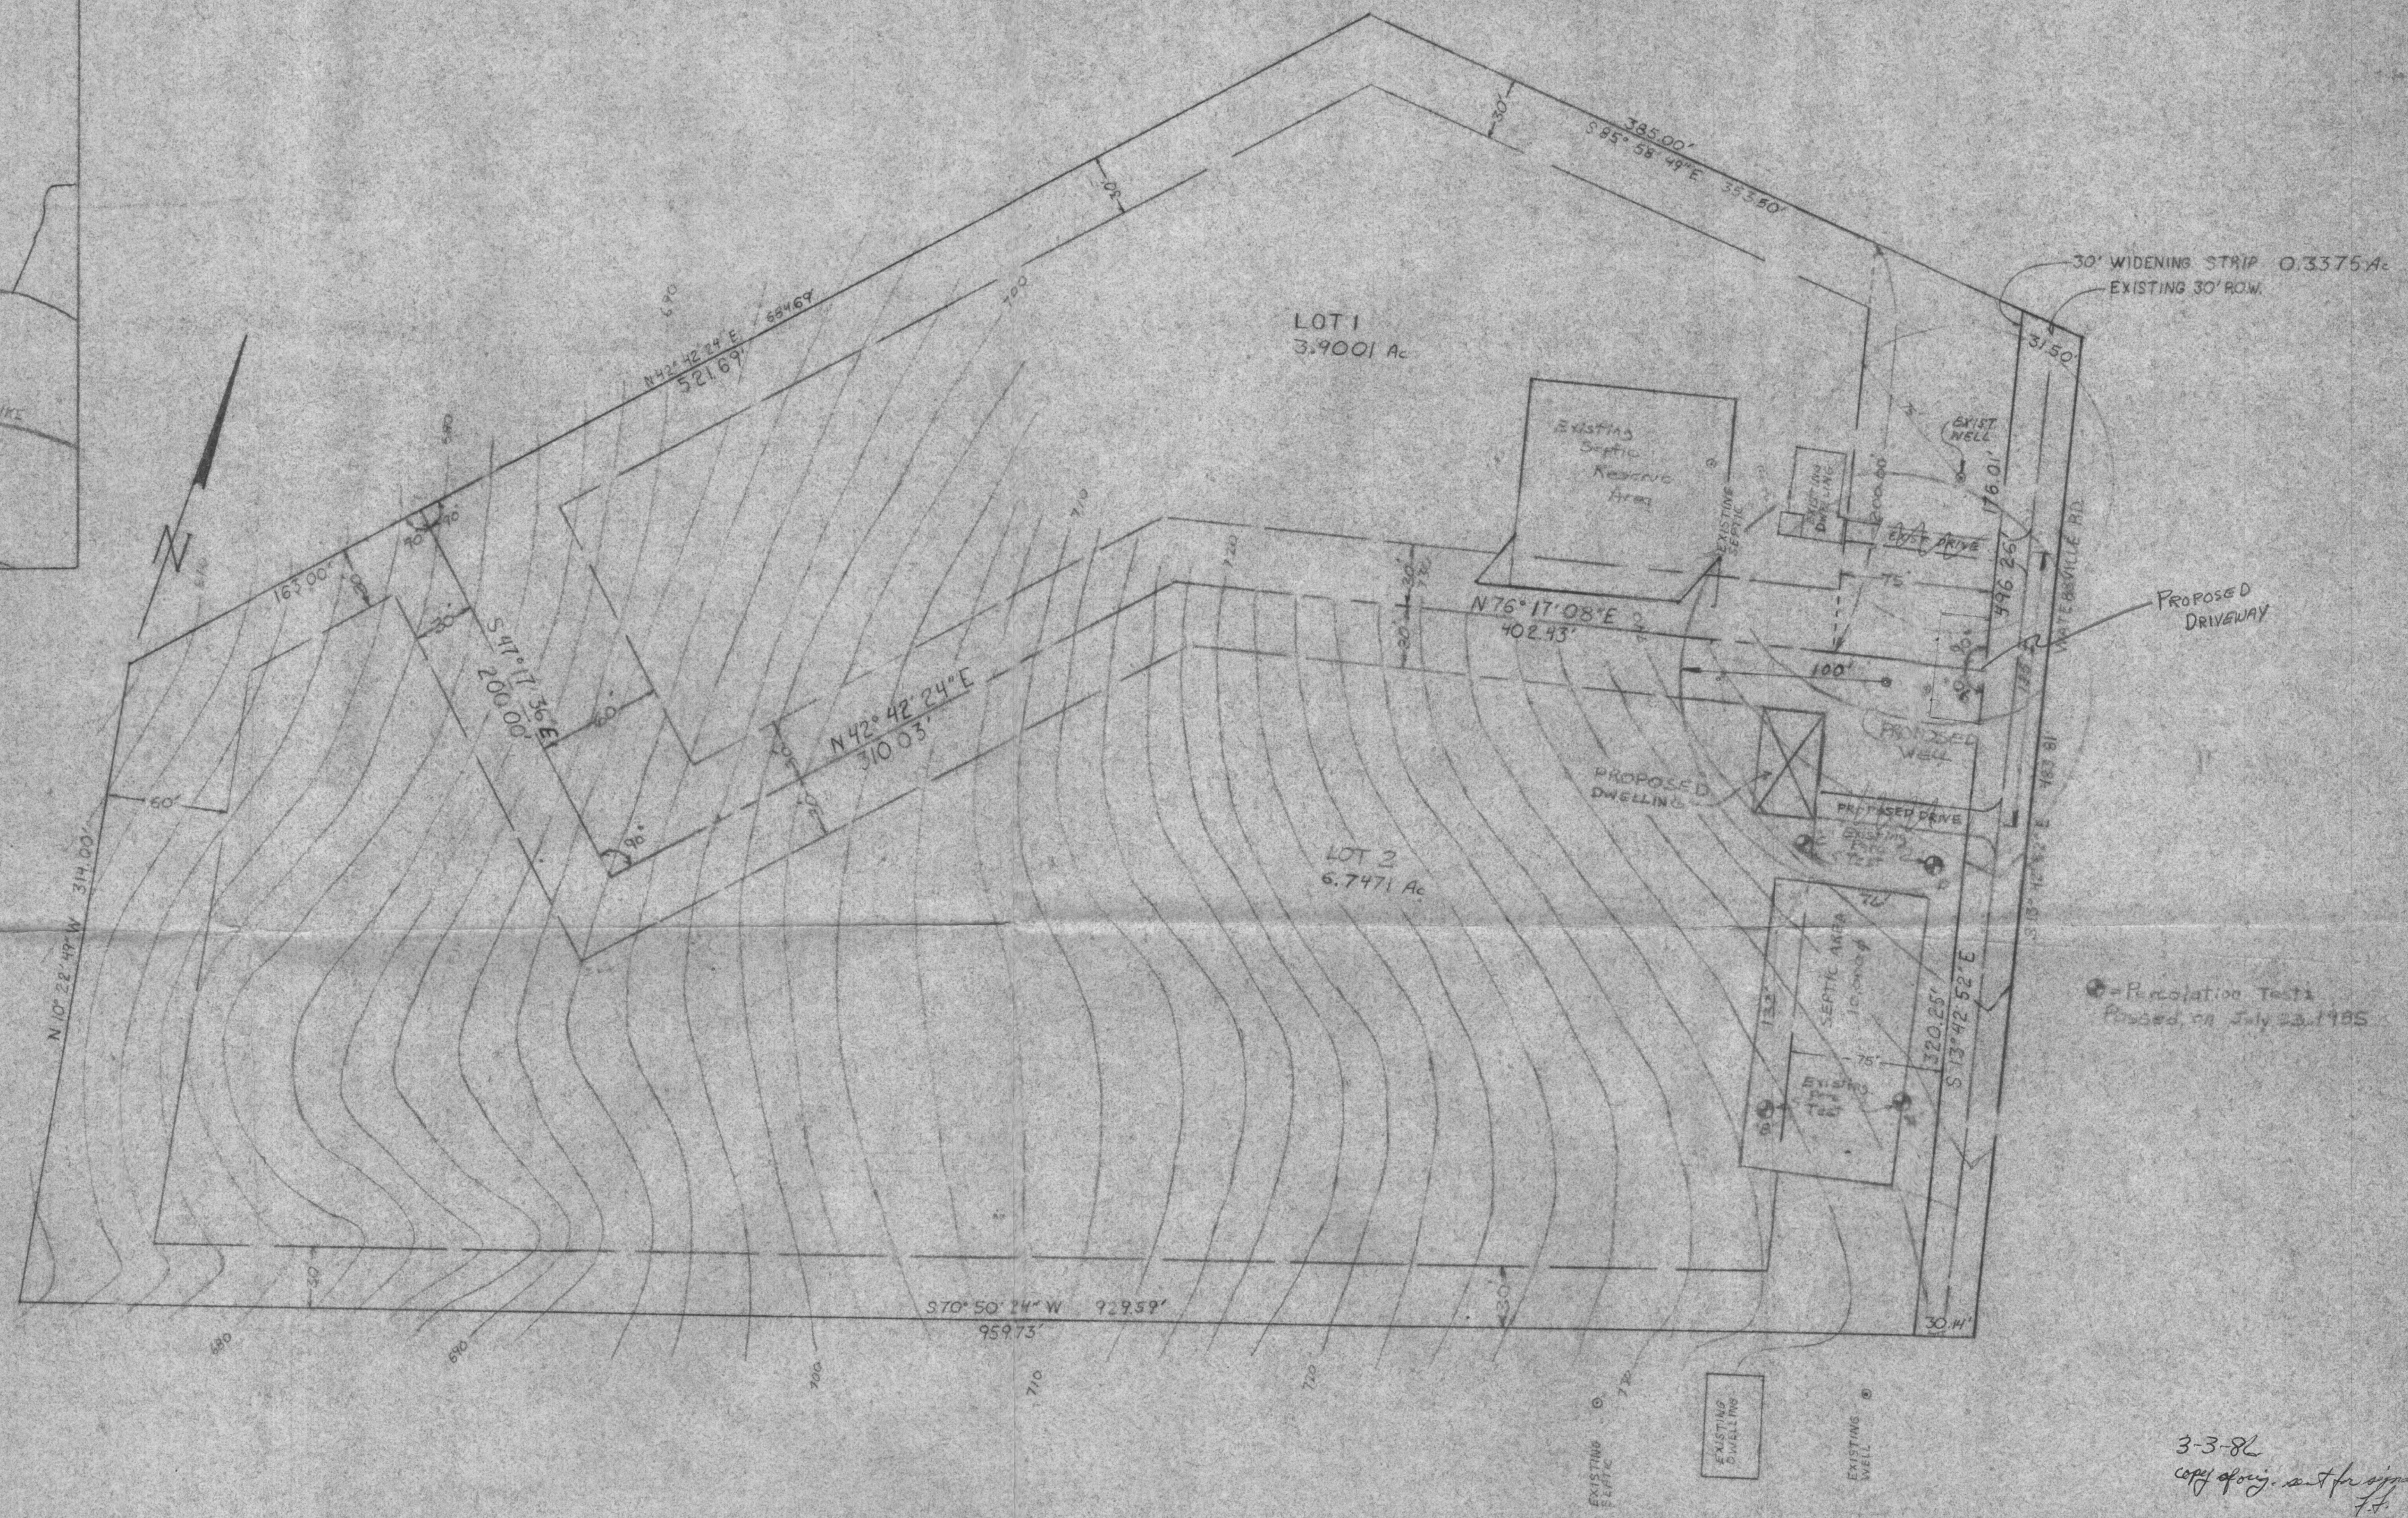


PLAT TO ACCOMPANY VARIANCE PETITION
NORANBROCK PROPERTY
WATERSVILLE ROAD
FOURTH ELECTION DISTRICT
HOWARD COUNTY, MARYLAND

Revised 8-5-85
 from 2-lots to 2-lots
 Revised 8-12-85
 Relocate Proposed Well
 Revised 8-14-85
 New Dimensions for
 Revised 2-28-86 CAP
 Move Well

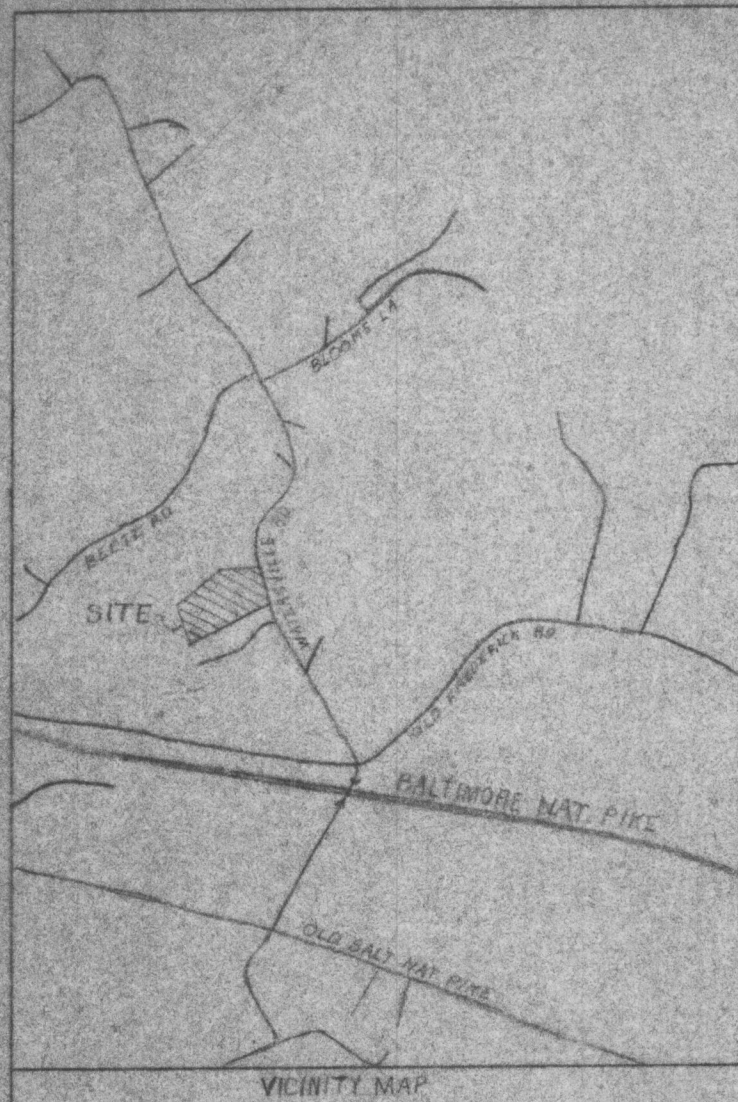


KIDDE CONSULTANTS, INC.
ENGINEERS, LAND PLANNERS & SURVEYORS
 8101 SANDY SPRING ROAD / LAUREL, MD. 20707
 (301) 725-0695 / 792-8098
D. Kaye Heller
 DATE 1-8-86 SCALE 1"=60'

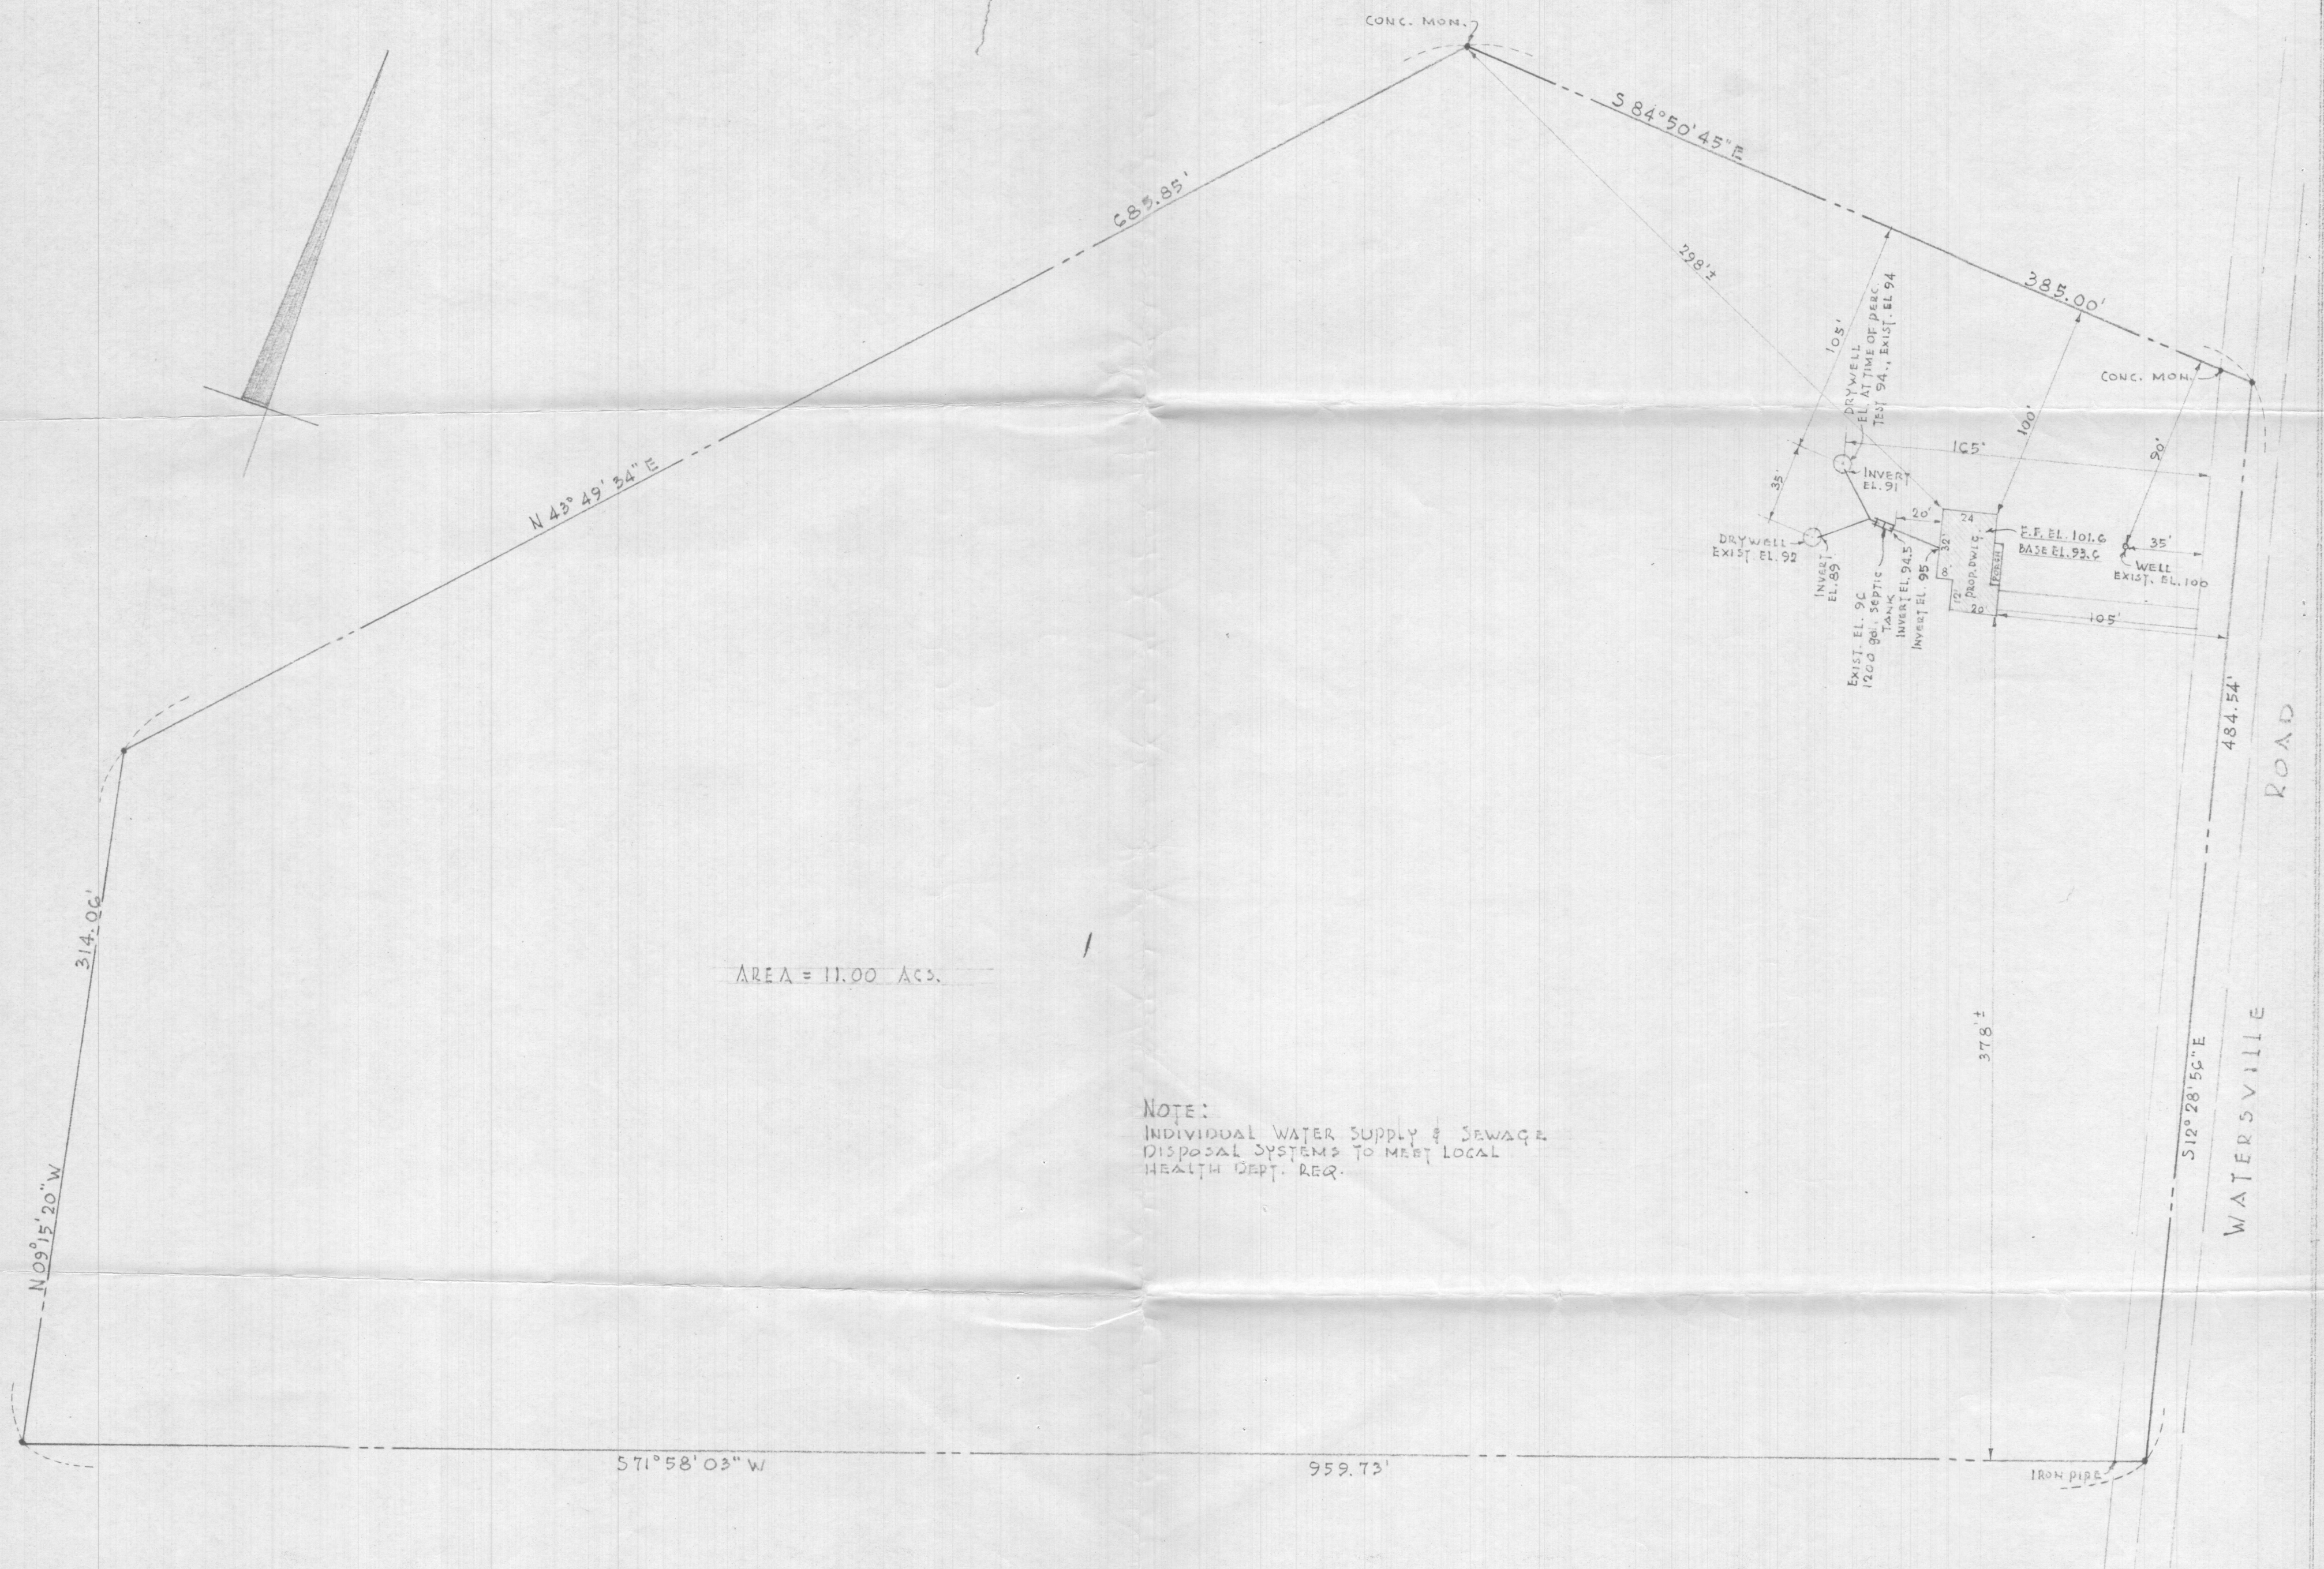

AREA = 11.00 ACs.

NOTE:
INDIVIDUAL WATER SUPPLY & SEWAGE
DISPOSAL SYSTEMS TO MEET LOCAL
HEALTH DEPT. REQ.


PLOT PLAN
1" = 50'

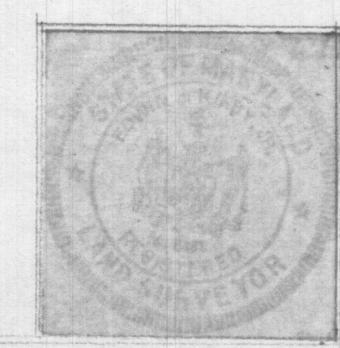

PROPERTY OF
MR. & MRS. CHARLES W. NORANBROCK
4TH ELECT. DIST., HOWARD COUNTY, MARYLAND

LIBER 547, FOLIO 14

2/6/73 1/8/73 9/4

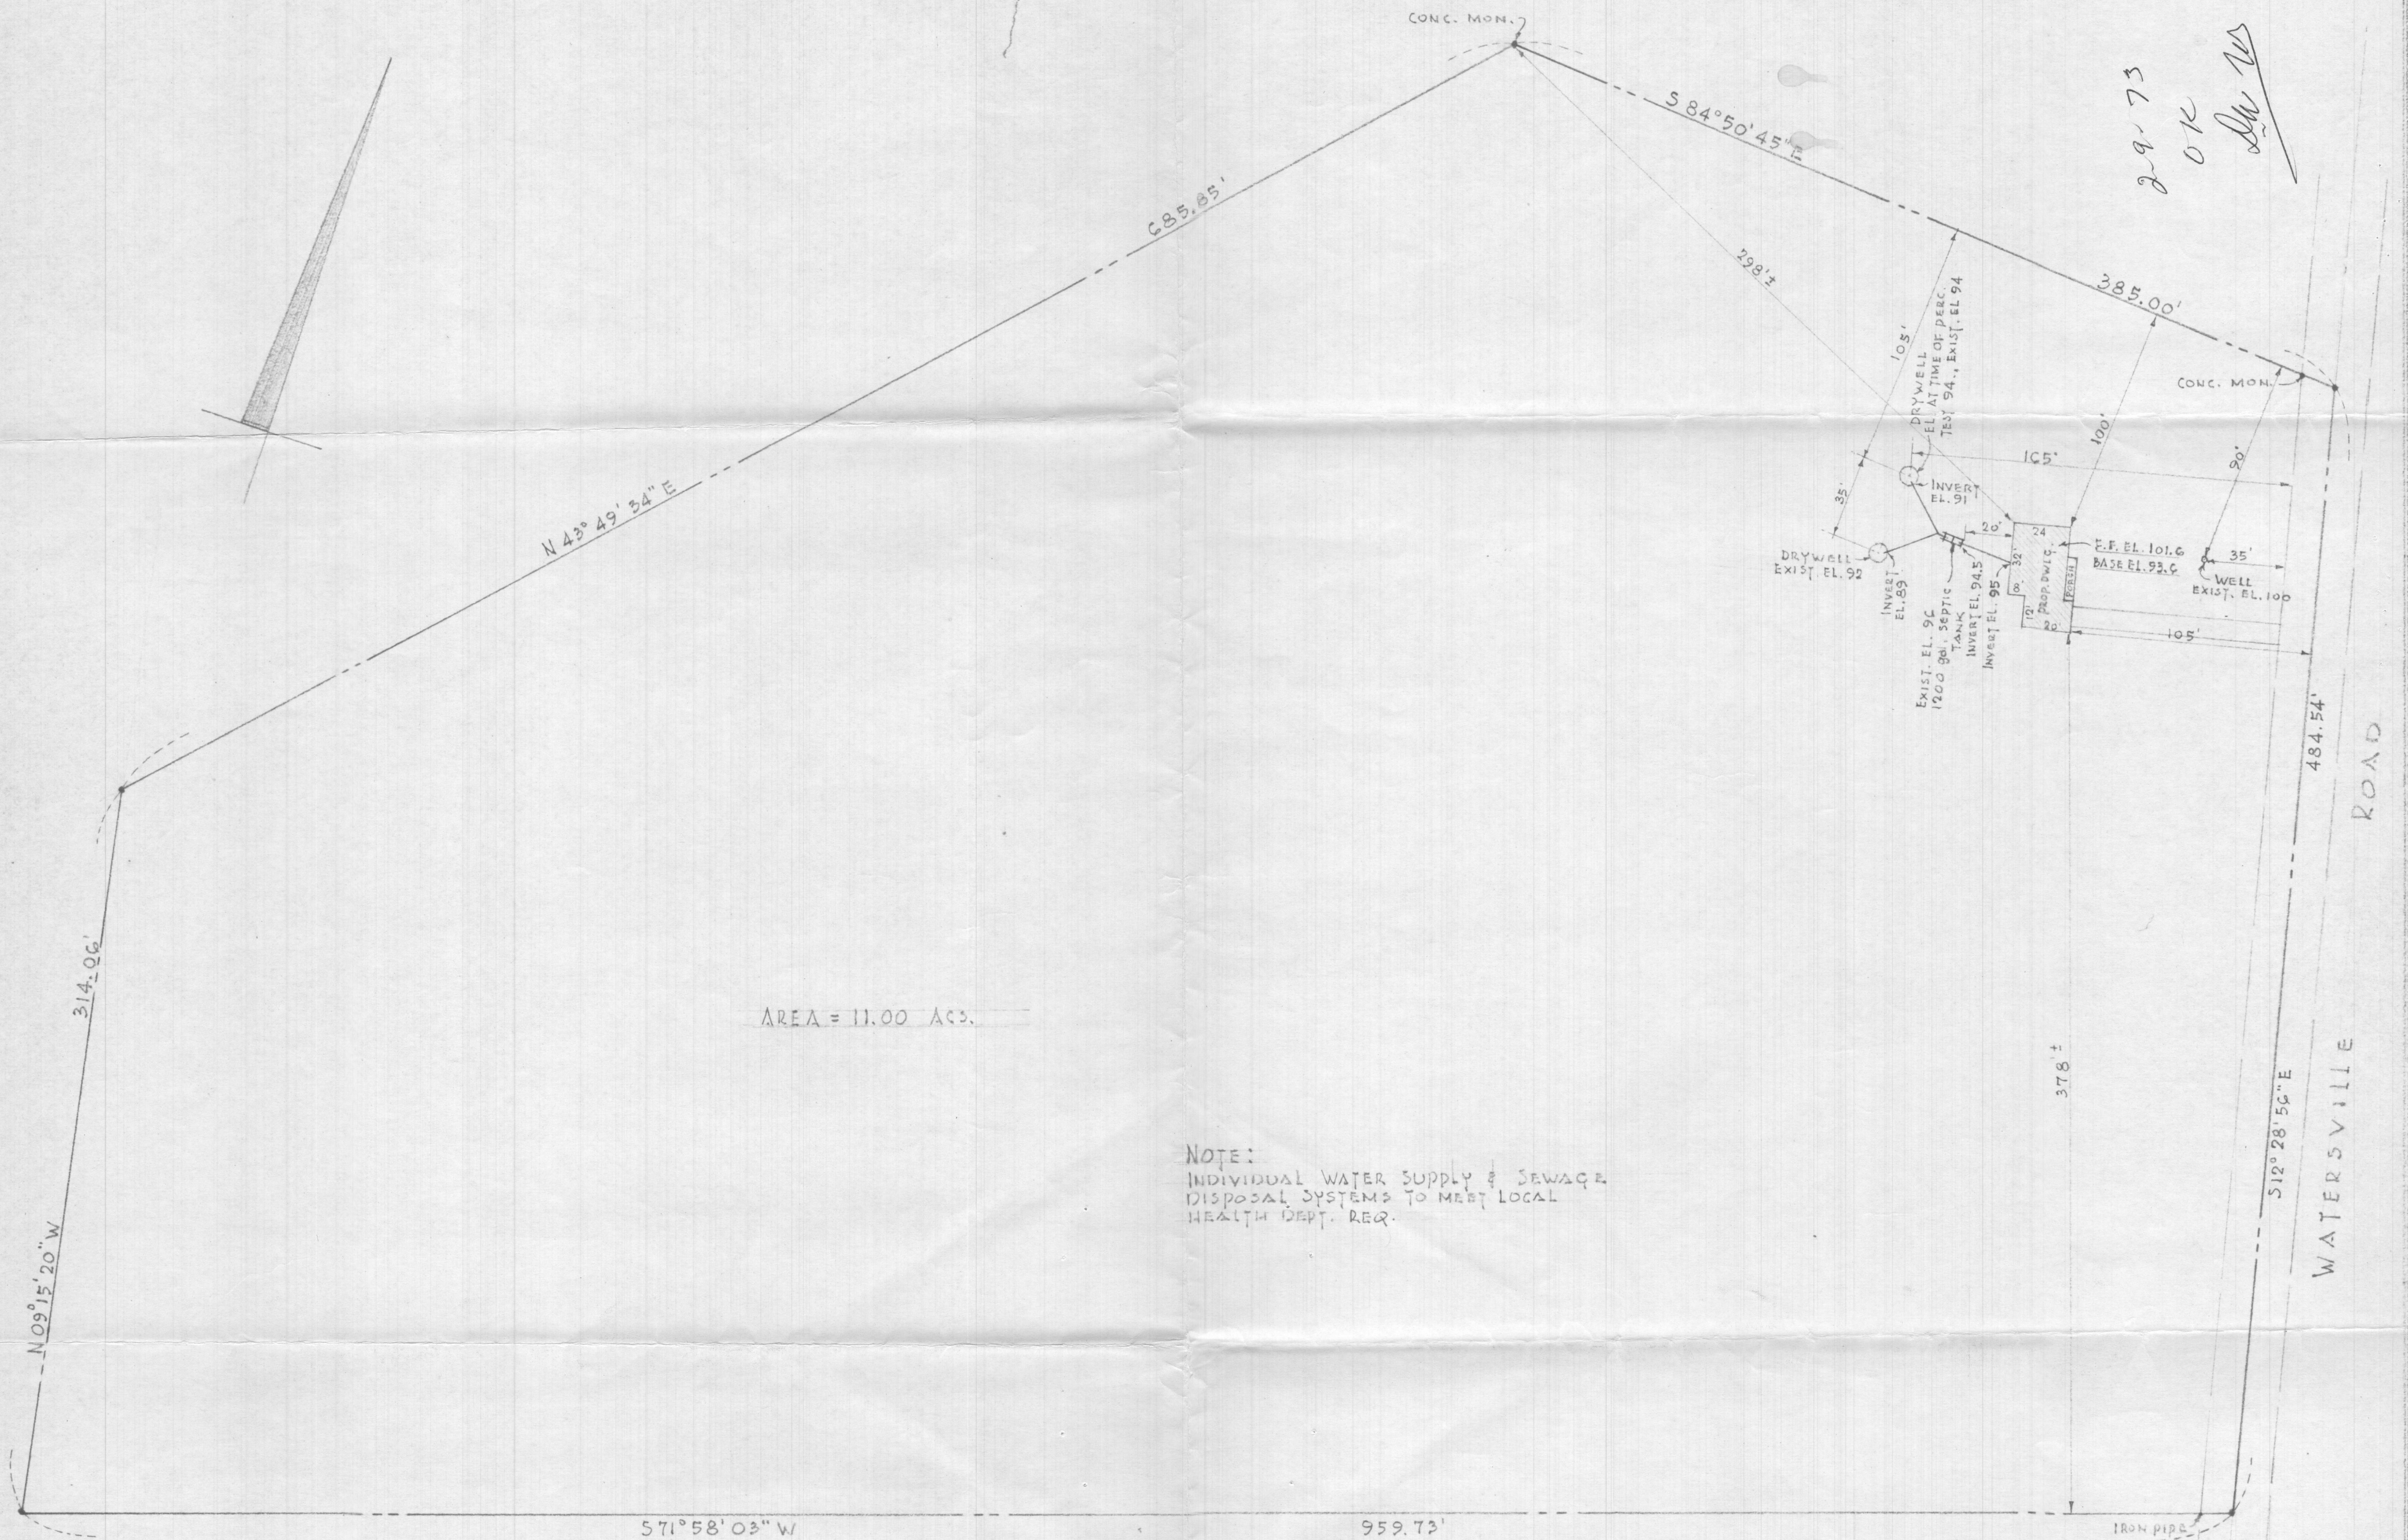

AREA = 11.00 ACS.

NOTE:
INDIVIDUAL WATER SUPPLY & SEWAGE
DISPOSAL SYSTEMS TO MEET LOCAL
HEALTH DEPT. REQ.

PLOT PLAN
1" = 50'




PROPERTY OF
MR. & MRS. CHARLES W. NORANBROCK
4th ELECT. DIST., HOWARD COUNTY, MARYLAND

LIBER 547, FOLIO 14

2/6/73 1/8/73 9/74

2-9-73
OK
SW 143

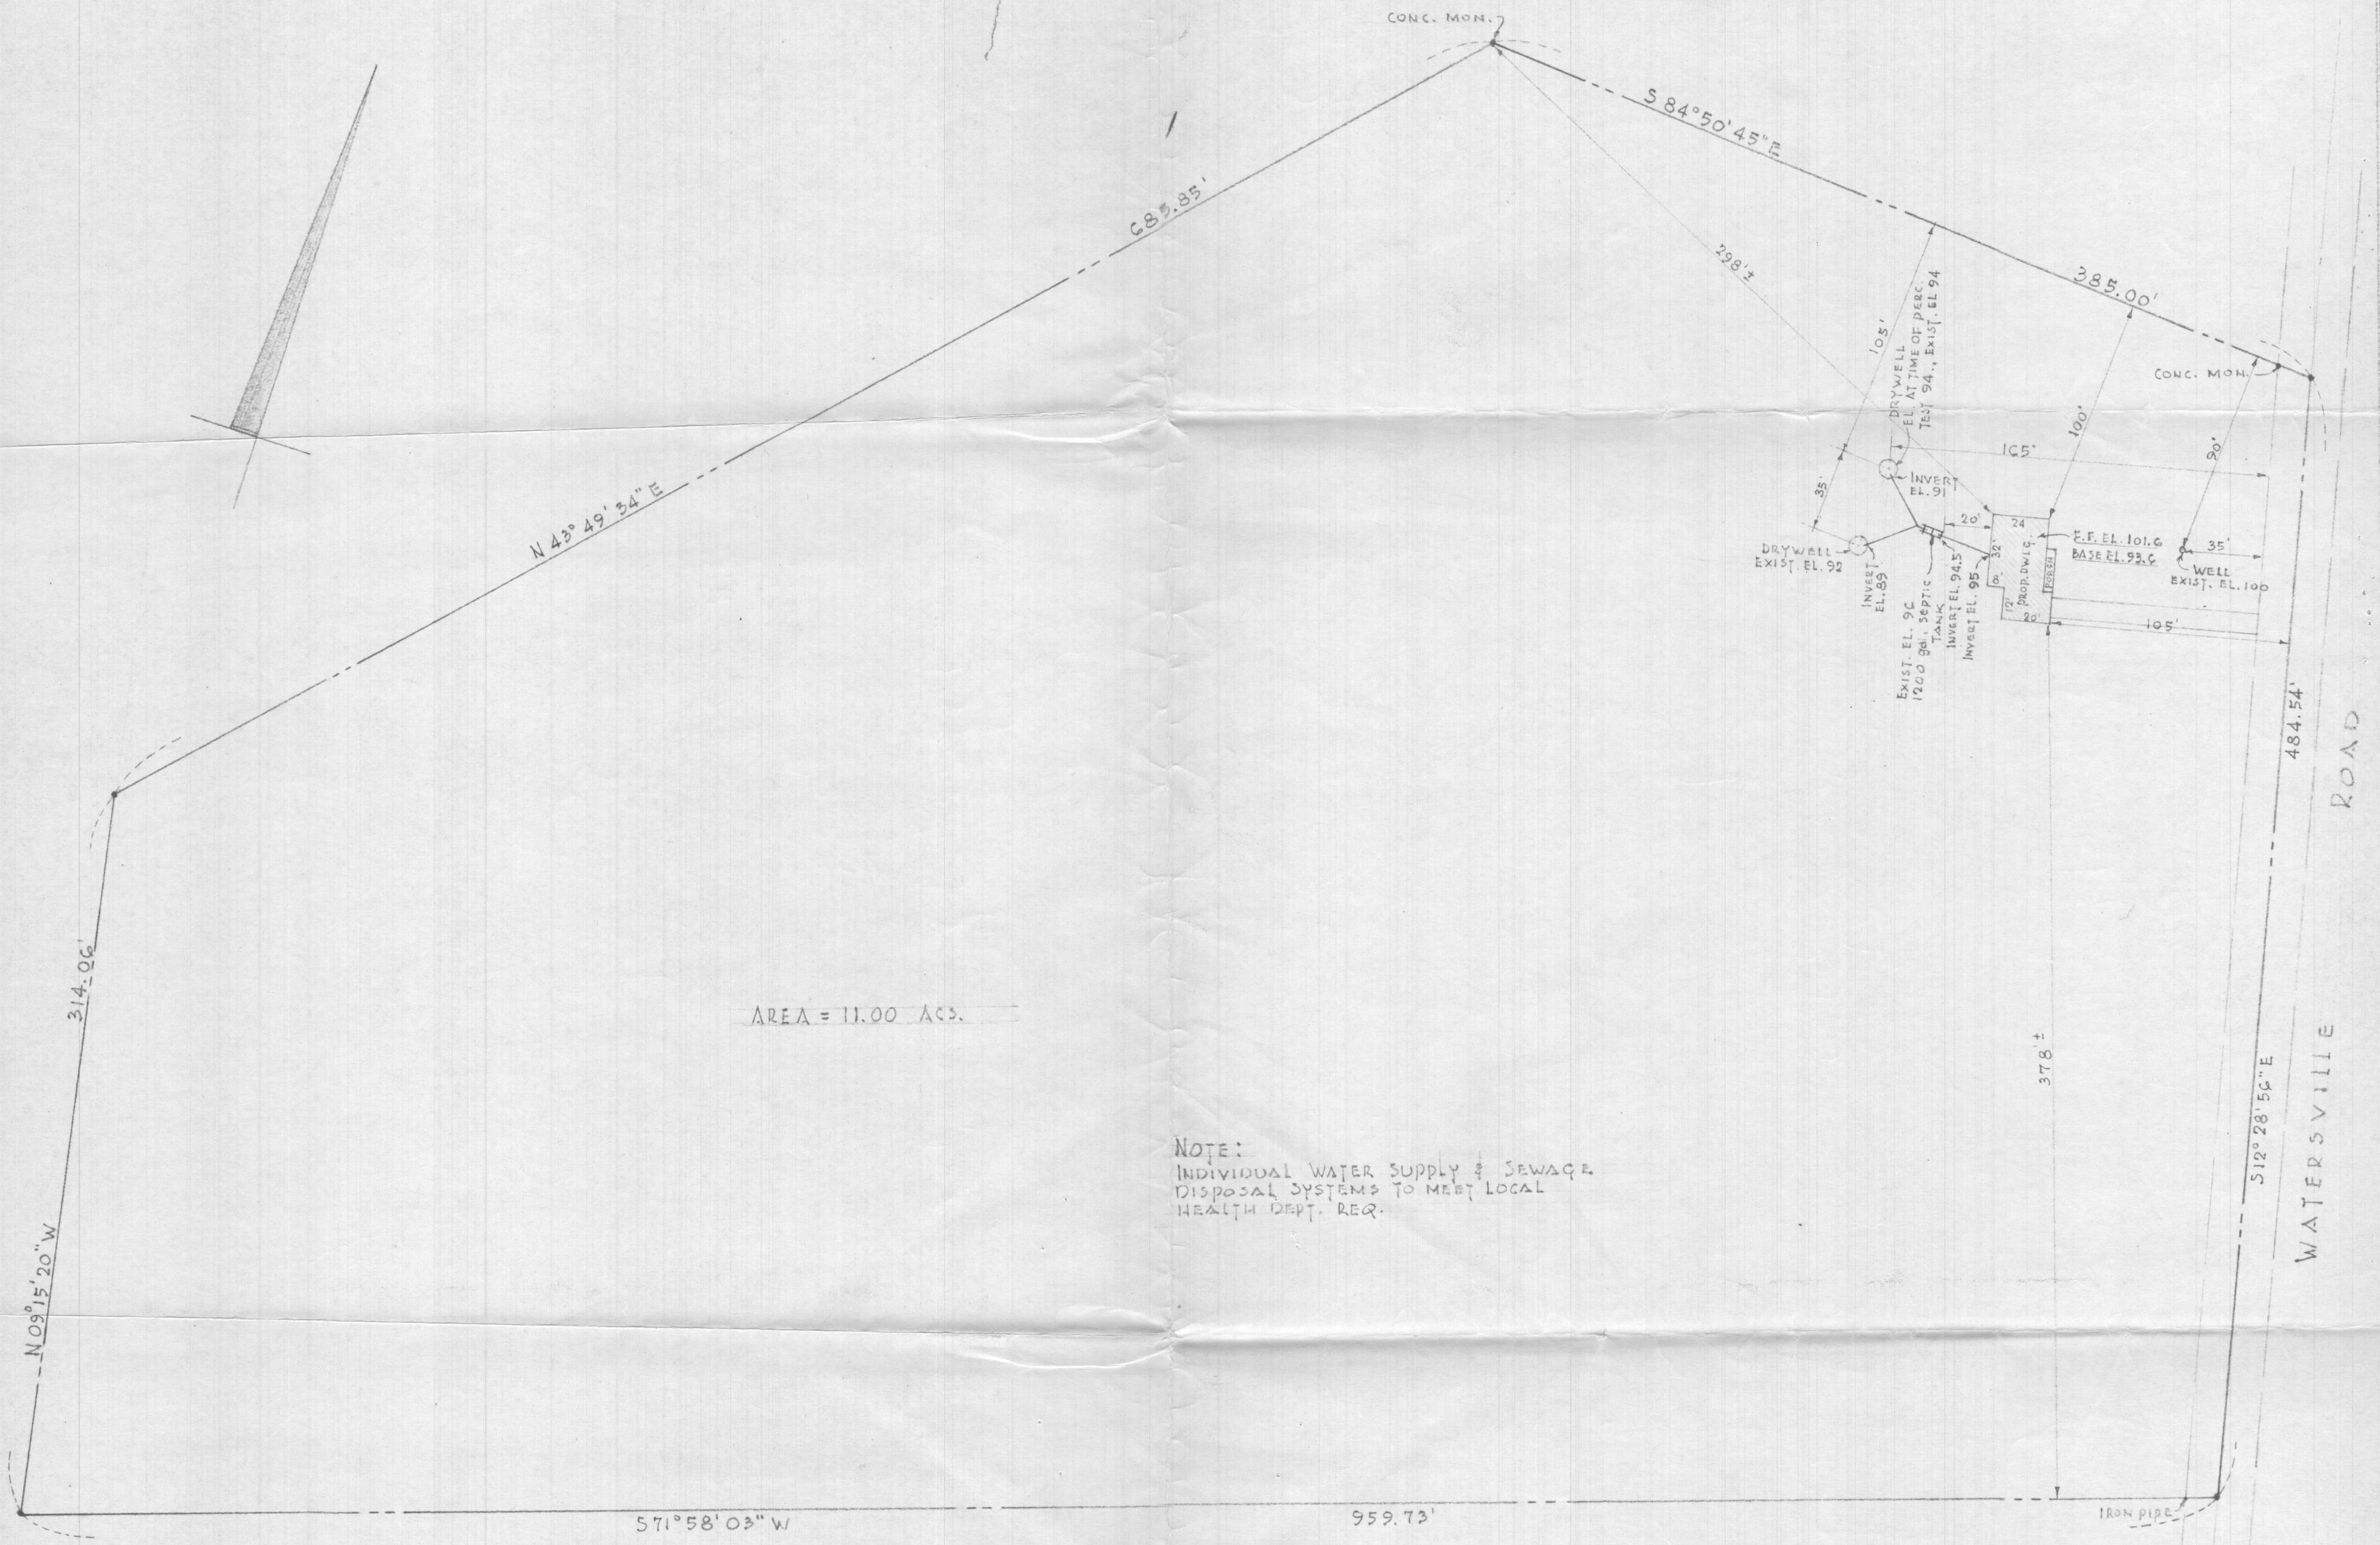

PLOT PLAN
1" = 50'



PROPERTY OF
MR. & MRS. CHARLES W. NORANBROCK
4TH ELECT. DIST., HOWARD COUNTY, MARYLAND

LIBER 547, Folio 14

2/6/73 1/8/73 9/74