

APPLICATION

FOR PERCOLATION TESTING AND SITE EVALUATION

TEST DATE(S) _____ TEST TIME _____ (A/P 5 30 267

AGENCY REVIEW: _____ DATE 12/30/05

DO NOT WRITE ABOVE THIS LINE

I HEREBY APPLY FOR THE NECESSARY TESTING/EVALUATION PRIOR TO ISSUANCE OF SEWAGE DISPOSAL SYSTEM PERMIT(S) TO:

CHECK AS NEEDED:

- CONSTRUCT NEW SEPTIC SYSTEM(S)
- REPAIR/ADD TO AN EXISTING SEPTIC SYSTEM
- REPLACE AN EXISTING SEPTIC SYSTEM

CHECK AS NEEDED:

- NEW STRUCTURE(S)
- ADDITION TO AN EXISTING STRUCTURE
- REPLACE AN EXISTING STRUCTURE

CHECK ONE:

- CREATE NEW LOT(S)
- BUILD ON AN EXISTING LOT IN A SUBDIVISION
- BUILD ON AN EXISTING PARCEL OF RECORD

IS THE PROPERTY WITHIN 2500' OF ANY RESERVOIR?

- YES
- NO

THE TYPE OF STRUCTURE IS:

- RESIDENTIAL WITH UNKNOWN PROPOSED BEDROOMS IN THE COMPLETED STRUCTURE (NOTE UNKNOWN IF APPROPRIATE)
- COMMERCIAL (PROVIDE DETAIL OF NUMBERS AND TYPES OF EMPLOYEES/ CUSTOMERS ON ACCOMPANYING PLAN)
- INSTITUTIONAL/GOVERNMENT (PROVIDE DETAIL OF NUMBERS AND TYPES OF EMPLOYEES/USERS ON ACCOMPANYING PLAN)

PROPERTY OWNER(S) ST. PAUL'S LUTHERAN CHURCH OF FULTON, MARYLAND

DAYTIME PHONE 301-405-1401 CELL ATTN: BOB PETERS FAX _____

MAILING ADDRESS 11795 ROUTE 216, FULTON, MD 20759
STREET CITY/TOWN STATE ZIP

APPLICANT GUTSCHICK, LITTLE & WEBER, P.A. ATTN: PAUL CLARK

DAYTIME PHONE 410-880-1820 CELL _____ FAX 301-421-4186

MAILING ADDRESS 3909 NATIONAL DRIVE, SUITE 250, BURTNSVILLE, MD 20866
STREET CITY/TOWN STATE ZIP

APPLICANT'S ROLE: DEVELOPER BUILDER BUYER RELATIVE/FRIEND REALTOR CONSULTANT

PROPERTY LOCATION
SUBDIVISION/PROPERTY NAME ST. PAUL'S CHURCH PROPERTY LOT NO. 2

PROPERTY ADDRESS 11815 LIME KILN ROAD, FULTON, MD 20759
STREET TOWN/POST OFFICE

TAX MAP PAGE(S) 46 GRID 2 PARCEL(S) 105 PROPOSED LOT SIZE 3 AC +

AS APPLICANT, I UNDERSTAND THE FOLLOWING: THE SYSTEM INSTALLED SUBSEQUENT TO THIS APPLICATION IS ACCEPTABLE ONLY UNTIL PUBLIC SEWERAGE IS AVAILABLE. THIS APPLICATION IS COMPLETE WHEN ALL APPLICABLE FEES AND A SUITABLE SITE PLAN HAVE BEEN RECEIVED. I ACCEPT THE RESPONSIBILITY FOR COMPLIANCE WITH ALL M.O.S.H.A. AND "MISS UTILITY" REQUIREMENTS. APPROVAL IS BASED UPON SATISFACTORY REVIEW OF A PERC CERTIFICATION PLAN.

TEST RESULTS WILL BE MAILED TO APPLICANT. _____
SIGNATURE OF APPLICANT

HOWARD COUNTY HEALTH DEPARTMENT, BUREAU OF ENVIRONMENTAL HEALTH, WELL AND SEPTIC PROGRAM
7178 COLUMBIA GATEWAY DRIVE COLUMBIA, MARYLAND 21046 (410) 313-1771 FAX (410) 313-2648
TDD (410) 313-2323 TOLL FREE 1-877-4MD-DHMH

A/P _____

Empty rectangular box for notes or data.

Empty rectangular box for notes or data.

Empty rectangular box for notes or data.

Large empty rectangular box for detailed notes or diagrams.

Empty rectangular box for notes or data.

Empty rectangular box for notes or data.

Empty rectangular box for notes or data.

DATE	TEST #	DEPTH	START	BREAK 1" DROP	STOP 2" DROP	TIME OF 2ND INCH	P/F/H


REMARKS _____

SANITARIAN _____ BACKHOE _____ OTHERS _____

TEST HOLES USED IN SDA _____ AVG. PERC TIME _____ SQ. FT/BR _____

TRENCH WIDTH _____ INLET DEPTH _____ MAX. BOT DEPTH _____ EFFECTIVE S/W _____

2 A
 Dk Gry SL
 Black 2 SBK
 -----1'
 Red-Brown
 SCL
 -----2'
 Red SL
 Much Mica
 Few Small
 Stones
 ↓
 -----8'
 Red Brown
 SL
 Moist
 H2O in the
 Bottom
 -----14'

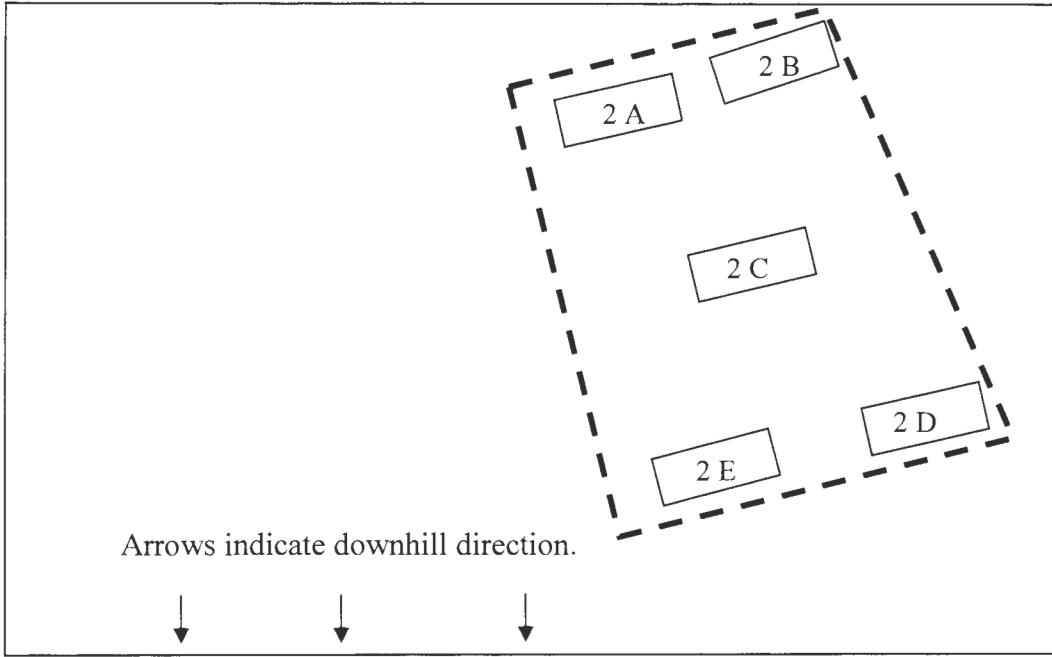

2 C
 Grey Brown
 2 SBK SCL
 -----0.8'
 Red Brown SCL
 -----2'
 Yellow
 Red-Brown
 SL
 Much Mica
 Few Small
 Stones
 ↓
 -----13'

2 B
**Same
 Profile
 As
 2 C**

Date	Test #	Depth	Start	Break 1" Drop	Break 2" Drop	Time of 2 nd Inch	P/F/H
05-13-09	2 A	5' / 14'	10:47 min.	11:01 min.	11:16 min.	15 min.	Pass
05-13-09	2 B	4.5' / 14'	10:14 min.	10:16 min.	10:21 min.	5 min.	Pass
05-13-09	2 C	4.5' / 13'	9:58 min.	10:02 min.	10:13 min.	11 min.	Pass
05-13-09	2 D	4.5' / 14'	10:24 min.	10:42 min.	Not to 1 st peg	22 min.	Fail
05-13-09	2 D	6' / 14' Repour	12:02 min.	12:17 min.	12:29 min.	14 min.	Pass
05-13-09	2 E	4.5' / 14'	11:25 min.	11:40 min.	11:55 min.	15 min.	Pass [#]

2 D
 Dk Brown
 SL, SBK
 -----1'
 Red
 Brown
 SCL
 -----6'
 Red
 Brown
 SL
 Much
 Mica
 -----10'
 Rd Brown
 SL
 Moist
 Flags
 -----14'

2 E
 Dark Brown
 SL, SBK
 -----1'
 Red- Brown
 SCL
 -----3'
 Red - Brown
 Fine SL
 Much Mica
 ↓
 -----14'

Remark ~~Inlet Dept for 2D is 6 Feet.~~

Sanitarians DB Backhoe Jason Others _____

Test Holes Used in SDA Avg. Perc Time 10 SQ.FT/BR 5 Bedrooms

Trench Width 2 Inlet Depth Max Bot.Depth 6 Effective S/W

P42
N/F PROPERTY OF
WILLIAM R. BRINLEY, JR
848 F. 507

APPROXIMATE
SEPTIC
LOCATION

HUNTERBROOKE

Signed per
CEFF 7-11-12

PERCEIVED NON-BUILDABLE
AREA

Lot 2

P344
N/F PROPERTY OF
MARY A HOWARD
L 8038 F. 106
PART ONE

APPROXIMATE
SEPTIC
LOCATION

PT-2A
PT-2B
PT-2C
PT-2D
PT-2E

PT-1A
PT-1B
PT-1C
PT-1E
PT-1D

