

APPLICATION

A 29059

SEWAGE DISPOSAL TESTING

STATE OF MARYLAND - DEPARTMENT OF HEALTH AND MENTAL HYGIENE

HOWARD COUNTY HEALTH DEPARTMENT
ENVIRONMENTAL HEALTH SERVICES

P.O. BOX 476 ELLICOTT, MARYLAND 21043
TELEPHONE: 992-2330

DISTRICT 5

DATE 10/16/80

TO: THE COUNTY HEALTH OFFICER
ELLICOTT CITY, MARYLAND

I, HEREBY, APPLY FOR THE NECESSARY TEST IN ORDER TO CONSTRUCT (OR RECONSTRUCT) A SEWAGE DISPOSAL SYSTEM.

PROPERTY OWNER

ADDRESS

PHONE

PROPERTY LOCATION:

SUBDIVISION

LOT NO.

ROAD AND DESCRIPTION

SIZE OF LOT

TYPE BLDG.

THE SYSTEM INSTALLED UNDER THIS APPLICATION IS ACCEPTABLE ONLY UNTIL PUBLIC FACILITIES BECOME AVAILABLE.

I FULLY UNDERSTAND THE FEE CONNECTED WITH THE FILING OF THIS PERC TEST APPLICATION IS NON-REFUNDABLE UNDER

ANY CIRCUMSTANCES

SIGNATURE OF APPLICANT

APPROVED BY

FOR

DATE

REJECTED BY

FOR

DATE

HOLD PENDING FURTHER TESTS



REASONS FOR REJECTION OR HOLDING

THIS IS NOT A PERMIT

12 sheet #1

Field
Notes

SOIL PROFILE

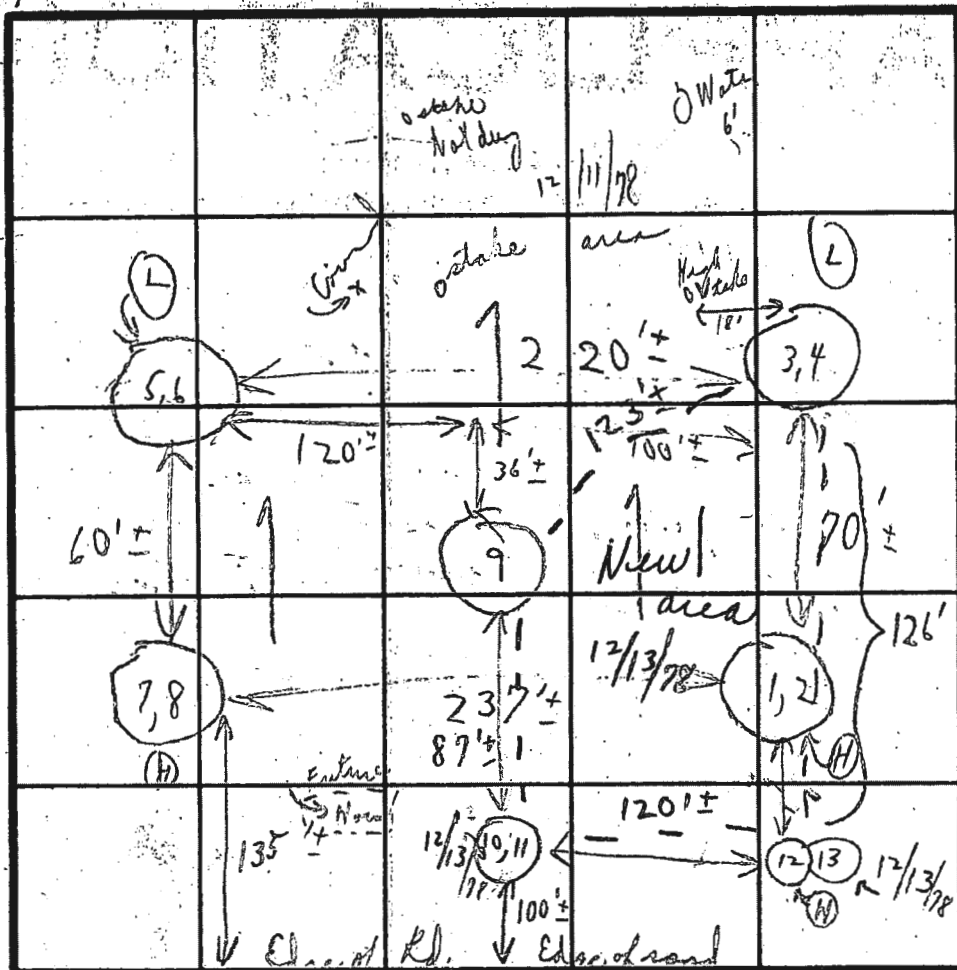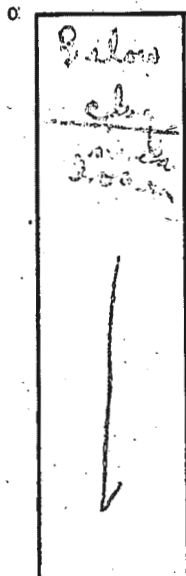

don't
mean
conferment
12/12/78
Still hold

12/13/78
5' 10" 11.8% 1.5' 1.6m
13' 11" 11.8% 1.5' 1.6m
6' 12" 11.8% 1.5' 1.6m
12/13
Area down
11/88

INDICATE NORTH - NAME ADJOINING ROADWAY AS BASE LINE

Philadelphia Mill Rd.

DATE	TEST NO.	DEPTH	PRE-WET		TEST - 1" DROP		TIME
			START	STOP	START	STOP	
12/12/78	1	6 1/2'	11:04	11:06	11:06	11:11	5 in
	2	13'	11:00	11:04	11:04	11:12	8 in
	3	6'	10:59	11:02	11:02	11:29	27 in
	4	12'	10:59	11:01	11:01	11:07	6 in
	5	6'	10:47	10:49	10:49	10:52	3 in
12/12/78	6	11 1/2'	10:46	10:50	10:50	10:58	8 in
	7	6'	11:15	11:17	11:17	11:21	4 in
	8	12'	11:14	11:17	11:17	11:21	4 in
	9	4' - 11 1/2'	Vessel simulation to (1, 2) sandy loam		12/12/78 Hold for supervisor		65

Micro

Don't
under
4'
wood grain
5'
125 yd ft
effective
Water 11 1/2
per below
11:20
on way
sandy loam

REMARKS { (12/11/78 Gold) 12/12/78 }

TYPE OF SOIL

TESTED BY

C. B. J.


ALSO PRESENT

S. P. Schaefer

Comp. Lab. - equal

Held for wet season
Tests in over field near road
Holes dug at time of arrival on lot

Triadelphia Mill Farms
Lot 12 Sec 1

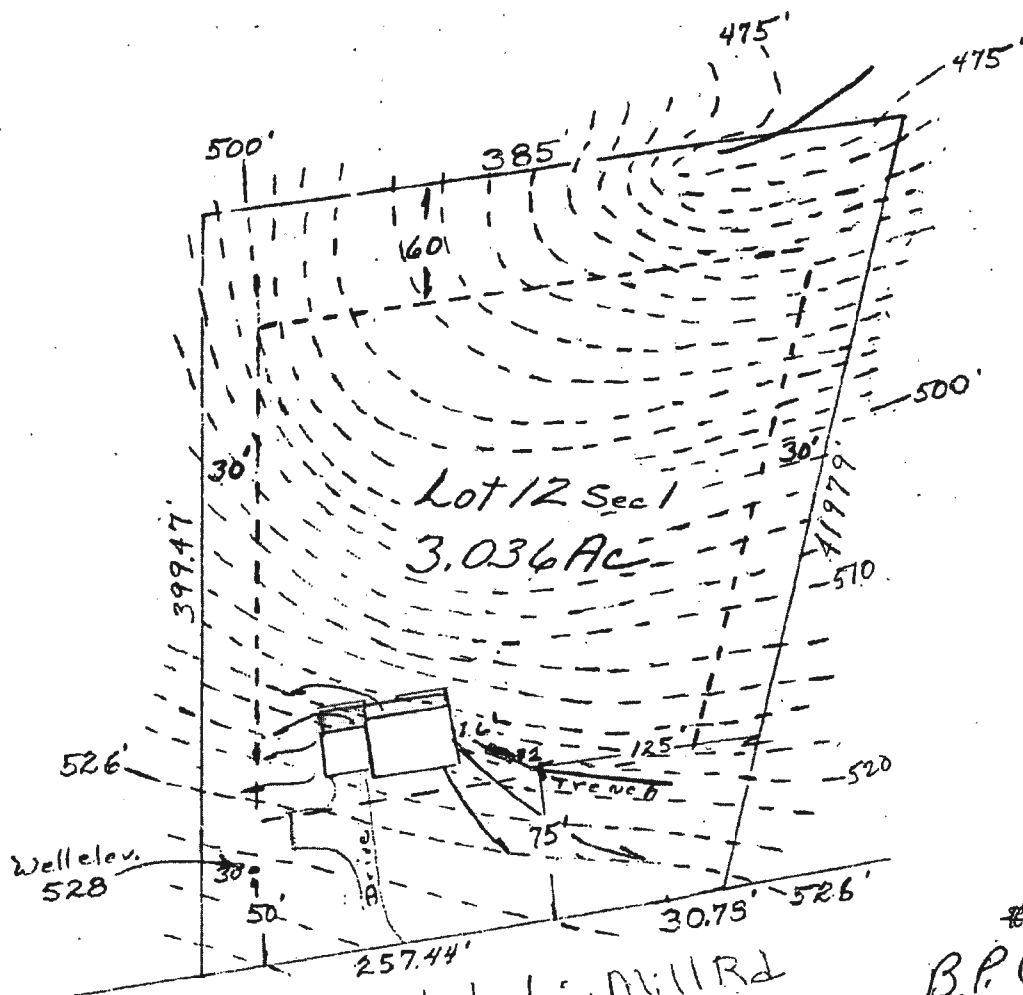

B.P. 64060
Signed 4/2/85

Larry Donn Wilson
13983 Triadelphia Mill Rd
Dayton, Md 21036
Phone 8542774


F.F. Elev.	526'
Base Elev.	517'
Elev. at Time of perc.	521'
Exist. elev. at trench	521'
Elev. of sewer at house	519'
Elev. at tank Inv.	518.5'
Elev. at tank Exist	518.2'
Elev. at Trench Inv.	518'

Scale 1" = 100'

I certify that all elev. are actual & correct
for this property Larry Wilson

*** SEE DECK CODE COMPLIANCE GUIDELINES FOR MINIMUM SPECIFICATIONS


• Freestanding, will have beam close side of house due to brick construction. Span 60 ft 0 in.

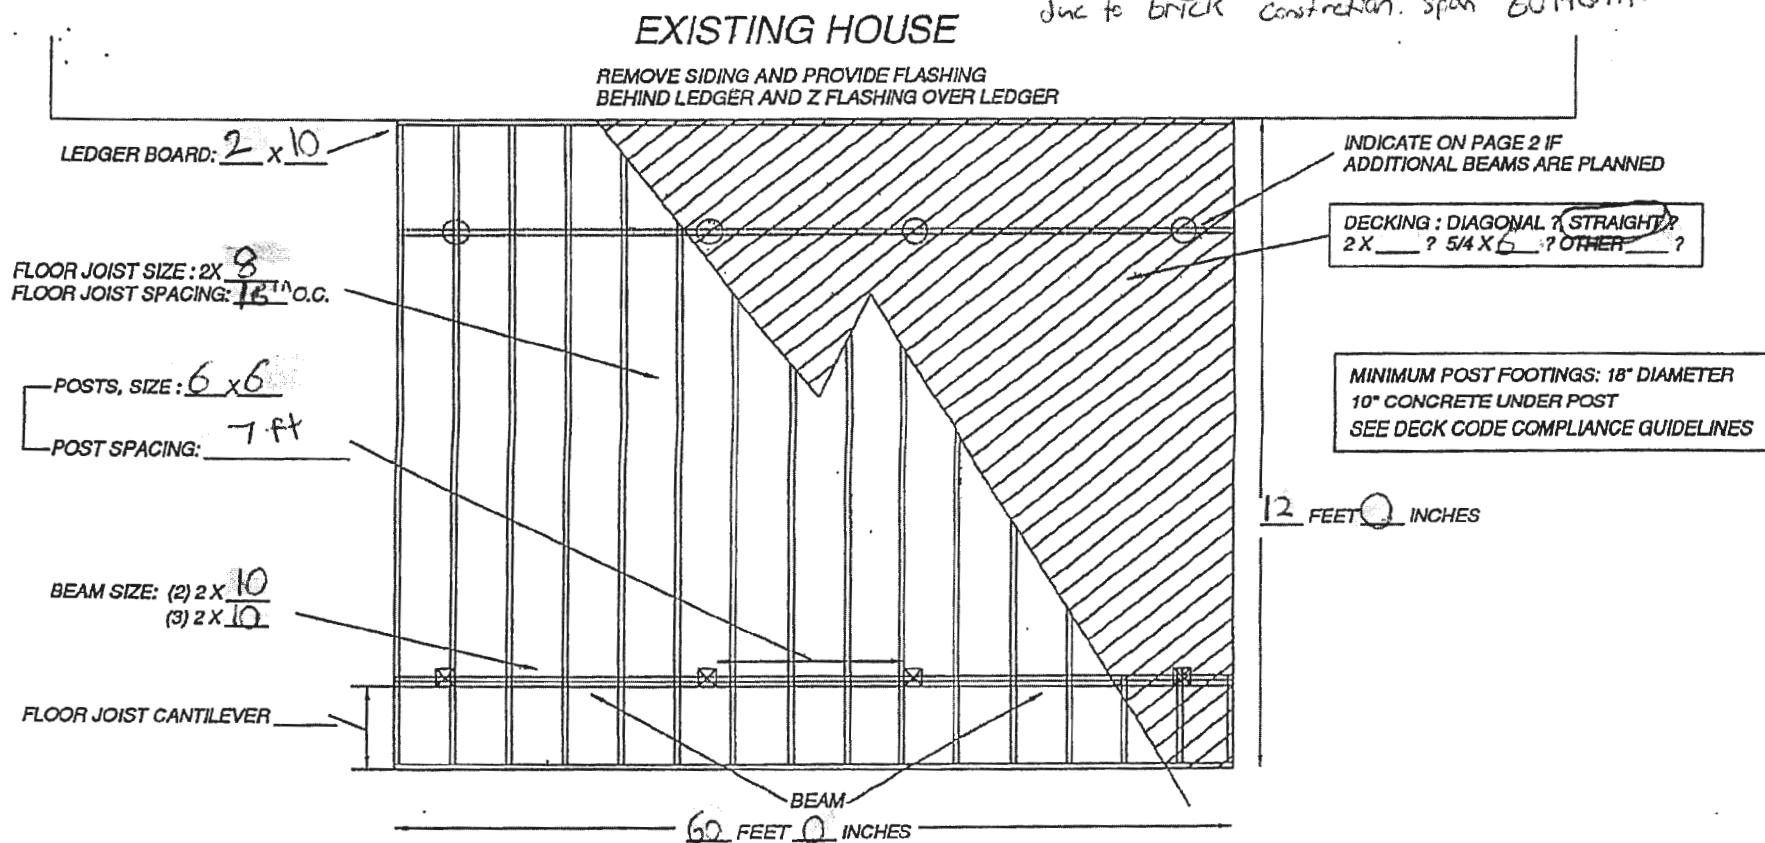

Sample **①** DECK FLOOR FRAMING PLAN EXAMPLE

1 OF 2

*** SEE DECK CODE COMPLIANCE GUIDELINES
FOR MINIMUM SPECIFICATIONS

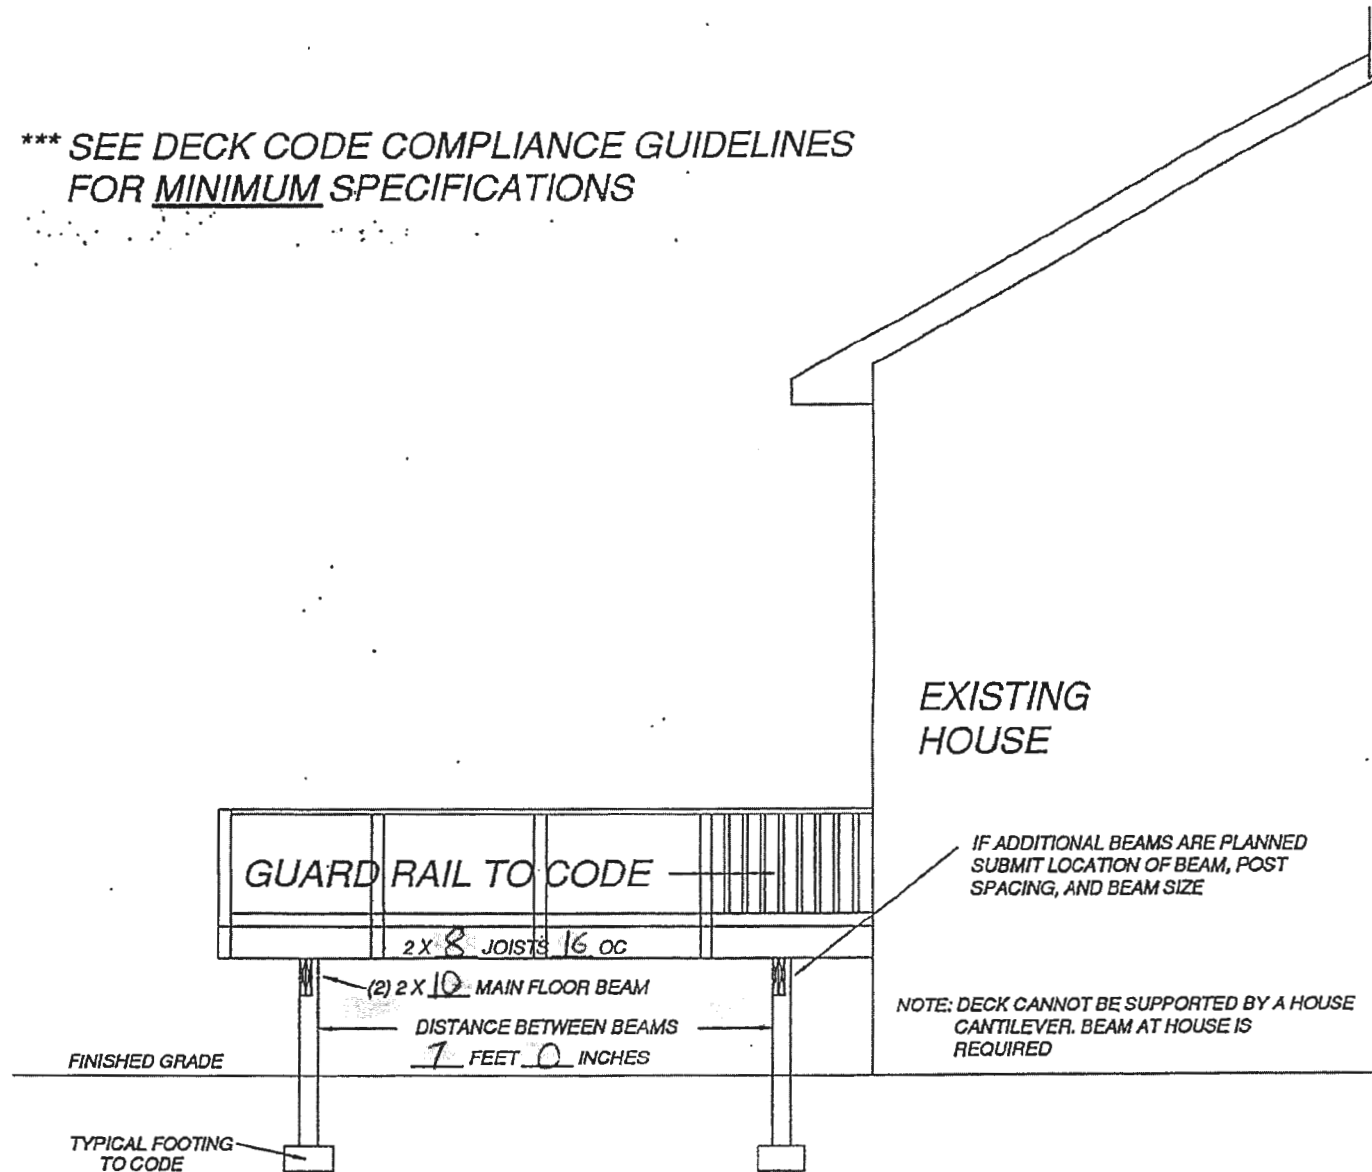

DECK CROSS SECTION

Dent_PercWaiver Request

Final Audit Report

2023-04-21

Created:	2023-04-20
By:	Olivia Dent (odent@umd.edu)
Status:	Signed
Transaction ID:	CBJCHBCAABAAako5Vy0ycvh5peRYsf5HKXvW7py_Rfwh

"Dent_PercWaiver Request" History

-  Document created by Olivia Dent (odent@umd.edu)
2023-04-20 - 10:30:55 PM GMT- IP address: 71.179.160.74
-  Document emailed to cdent@howardcountymd.gov for signature
2023-04-20 - 10:31:28 PM GMT
-  Email viewed by cdent@howardcountymd.gov
2023-04-21 - 4:43:03 PM GMT- IP address: 104.47.65.254
-  Signer cdent@howardcountymd.gov entered name at signing as Claude dent
2023-04-21 - 4:43:42 PM GMT- IP address: 107.116.79.86
-  Document e-signed by Claude dent (cdent@howardcountymd.gov)
Signature Date: 2023-04-21 - 4:43:44 PM GMT - Time Source: server- IP address: 107.116.79.86
-  Agreement completed.
2023-04-21 - 4:43:44 PM GMT

Names and email addresses are entered into the Acrobat Sign service by Acrobat Sign users and are unverified unless otherwise noted.