**Bureau of Environmental Health**

8930 Stanford Boulevard, Columbia, MD 21045

Main: 410-313-2640 | Fax: 410-313-2648

TDD 410-313-2323 | Toll Free 1-866-313-6300

www.hchealth.orgFacebook: www.facebook.com/hocohealth

Maura J. Rossman, M.D., Health Officer

RECEIPT DATE: 05/3/23**ONSITE SEWAGE DISPOSAL SYSTEM**P 574113

INSTALLATION

APPROVAL DATE: 5/8/23 (SP)**PERMIT**

A _____

MINOR REPAIRPROPERTY ADDRESS: 13963 Triadelphia Mill RoadSUBDIVISION: Triadelphia MillLOT: 12 TAX ID: _____CONTRACTOR: Fogles Septic Clean Inc.EMAIL: kim@foglesinc.comCONTRACTOR ADDRESS: 580 Obrecht Road, Sykesville, MD 21784PHONE: 410-795-5670PROPERTY OWNER: Claude and Olivia Dent

EMAIL: _____

OWNER ADDRESS: 13963 Triadelphia Mill Road, Dayton, MD 21036

PHONE: _____

NUMBER OF BEDROOMS: _____ SEPTIC TANK SIZE: _____ DRAINFIELD SIZE/TYPE: _____

LOCATION:	
NOTES:	Fill the drywell with stone and install perforated pipe. Septic Contractor to determine whether reconnection to existing system is possible. Contact Health Department if connection isn't feasible. <i>front & back line & D-box</i>

ISSUED BY: K. WolfISSUE DATE: 5/3/2023EXPIRATION DATE: 5/3/2024

NOTE: CONTRACTOR MUST SCHEDULE AN INSPECTION AND GAIN APPROVAL OF ALL COMPONENTS PRIOR TO COVERING

NOTE: AN ELECTRICAL PERMIT IS REQUIRED FOR INSTALLATION OF ANY ELECTRICAL COMPONENTS OF THE SYSTEM


NOTE: MDE RECOMMENDS SEPTIC TANKS, BAT, AND OTHER PRETREATMENT UNITS BE PUMPED AT A FREQUENCY ADEQUATE TO ENSURE THAT SOLIDS ARE NOT DISCHARGED TO THE DISPOSAL AREA

**NEITHER THE HOWARD COUNTY COUNCIL NOR THE HEALTH DEPARTMENT IS RESPONSIBLE
FOR THE SUCCESSFUL OPERATION OF ANY SYSTEM.**

PERMITTEE RESPONSIBLE FOR OBTAINING FINAL APPROVAL ON THIS PERMIT.

CALL 410-313-1771 FOR INSPECTION OF SEPTIC SYSTEM.

NOT TO SCALE

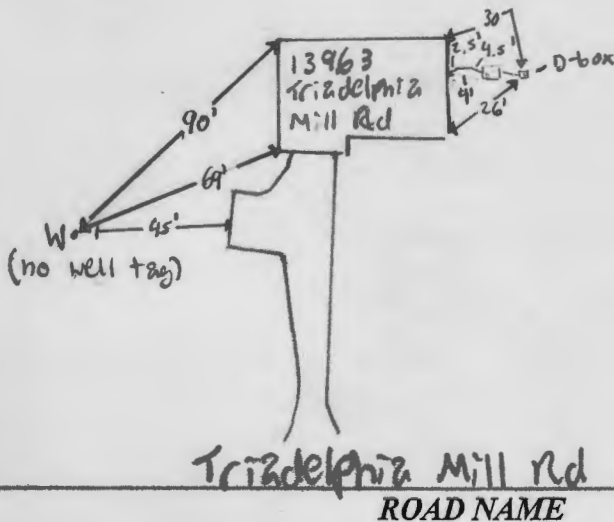

Existing

TRENCH/DRAINFIELD DATA

WIDTH INLET BOTTOM

NUMBER OF TRENCHES

TOTAL LENGTH

ABSORPTION AREA

DISTRIBUTION BOX LEVEL yes

DISTRIBUTION BOX BAFFLE yes

DISTRIBUTION BOX PORT yes

Existing

SEPTIC TANK DATA

SEPTIC TANK 1 LEVEL

MANUFACTURER

CAPACITY GAL

SEAM LOC

TANK LID DEPTH

BAFFLES

BAFFLE FILTER

MANHOLE LOC

6" PORT LOC

WATERTIGHT TEST

SLOTTED

DATE ON LID

PUMP/SEPTIC TANK LEVEL N/A

MANUFACTURER

CAPACITY GAL

SEAM LOC

TANK LID DEPTH

BAFFLES

BAFFLE FILTER

MANHOLE LOC

6" PORT LOC

WATERTIGHT TEST

SLOTTED

DATE ON LID

PRE-CONSTRUCTION:

INSTALLATION: 5/8/2023 - Contractor + homeowner onsite. Front line uncovered
17' fall verified, Schedule 40 pipe used, saw D-box w/ levelers.
D-box had baffles, port, & was level (S)

FINAL INSPECTOR

Shepsura Page

DATE OF APPROVAL

5/8/2023

Howard County Health Department

Bureau of Environmental Health, Columbia, MD 21045 - 410-313-1771

SEWAGE DISPOSAL PERMIT NO. A-_____ P- 574113

RESIDENTIAL PERMIT ☐

COMMERCIAL PERMIT ☐

(NUMBER OF BEDROOMS: _____)

(DESIGN FLOW: _____ GPD)

PERMITEE:

Fogles Septic Clean Inc.

LOCATION:

13903 Tridelphia Hill Rd Tridelphia Hill Md 21142

****POST THIS CARD WHERE IT CAN BE SEEN FROM ROAD****

☐

STOP ALL CONSTRUCTION ON SEWAGE
DISPOSAL SYSTEM AND CONTACT HEALTH
DEPARTMENT BEFORE CONTINUING

Inspector _____

Date _____

☐

WORK IS SATISFACTORY, OK TO
CONTINUE

Inspector _____

Date _____

COMMENTS: _____

☐

FINAL INSPECTION MADE, OK TO
COVER ALL WORK

Inspector _____

Date _____

4-29-86

4-28-86

approved S. Abel

PERMIT

P 353/4

A 29059

SEWAGE DISPOSAL SYSTEM

MARYLAND STATE DEPARTMENT OF HEALTH

HOWARD COUNTY

BUREAU OF ENVIRONMENTAL HEALTH

992-2330

05-388589

INDEXED

ELLICOTT CITY

DISTRICT 5th

DATE 4/09/85

Souder Builders, Inc.

IS PERMITTED TO INSTALL ☒ ALTER ☐

ADDRESS 9335 Old Scaggsville Road, Laurel, MD 20707 PHONE

SUBDIVISION Triadelphia Mill Farms ROAD 13963 Triadelphia Mill LOT 12

PROPERTY OWNER Larry & Donna Wilson

ADDRESS

IF GARBAGE GRINDER IS USED INCREASE SEPTIC TANK CAPACITY BY 50% AND ABSORPTION AREA BY 22%.

GARBAGE GRINDER? YES ☐ NO ☒

SEPTIC TANK CAPACITY 1250 GALLONS NUMBER OF BEDROOMS 4

TRENCHES - 180 sq. ft. per bedroom. Trench to be 2 feet wide. Inlet 4 feet below original grade. Bottom maximum depth 9 feet below original grade. Effective area begins at 4 feet below original grade. 5 feet of stone below distribution pipe. LOCATION: Start first trench 75 feet from the front lot line and 125 feet from the right lot line as seen when facing the lot from Triadelphia Mill Road. Run trenches along level ground toward right side of lot. NOTE: No trench to exceed 100 feet in length. If more than one trench used, a distribution box is required. Call for inspection of trench(s) before and after gravel is installed. Provide 6" - 8" diameter cleanout and cap to grade or above on septic tank. (Need 2-75 ft. trenches)

OK TO INSTALL SYSTEM WITHOUT INSPECTION

OVER THE WEEKEND. TRENCHES TO BE NO DEEPER THAN 8 1/2'

PLANS APPROVED BY C. Williams DATE 3/27/85

COVER NO WORK UNTIL INSPECTED AND APPROVED.

NEITHER THE HOWARD COUNTY COUNCIL NOR THE HEALTH DEPARTMENT IS RESPONSIBLE FOR THE SUCCESSFUL OPERATION OF ANY SYSTEM.

NOTE: IF TRENCH IS USED CALL FOR INSPECTION BEFORE AND AFTER PLACING GRAVEL IN TRENCH.

NOTE: NO DRY WELL SHALL EXCEED 15 FOOT IN DIAMETER. NO ABSORPTION TRENCH TO EXCEED 100 FEET IN LENGTH.

NOTE: ALL PIPE FROM HOUSE TO SEPTIC TANK MUST BE CAST IRON OR SCHEDULE 40 PVC OR ABS.

PERMIT VOID AFTER THREE YEARS.

NOTE: INSTALL STAND PIPE ON SEPTIC TANK AND DRY WELL. STAND PIPES MUST BE 6 INCHES IN DIAMETER. CAST IRON, CONCRETE OR TERRA COTTA, OR PVC OR ABS ACCEPTED. IF TOP OF SEPTIC TANK IS DEEPER THAN 3 FEET MANHOLE TO GRADE REQUIRED.


*INSTALLER IS RESPONSIBLE FOR OBTAINING FINAL APPROVAL ON THIS PERMIT

*CALL 992-2330 FOR INSPECTION OF SEPTIC SYSTEMS.

EH - 2-1082

A 29059

180
720
160
720
45
270
220

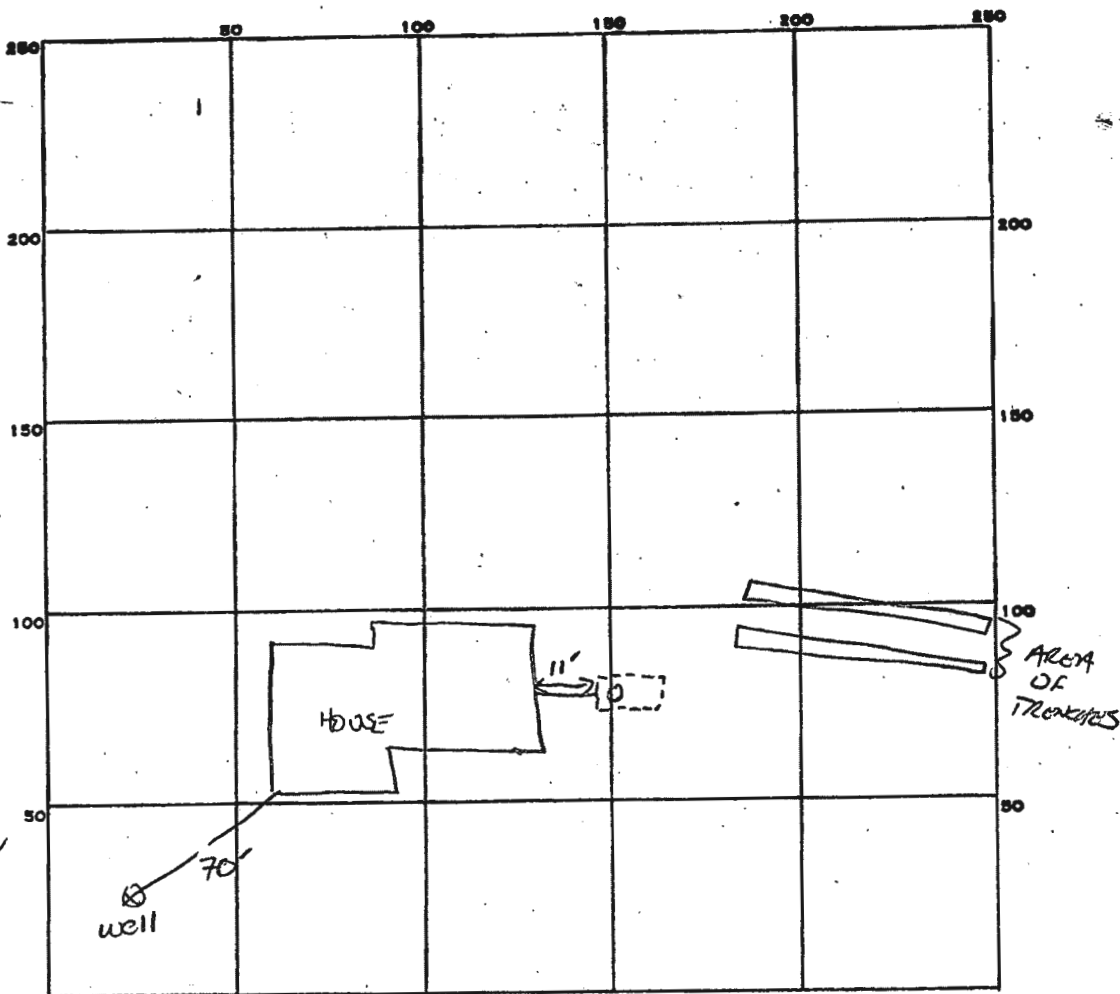

INDICATE NORTH. - NAME ADJOINING ROADWAY AS BASE LINE.

TRIADAPHA Mill Rd.

PERMIT CARD _____

SEPTIC TANK, LEVEL ✓ MIN 1250 (1500) CLEANOUTS ✓ ST

DISTRIBUTION BOX, LEVEL REQUIRED

TILE FIELD, DEPTH 8.5 FT. TRENCH WIDTH 2 FT. 4 Ft INLET

GRAVEL DEPTH 4.5 Ft IN. TOTAL LENGTH MIN. 160 FT.

NUMBER OF TRENCHES 2 ONE SIDE WALL TOTAL BOTTOM AREA 720 sq ft

SEEPAGE PITS, INSIDE DIAMETER _____ FT. DEPTH BELOW INLET _____ FT.

ABSORBENT AREA 720 SQ. FT. minimum

REMARKS 4-28-86 - SYSTEM INSTALLED OVER WEEKEND; AREA OF TRENCHES LOCATED;
ST C/O LOCATED. System completely covered before inspection made; Builder should
certify compliance that system was installed to specs. S. Abel

DATE SYSTEM APPROVED 4-28-86 INSPECTOR S. Abel