

APPLICATION

PERCOLATION TESTING

HOWARD COUNTY HEALTH DEPARTMENT
BUREAU OF ENVIRONMENTAL HEALTH
P.O. BOX 476 ELLICOTT CITY, MARYLAND 21043
TELEPHONE: 461-9933

A 38571

P 5

DISTRICT 5

DATE 12/15/86

TO: THE COUNTY HEALTH OFFICER
ELLICOTT CITY, MARYLAND

I, HEREBY, APPLY FOR THE NECESSARY TEST IN ORDER TO CONSTRUCT (OR RECONSTRUCT) A SEWAGE DISPOSAL SYSTEM.

PROPERTY OWNER Altogether Limited Partnership George Yee 854-3251

ADDRESS 10176 Baltimore National Pike Suite 210 PHONE 465-5855

PROSPECTIVE BUYER _____

ADDRESS _____

PROPERTY LOCATION:

SUBDIVISION Altogether Twelve Hills Sec 2 LOT NO. 10

ROAD AND DESCRIPTION Linden Church Rd + Rt 32

13018 Twelve Hills Rd.

TAX MAP 28 PARCEL # 66

SIZE OF LOT 3 acres TYPE BLDG. SFD

(SINGLE FAMILY DWELLING OR COMMERCIAL)

THE SYSTEM INSTALLED UNDER THIS APPLICATION IS ACCEPTABLE ONLY UNTIL PUBLIC FACILITIES BECOME AVAILABLE. I FULLY UNDERSTAND THE

FEE CONNECTED WITH THE FILING OF THIS PERC TEST APPLICATION IS NON-REFUNDABLE UNDER ANY CIRCUMSTANCES. I ALSO AGREE TO COMPLY

WITH ALL M.O.S.H.A. REQUIREMENTS IN TESTING THIS LOT. Mal S Reil

(SIGNATURE OF APPLICANT)

APPROVED BY Srd Abel FOR Deep trenches DATE 1-12-89

REJECTED BY _____ FOR _____ DATE _____

HOLD PENDING FURTHER TESTS _____ DATE _____

REASONS FOR REJECTION OR HOLDING 2/4/87 hold for plat. Sdk

BLDG. PERMIT SIGNED

AND RETURNED 1-12-89

BP 23195 Sdk

THIS IS NOT A PERMIT

Lot 10
(Lot 25 not to be tested today)

Lot 11


SOIL PROFILE
0' BROWN CLAY
3' PINK BROWN SAND LOAM

CLAY
PINK BROWN SAND LOAM

CLAY & TOPSOIL
BROWN SAND LOAM

BROWN CLAY
PINK BROWN SAND MILK LOAM

EH 12-107

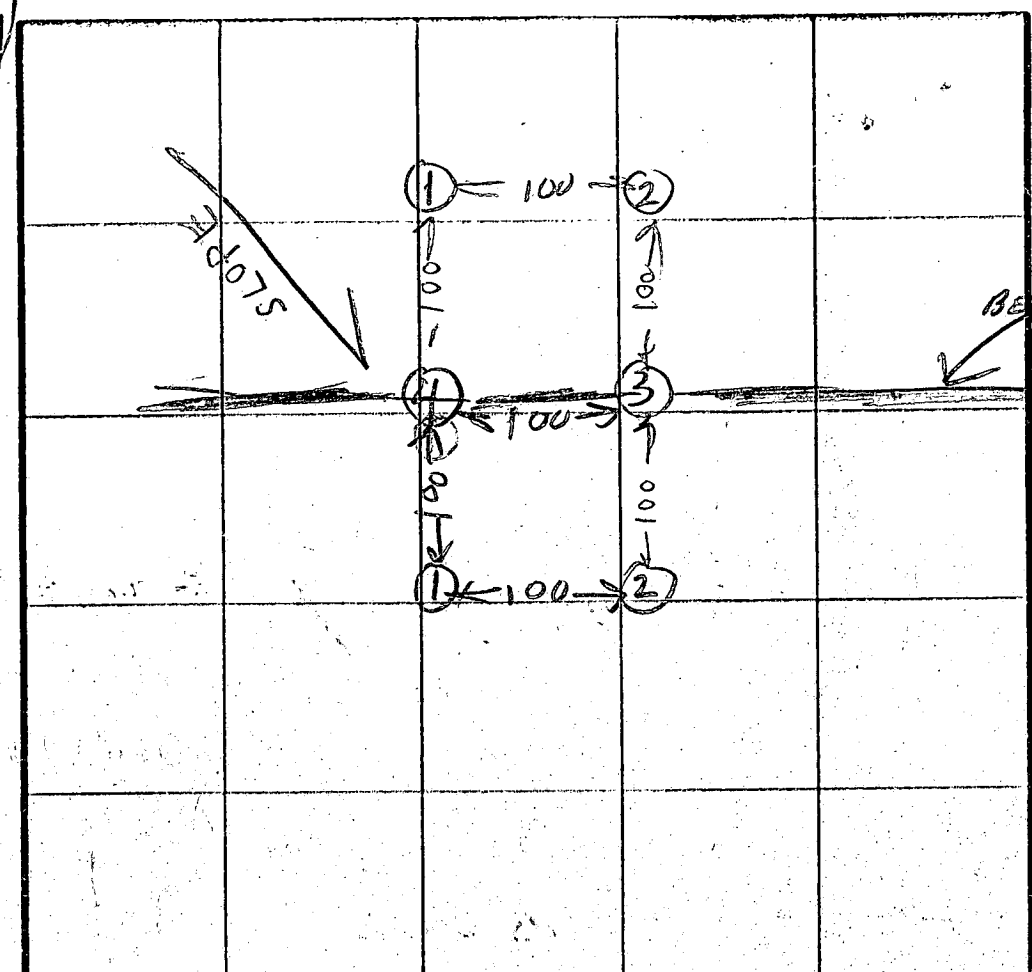

Lot 10

5 Perc 4 min
170 ft
INLET 3'
BOTTOM 7'
180 sqft/hd/m

INDICATE NORTH - NAME ADJOINING ROADWAY AS BASE LINE

LINDEN CIRCLE RD

DATE	TEST NO	DEPTH	PRE-WET		TEST - 1' DROP		TIME
			START	STOP	START	STOP	
1/30/87	1S	4.5	223	224	224	226	2
	1V	12.5	OK				
	2S	5	230	232	232	235	3
	2V	12	OK				
	3S	5	237	239	239	243	4
	3V	12	OK				
	4S	5	240	244	244	250	6
	4V	8.5	240	250	250	300	10
	4V	12 1/2	OK				
		5					

ON LINE HOLES

airline 4 min
may depth 3 ft

REMARKS: Holes dug similar to sketch plan

TYPE OF SOIL

TESTED BY: R HODGES

MARK
CHUCK CROD
2 KETTERMANS
DAVID