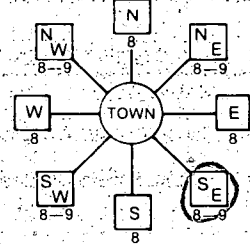
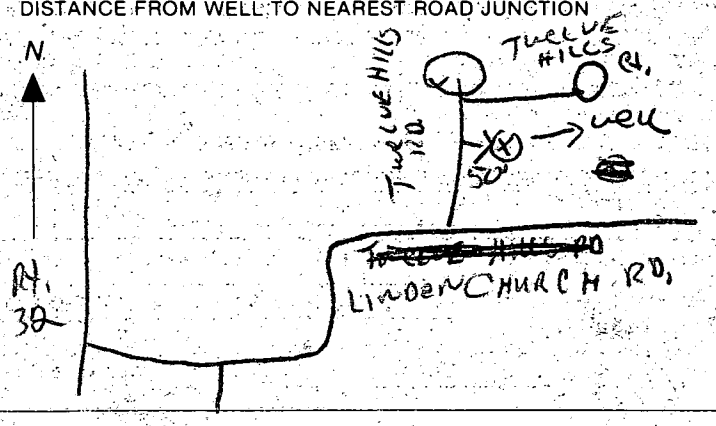


C1 6668		SEQUENCE NO. (DENY USE ONLY)		STATE OF MARYLAND WELL COMPLETION REPORT FILL IN THIS FORM COMPLETELY PLEASE PRINT OR TYPE				THIS REPORT MUST BE SUBMITTED WITHIN 45 DAYS AFTER WELL IS COMPLETED.			
(THIS NUMBER IS TO BE PUNCHED IN COLS. 3-6 ON ALL CARDS)								COUNTY NUMBER A 38571			
DATE Received		DATE WELL COMPLETED		Depth of Well				PERMIT NO. FROM "PERMIT TO DRILL WELL"			
8 13		15 20		22 26 (TO NEAREST FOOT)				28 29 30 31 32 33 34 35 36 37			
OWNER REUER		last name		first name		TOWN		LOT			
STREET OR RFD TWELVE HILLS RD.											
SUBDIVISION TWELVE HILLS SECTION 7								LOT 10			
WELL LOG Not required for driven wells				GROUTING RECORD							
STATE THE KIND OF FORMATIONS PENETRATED, THEIR COLOR, DEPTH, THICKNESS AND IF WATER BEARING				WELL HAS BEEN GROUTED (Circle Appropriate Box) Y N							
DESCRIPTION (Use additional sheets if needed)				TYPE OF GROUTING MATERIAL							
FEET				CEMENT CM BENTONITE CLAY BC							
FROM TO				NO. OF BAGS 8 NO. OF POUNDS 800							
Check if water bearing				GALLONS OF WATER 18							
				DEPTH OF GROUT SEAL (to nearest foot)							
				from 0 ft. to 35 ft.							
				(enter 0 if from surface)							
				CASING RECORD							
				casing types insert appropriate code below							
				ST CO STEEL CONCRETE							
				PL OT PLASTIC OTHER							
				MAIN Casing Nominal diameter Total depth							
				Casing top (main) casing of main casing							
				TYPE (nearest inch) (nearest foot)							
				PL 6 40							
				OTHER CASING (if used)							
				diameter depth (feet)							
				inch from to							
				screen type or open hole							
				insert appropriate code below							
				ST BR HO STEEL BRASS OPEN HOLE							
				PL OT PLASTIC OTHER							
				C2							
				DEPTH (nearest ft.)							
				HO 28 345							
				EACH SCREEN							
				31 32 33 34 35 36 37 38 39 40 41 42 43 44 45 46 47 48 49 50 51							
				SLOT SIZE 1 2 3							
				DIAMETER OF SCREEN (NEAREST INCH)							
				from to							
				GRAVEL PACK							
				IF WELL DRILLED WAS FLOWING WELL INSERT F IN BOX 68							
				OEP USE ONLY (NOT TO BE FILLED IN BY DRILLER)							
				T (E.R.O.S.) WQE							
				70 72 74 75 76							
				TELESCOPE CASING LOG INDICATOR OTHER DATA							
				PUMPING TEST							
				HOURS PUMPED (nearest hour) 6							
				PUMPING RATE (gal. per min. to nearest gal.) 2							
				METHOD USED TO MEASURE PUMPING RATE Bucket							
				WATER LEVEL (distance from land surface)							
				BEFORE PUMPING 35							
				WHEN PUMPING 240							
				TYPE OF PUMP USED (for test)							
				A air P piston T turbine							
				C centrifugal R rotary O other (describe below)							
				J jet S submersible							
				PUMP INSTALLED							
				DRILLER WILL INSTALL PUMP (CIRCLE YES or NO) YES							
				IF DRILLER INSTALLS PUMP THIS SECTION MUST BE COMPLETED FOR ALL WELLS EXCEPT HOME USE							
				TYPE OF PUMP INSTALLED							
				PLACE (A,C,J,P,R,S,T,O) IN BOX - SEE ABOVE: 29							
				CAPACITY: GALLONS PER MINUTE (to nearest gallon) 31 35							
				PUMP HORSE POWER 37 41							
				PUMP COLUMN LENGTH (nearest ft.) 43 47							
				CASING HEIGHT (circle appropriate box and enter casing height)							
				+ above LAND SURFACE 4 (nearest foot)							
				- below							
				LOCATION OF WELL ON LOT							
				SHOW PERMANENT STRUCTURE SUCH AS BUILDING, SEPTIC TANKS, AND/OR LANDMARKS AND INDICATE NOT LESS THAN TWO DISTANCES (MEASUREMENTS TO WELL)							
CIRCLE APPROPRIATE LETTER A WELL WAS ABANDONED AND SEALED WHEN THIS WELL WAS COMPLETED											
E ELECTRIC LOG OBTAINED											
P TEST WELL CONVERTED TO PRODUCTION WELL											
I HEREBY CERTIFY THAT THIS WELL HAS BEEN CONSTRUCTED IN ACCORDANCE WITH COMAR 10.17.13 "WELL CONSTRUCTION" AND IN CONFORMANCE WITH ALL CONDITIONS STATED IN THE ABOVE CAPTIONED PERMIT, AND THAT THE INFORMATION PRESENTED HEREIN IS ACCURATE AND COMPLETE TO THE BEST OF MY KNOWLEDGE.											
DRILLERS IDENT. NO. 003											
DRILLERS SIGNATURE Keith Mays											
(MUST MATCH SIGNATURE ON APPLICATION)											
SITE SUPERVISOR (sign. of driller or journeyman responsible for sitework if different from permittee)											

COUNTY

B 1 3532 (THIS NUMBER IS TO BE PUNCHED IN COLS. 3-6 ON ALL CARDS)	SEQUENCE NO. (DP USE ONLY)	STATE OF MARYLAND PERMIT TO DRILL WELL please print or type	STATE PERMIT NUMBER HO-88-0334 fill in this form completely
Date Received (APA) 112588 8 13		B 3 LOCATION OF WELL HOWARD 8 COUNTY 21 TWELVE HILLS 23 SUBDIVISION 42 SECTION 2 LOT 10 44 46 48 50 DAYTON 52 NEAREST TOWN 71 MILES FROM TOWN (enter 0 if in town) 2 M I 73 76 77 78	
OWNER INFORMATION BAUER BARBARA 15 Last Name 34 8307 MAIN STREET 36 Street or RFD 55 ELLICOTT CITY MD 21043 57 Town 70 State 72 Zip 76		DRILLER INFORMATION Ralph MAYNE Driller's Name 77 License No. 80 Ralph MAYNE well drilling Firm Name 9120 Brown Church Rd Mt Airy Address Ralph Mayne 11/2/88 Signature Date	
B 2 WELL INFORMATION APPROX. PUMPING RATE (GAL. PER MIN.) 5 8 12 AVERAGE DAILY QUANTITY NEEDED 500 (GAL. PER DAY) 14 20		B 4 DIRECTION OF WELL FROM TOWN (CIRCLE BOX)  NEAR WHAT ROAD TWELVE HILLS RD. 11 30 ON WHICH SIDE OF ROAD (CIRCLE APPROPRIATE BOX) NORTH ☒ WEST ☐ EAST ☐ SOUTH ☐ DISTANCE FROM ROAD 50 34 37 ENTER FT or MI FT 38 39	
USE FOR WATER (CIRCLE APPROPRIATE BOX) ☒ HOME (SINGLE OR DOUBLE HOUSEHOLD UNIT ONLY) ☐ FARMING (LIVESTOCK WATERING & AGRICULTURAL IRRIGATION) ☐ INDUSTRIAL, COMMERCIAL, STATE AND FEDERAL GOV. OTHER (REQUIRES APPROPRIATION PERMIT) ☐ PUBLIC OR PRIVATE WATER COMPANY (REQUIRES APPROPRIATION PERMIT AND STATE HEALTH DEPARTMENT APPROVAL) ☐ TEST, OBSERVATION, MONITORING (MAY REQUIRE APPROPRIATION PERMIT)		NOT TO BE FILLED IN BY DRILLER HEALTH DEPARTMENT APPROVAL HOWARD COUNTY NAME A# 38571 COUNTY NO. STATE SIGNATURE _____ INSERT S DATE ISSUED 05-28-88 43 48 CO SIGNATURE EXP. DATE NORTH GRID: 509000 EAST GRID: 081000 50 55 57 63	
APPROXIMATE DEPTH OF WELL 150 FEET 24 28 APPROXIMATE DIAMETER OF WELL 6" NEAREST INCH		SHOW MAJOR FEATURES OF BOX & LOCATE WELL WITH AN X SOURCES OF DRILLING WATER 1. well 2. 3. WRITE THE BOX NUMBER FROM THE MAP HERE E 800 10 N 500 09 000 000	
METHOD OF DRILLING (circle one) BORED (or Augered) JETTED Jetted & DRIVEN 30. AIR ROTary AIR-PERCussion ROTARY (Hydraulic Rotary) 37. CABLE REVERSE-ROTary DRIVE-POINT other _____		DRAW A SKETCH BELOW SHOWING LOCATION OF WELL IN RELATION TO NEARBY TOWNS AND ROADS AND GIVE DISTANCE FROM WELL TO NEAREST ROAD JUNCTION 	
REPLACEMENT OR DEEPEMED WELLS (CIRCLE APPROPRIATE BOX) ☒ THIS WELL WILL NOT REPLACE AN EXISTING WELL ☐ THIS WELL WILL REPLACE A WELL THAT WILL BE ABANDONED AND SEALED 39. ☐ THIS WELL WILL REPLACE A WELL THAT WILL BE USED AS A STANDBY ☐ THIS WELL WILL DEEPEMED AN EXISTING WELL PERMIT NUMBER OF WELL TO BE REPLACED OR DEEPEMED (IF AVAILABLE) _____		Not to be filled in by driller (OEP USE ONLY) APPROP. PERMIT NUMBER _____ 54 63 FORCE ☒ WRITE INITIALS IN BOX PERMIT NO. HO-88-0334 67 68 70 71 72 73 74 75 76 77 78 79	
SPECIAL CONDITIONS			

Page of
Date JAN 3, 1989

Review

FIELD DATA SHEET
HOWARD COUNTY WELL YIELD TEST

Well Permit No. HO - 88-0334
Location of property (road) TWELVE HILLS ROAD
Subdivision TWELVE HILLS Lot 10 Block - Plat - Sec. 2
Well Driller RALPH MAYNE Owner R. BAUER

Depth of well 345'
Distance of measuring point (M.P.) above ground 24'
Static water level (S.W.L.) below M.P. 35'

I. High rate pumping -- reservoir drawdown

Time pump started 8 : 00 Pumping rate 10 G.P.M.
Total time 30 min to reach pumping water level 240 ft. below M.P.

II. Recovery pump test data - observations to be recorded every 15 minutes

TIME (in 15 minute intervals)	WATER LEVEL below M.P.	PUMPING RATE, time to fill 5 gallon bucket	FLOW METER READING (if used)	CALCULATED FLOW (gallons per minute)
8 : 30	240 Ft	30 Sec	N/A	2 G.P.M.
8 : 45	240 Ft	30 sec		2 GPM
9 : 00	240 "	30 Sec		2 "
9 : 15	240 "	30 Sec		2 "
9 : 30	240 Ft	30 Sec		2 GPM
9 : 45	240 Ft	30 Sec		2 GPM
10 : 00	240 "	30 Sec		2 "
10 : 15	240 "	30 Sec		2 "
10 : 30	240 Ft	30 Sec		2 GPM
10 : 45	240 Ft	30 Sec		2 GPM
11 : 00	240 "	30 Sec		2 "
11 : 15	240 "	30 Sec		2 "
11 : 30	240 Ft	30 Sec		2 GPM
11 : 45	240 Ft	30 Sec		2 GPM
12 : 00	240 "	30 Sec		2 "
12 : 15	240 "	30 Sec		2 "
12 : 30	240 Ft	30 Sec		2 GPM
12 : 45	240 Ft	30 Sec		2 GPM
1 : 00	240 "	30 Sec		2 "
1 : 15	240 "	30 Sec		2 "
1 : 30	240 Ft	30 Sec		2 GPM
1 : 45	240 Ft	30 Sec		2 GPM
2 : 00	240 "	30 Sec		2 "
2 : 15	240 "	30 Sec		2 "

HD-224 40 Ft CASING - 8" B&S 350 open
2 : 30 240 Ft 30 Sec

2 GPM

HOWARD COUNTY HEALTH DEPARTMENT
Bureau of Environmental Health
3525-H Ellicott Mills Drive
Ellicott City, MD 21043
461-9933

APPLICATION FOR PITLESS ADAPTER, WELL PUMP AND PRESSURE TANK INSTALLATION

New Installation ☒
Replacement ☐

Receipt #
Date 7/17/89

Name of Installer ROBERT L. FREEZER CO., INC. Telephone 781-4655

License Number 2122
Certified Well Pump Installer ☒ Well Driller ☒ Registered Plumber ☒

Name of Property Owner PRIDEMARK HOMES - YEE Telephone 987-1100
Subdivision 13018 TWELVE HILLS Lot # 10 Well Tag # HO-88-0334
Site Address TWELVE HILLS

Pump
1. Type
a. Deep well jet
b. Shallow well jet
c. Submersible ☒
2. Make DANING (GRISWOLD)
3. Model # 3XLN
4. Capacity 5 GPM
5. Pump exceeds well capacity Yes ☒ No ☐
6. If Yes, is low pressure cutoff switch installed? Yes ☐ No ☒
7. What methods are used to protect the pump and electrical wiring from vibrations? Torque arrestors ☐ Cable guards ☒ Other ☐

Motor
1. Horsepower 1/2
2. RPM 3450
3. Voltage
a. 110
b. 220 ☒

Pitless Adapter
1. Make FLOWMATIC
2. Model #
3. Depth 42" +

Tank CAPTIVE AIR
1. Capacity WX-250
2. Pressure relief valve? YES

Piping
1. Type POLY.
2. Size 1"
3. NSF and/or BOCA Code approved YES
4. Depth of supply line 42" +

Well data
1. Depth 345 ft.
2. Yield 2 GPM
3. Static water level 39 ft.
4. Will water supply be disinfected by installer? YES

I understand that it is my responsibility to notify the Howard County Health Department when the installation is ready for inspection (otherwise this permit is null and void).

All information given above is true to the best of my knowledge.

Signature of Applicant: Robert L. Freezer R.L.F.Co.

Date 7/17/89

Note: A sticker indicating approval/status of the installation will be placed on the well casing at the time of the inspection.