

APPLICATION

PERCOLATION TESTING

A 39913

P _____

HOWARD COUNTY HEALTH DEPARTMENT
BUREAU OF ENVIRONMENTAL HEALTH
P.O. BOX 476 ELLICOTT CITY, MARYLAND 21043
TELEPHONE: 461-9933

9-15-87 Percus OK
pending plat approval JEN

DISTRICT 5TH

DATE 8-19-87

TO: THE COUNTY HEALTH OFFICER
ELLICOTT CITY, MARYLAND

I, HEREBY, APPLY FOR THE NECESSARY TEST IN ORDER TO CONSTRUCT (OR RECONSTRUCT) A SEWAGE DISPOSAL SYSTEM.

PROPERTY OWNER Alfred Bassler Roger D. Marino - 381-5448

ADDRESS 4994 Shepherd Lane PHONE 531-2193

PROSPECTIVE BUYER N/A

ADDRESS _____ PHONE Final 37

PROPERTY LOCATION:

SUBDIVISION Twelve Hills Sec III LOT NO. 21 15 new

ROAD AND DESCRIPTION Linden Church Rd 14004 Twelve Oaks Court

TAX MAP 28 PARCEL # 49

SIZE OF LOT 3 acres TYPE BLDG. SFD
(SINGLE FAMILY DWELLING OR COMMERCIAL)

THE SYSTEM INSTALLED UNDER THIS APPLICATION IS ACCEPTABLE ONLY UNTIL PUBLIC FACILITIES BECOME AVAILABLE. I FULLY UNDERSTAND THE FEE CONNECTED WITH THE FILING OF THIS PERC TEST APPLICATION IS NON-REFUNDABLE UNDER ANY CIRCUMSTANCES. I ALSO AGREE TO COMPLY WITH ALL M.O.S.H.A. REQUIREMENTS IN TESTING THIS LOT.

Mal D. Kinn

(SIGNATURE OF APPLICANT)

APPROVED BY _____ FOR _____ DATE _____

REJECTED BY _____ FOR _____ DATE _____

HOLD PENDING FURTHER TESTS _____ DATE _____

REASONS FOR REJECTION OR HOLDING 9-15-87 for subdivision plat approval and perc
hole location. JEN

BLDG. PERMIT SIGNED
AND RETURNED 9/30/89
Serial 4 28844 - SFD
5 Bedroom


THIS IS NOT A PERMIT

A 39913

(A)

0-6.0 Brown cl
sa silt
6-10.0 Gray-tan
sandy silt
10.0 Bottom

X Perc 3 min
180 Ø 1/2"
INLET 3"
BOTTOM 5"

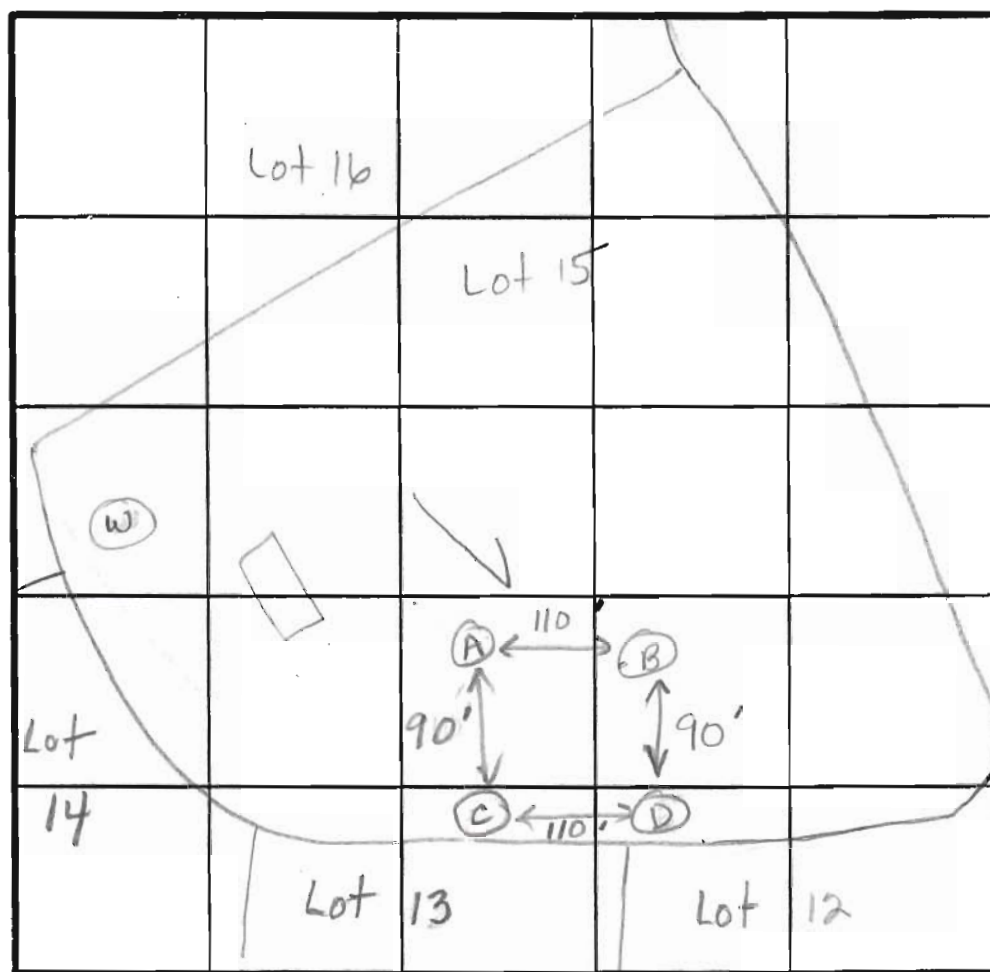

INDICATE NORTH - NAME ADJOINING ROADWAY AS BASE LINE.

DATE	TEST NO.	DEPTH	PRE-WET		TEST - 1" DROP		TIME
			START	STOP	START	STOP	
9-15-85	D	3.0 S	2:18	2:20	2:20	2:22	2
		13.0 D	Bottom (see profile)				
	B	4.0 S	2:23	2:26	2:26	2:31	5
		7.0 M	2:21	2:23	2:23	2:25	2
		10.5 D	Bottom (see profile)				
	C	3.5 S	2:38	2:40	2:40	2:42	2
		10.0 D	Bottom (see profile)				
	A	10.0 V	(see profile) Refusal?				ok

REMARKS

Holes located as shown on plat.

TYPE OF SOIL

0-4' Brown cl sa silt 4'-13' Tan silty sand

TESTED BY

JE Nadeau

ALSO PRESENT

Olen K

(D)

SOIL PROFILE

0-3.0 Brown
cl sa si
3-13.0 Tan si
sand,
trc
broken
rock
≤ 50%
Bottom
13.0

(B)

0-3.0 Brown
cl sa si
3-10.5 Tan sa
silt, little
decomposed
and
broken
rock ≤ 15%
10.5 Bottom

(C)

0-3.0 Br cl si
3.0-10.0 Tan si
sand
10.0 Bottom

EH-12-1079