

DEPARTMENT OF INSPECTIONS, LICENSES AND PERMITS 3430 COURT HOUSE DRIVE ELLICOTT CITY, MD 21043 PERMITS (410) 313-2155 INSPECTIONS (410) 313-1810 AUTOMATED INFORMATION (410) 313-3800		HOWARD COUNTY PERMIT APPLICATION		PERMIT NUMBER 308000043	
Building Address <u>13008 Twelve Trees Ct</u> <u>Clarksville MD 21029</u>			Property Owner's Name <u>Craig Rosenstein</u>		
Suite/Apt. #: _____ SDP/WP/Petition #: _____			Address <u>13008 Twelve Trees Ct</u>		
Census Tract <u>605101</u> Subdivision <u>Twelve Hills</u>			City <u>Clarksville</u> State <u>MD</u> Zip Code <u>21029</u>		
Section _____ Area <u>3.4 AC</u> Lot <u>12</u>			Home Phone <u>301 854 9785</u> Work Phone _____		
Tax Map <u>28</u> Parcel _____ Grid <u>28-16</u>			Applicant's Name & Mailing Address, (if other than stated hereon): _____		
Zoning <u>RR-DEU</u> Map Coordinates _____ Lot size <u>3.4 AC</u>			Phone _____ Fax _____		
Existing Use <u>Single Family Dwelling</u>			Contractor Company <u>Fred C Dickson CORP</u>		
Proposed Use <u>Single Family Dwelling</u>			Contact Person <u>Fred Dickson</u>		
Estimated Construction Cost \$ <u>50,000</u>			Address <u>4593 Ridge Rd</u>		
Description of Work <u>ADD LAUNDRY RM ON CRAWL SPACE AND ATTACHED ONE CAR GARAGE (12'X 24')</u>			City <u>Mt Airy</u> State <u>MD</u> Zip Code <u>21771</u>		
Occupant or Tenant <u>Craig Rosenstein</u>			License No. <u>08050122391</u>		
Contact Name <u>Craig Rosenstien</u>			Phone <u>(410) 875-2115</u> Fax _____		
Address <u>SAME AS ABOVE</u>			Engineer or Architect Company _____		
City _____ State _____ Zip Code _____			Contact Person _____		
Phone <u>301 854 9785</u> Fax _____			Address _____		
			City _____ State _____ Zip Code _____		
			Phone _____ Fax _____		

BUILDING DESCRIPTION - COMMERCIAL		BUILDING DESCRIPTION - RESIDENTIAL	
Building Characteristics	Utilities	Building Characteristics	Utilities
Height: _____	Water Supply: _____ Public _____ Private _____	SF Dwelling ☐ SF Townhouse ☐ Depth _____ Width _____	Water Supply: _____ Public _____ Private ☒
No. of stories: _____	Sewage Disposal: _____ Public _____ Private _____	1st floor: _____	Sewage Disposal: _____ Public _____ Private ☒
Gross area, sq. ft. per floor: _____	Electric Yes ☐ No ☐ Gas Yes ☐ No ☐	2nd floor: _____	Electric Yes ☐ No ☐ Gas Yes ☐ No ☐
Use group: _____	Heating System: _____ Electric ☐ Oil ☐ Natural Gas ☐ Propane Gas ☐	Basement: _____	Heating System: _____ Electric ☐ Oil ☐ Natural Gas ☐ Propane Gas ☐
Construction type: _____ Reinforced Concrete _____ Structural Steel _____ Masonry _____ Wood Frame _____	Sprinkler system: N/A ☐ Full _____ Partial _____ Other Suppression _____ # of Heads _____	Finished Basement ☐ Unfinished Basement ☐ Crawl space ☐ Slab on Grade ☐ No. of Bedrooms _____ Height: _____ Multi-family dwellings: _____ No. of efficiency units: _____ No. of 1 BR units: _____ No. of 2 BR units: _____ No. of 3 BR units: _____	Sprinkler system: N/A ☐ NFPA #13D _____ NFPA #13R _____ Other: _____
_____ State Certified Modular		Other Structure: _____ Dimensions: _____ Footings: _____ Roof Height: _____ _____ State Certified Modular _____ Manufactured Home	

THE UNDERSIGNED HEREBY CERTIFIES AND AGREES AS FOLLOWS: (1) THAT HE/SHE IS AUTHORIZED TO MAKE THIS APPLICATION; (2) THAT THE INFORMATION IS CORRECT; (3) THAT HE/SHE WILL COMPLY WITH ALL REGULATIONS OF HOWARD COUNTY WHICH ARE APPLICABLE THERETO; (4) THAT HE/SHE WILL PERFORM NO WORK ON THE ABOVE REFERENCED PROPERTY NOT SPECIFICALLY DESCRIBED IN THIS APPLICATION; (5) THAT HE/SHE GRANTS COUNTY OFFICIALS THE RIGHT TO ENTER ONTO THIS PROPERTY FOR THE PURPOSE OF INSPECTING THE WORK PERMITTED AND POSTING NOTICES.

[Signature]
Applicant's Signature

FRED DICKSON
Print Name

Title/Company

Date

Checks payable to: **DIRECTOR OF FINANCE OF HOWARD COUNTY**
** PLEASE WRITE NEATLY AND LEGIBLY. **
- FOR OFFICE USE ONLY -

AGENCY	DATE	SIGNATURE APPROVAL
Land Development, DPZ		
State Highways		
Building Official		
Dev. Engineering, DPZ		
Health	<u>1/17/08</u>	<u>[Signature]</u>
Fire Protection		

Is Sediment Control approval required prior to issuance?
YES ☐ NO ☐

CONTINGENCY CONSTRUCTION START: ☐
ONE STOP SHOP: ☐

Distribution of Copies: _____
T: Home PERMIT FRM

DPZ SETBACK INFORMATION		PROPERTY ID#
Front: _____	Filing fee	\$ _____
Rear: _____	Permit fee	\$ _____
Side: _____	Excise tax	\$ _____
Side St.: _____	Add'l per. fee	\$ _____
All minimum setbacks met?	TOTAL FEES	\$ _____
YES ☐ NO ☐	Sub-total paid	\$ _____
Is Entrance Permit required?	Balance due	\$ _____
YES ☐ NO ☐	Check	\$ _____
Historic District?	Validation	\$ _____
YES ☐ NO ☐		
Lot Coverage for NewTown Zone		
SDP/Red-line approval date	Accepted by	
Yellow: DED, DPZ	Pink: Health	Gold: SHA

WALK-THRU BUILDING PERMIT

BP# 008000043 A# 38570

APP. SAN. GAC DATE: 11/17/08

DESC. OF WORK: GARAGE/LAUNDRY Room

GAS LINE EASEMENT

~~Septic Easement~~

~~3.247 Acres~~

EXISTING HOUSE

Dec

Porch

+

Garage Addition

30' BRL

7

53

○ Wall

TWELVE TREES
COURT

LOT 12
"TWELVE HILLS"
SEC 2
5th ELECTION DISTRICT
HOWARD COUNTY, MD
Tax Map 28 RR Zoning
PLAT REFERENCE 1430

SCALE 1" =

PAGE
1 OF 1

DATE: 12.11.07
REVISION:

SCALE: 1" = 100'

13008 TWELVE TREES CT.

ROSENSTEIN
SITE PLAN

FRED C. DICKSON CO., INC.
 P.O. BOX 718 MT. AIRY, MD 21781
 TEL: 410-326-4001 FAX: 410-326-4002
 WWW.FCDICKSON.COM

DEPARTMENT OF INSPECTIONS, LICENSES AND PERMITS 3400 COURT HOUSE DRIVE ELLICOTT CITY, MD 21045 (TELEPHONE) (410) 313-2559 (FAX) (410) 313-1810 AUTOMATED INFORMATION (410) 313-3800		HOWARD COUNTY PERMIT APPLICATION	PERMIT NUMBER B0800043
Building Address <u>13008 Twelve Trees Ct</u> <u>Clarksville MD</u>		Property Owner's Name <u>Ann & Craig Rosenstein</u> Address <u>13008 Twelve Trees Ct</u>	
Suite/Apt. #: _____ SDP/WP/Petition #: _____		City <u>Clarksville</u> State <u>MD</u> Zip Code _____	
Census Tract _____ Subdivision <u>Twelve Hills</u>		Home Phone <u>(301) 854-9785</u> Work Phone <u>(301) 884-4206</u>	
Section _____ Area _____ Lot <u>12</u>		Applicant's Name & Mailing Address, (if other than stated herein): _____	
Tax Map <u>28</u> Parcel _____ Grid _____		Phone <u>301 854 9785</u> Fax _____	
Zoning <u>RR</u> Map Coordinates _____ Lot size <u>3.25 ac</u>		Contractor Company <u>Fred C. Dickson Co Inc</u>	
Existing Use <u>Single Family Dwelling</u>		Contact Person <u>Fred Dickson</u>	
Proposed Use <u>Single Family Dwelling</u>		Address <u>4513 Rock Rd</u>	
Estimated Construction Cost \$ <u>820,000</u>		City <u>MT Air</u> State <u>MD</u> Zip Code <u>21271</u>	
Description of Work <u>Extend rear of house 8'</u> <u>Rebuild EXISTING Screened Porch moved</u> <u>8'</u>		License No <u>08016087576</u>	
Occupant or Tenant _____		Phone <u>(410) 875-2115</u> Fax <u>(410) 866-8836</u>	
Contact Name _____		Engineer or Architect Company _____	
Address _____		Contact Person <u>N/A</u>	
City _____ State _____ Zip Code _____		Address _____	
Phone _____ Fax _____		City _____ State _____ Zip Code _____	
Phone _____ Fax _____		Phone _____ Fax _____	

THE UNDERSIGNED HEREBY CERTIFIES AND AGREES AS FOLLOWS: (1) THAT HE/SHE IS AUTHORIZED TO MAKE THIS APPLICATION; (2) THAT THE INFORMATION IS CORRECT; (3) THAT HE/SHE WILL COMPLY WITH ALL REGULATIONS OF HOWARD COUNTY WHICH ARE APPLICABLE THERETO; (4) THAT HE/SHE WILL PERFORM NO WORK ON THE ABOVE REFERENCED PROPERTY NOT SPECIFICALLY DESCRIBED IN THIS APPLICATION; (5) THAT HE/SHE GRANTS COUNTY OFFICIALS THE RIGHT TO ENTER ONTO THIS PROPERTY FOR THE PURPOSE OF INSPECTING THE WORK PERMITTED AND POSTING NOTICES.


 Applicant's Signature
 Fred C Dickson Colne
 Title/Company

Print Name Fred Dickson

Date 01/09/08

Checks payable to: **DIRECTOR OF FINANCE OF HOWARD COUNTY**
 ** PLEASE WRITE NEATLY AND LEGIBLY. **
 - **FOR OFFICE USE ONLY** -

AGENCY DATE SIGNATURE APPROVAL

Land Development, DPZ

State Highways

Building Official

Dev. Engineering, DPZ

Health 1-9-08 *[Signature]*

Fire Protection

Is Sediment Control approval required prior to issuance?

YES ☐ NO ☐

CONTINGENCY CONSTRUCTION START: ☐

ONE STOP SHOP: ☐


<u>DPZ SETBACK INFORMATION</u>		<u>PROPERTY INFO</u>
Front: _____	Filing fee	\$ _____
Rear: _____	Permit fee	\$ _____
Side: _____	Excise tax	\$ _____
Side St.: _____	Add'l per. fee	\$ _____
All minimum setbacks met?	TOTAL FEES	\$ _____
YES ☐ NO ☐	Sub-total paid	\$ _____
Is Entrance Permit required?	Balance due	\$ _____
YES ☐ NO ☐	Check	# _____
Historic District?	Validation	# _____
YES ☐ NO ☐		
Lot Coverage for New Town Zone _____		
SDP/Red-line approval date _____		Accepted by _____

Distribution of Copies: White: Building Official Green: LDD, DPZ
T-1000/PERMIT FRM

Yellow: DED, DPZ Pink: Health Gold: SHA

Accepted by _____

Rev. 11/4/04

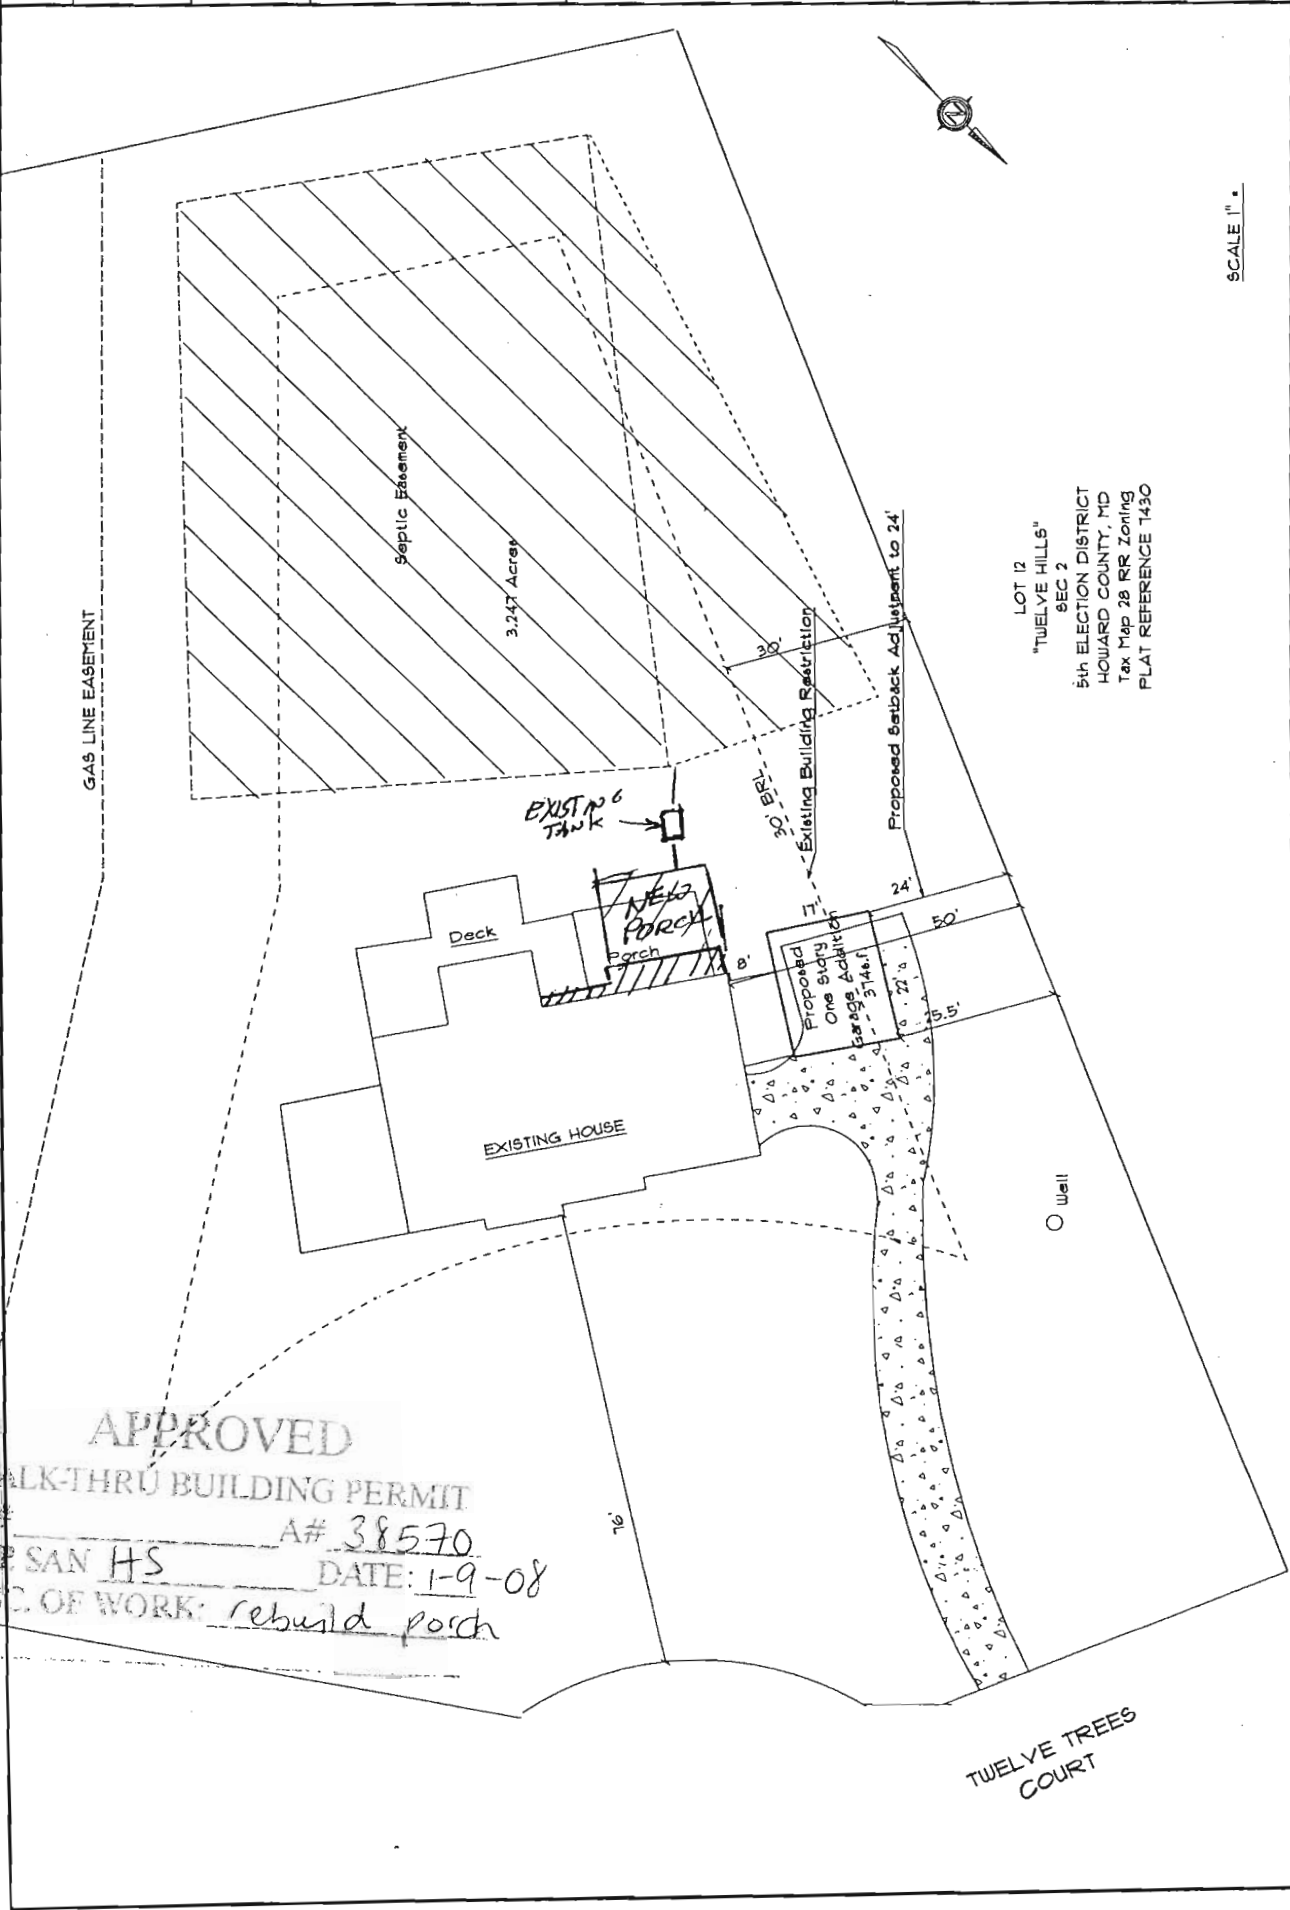


APPROVED
 WALK-THRU BUILDING PERMIT
 BP# _____ A# 38570
 APP SAN HS DATE: 1-9-08
 DESC. OF WORK: rebuild porch

SCALE 1" = 100'

IN PLAN.
SIZE THE SITE.
SECTION IS GRANTED FROM
VE SEDIMENT CONTROLS
AREAS.

REDISTURBED
ING
/1000 SQ. FT.)
UGUST
R ANNUAL
1 AUGUST 14.
BS/1000SQ.FT.).
TECT SITE BY
W MULCH AND
50D.
10 SQ.FT.)
SEEDING
MULCH
1000 SQ.FT.)
FEET OR HIGHER,
ANCHORING.
ICATION FOR SOIL
DDS NOT COVERED.

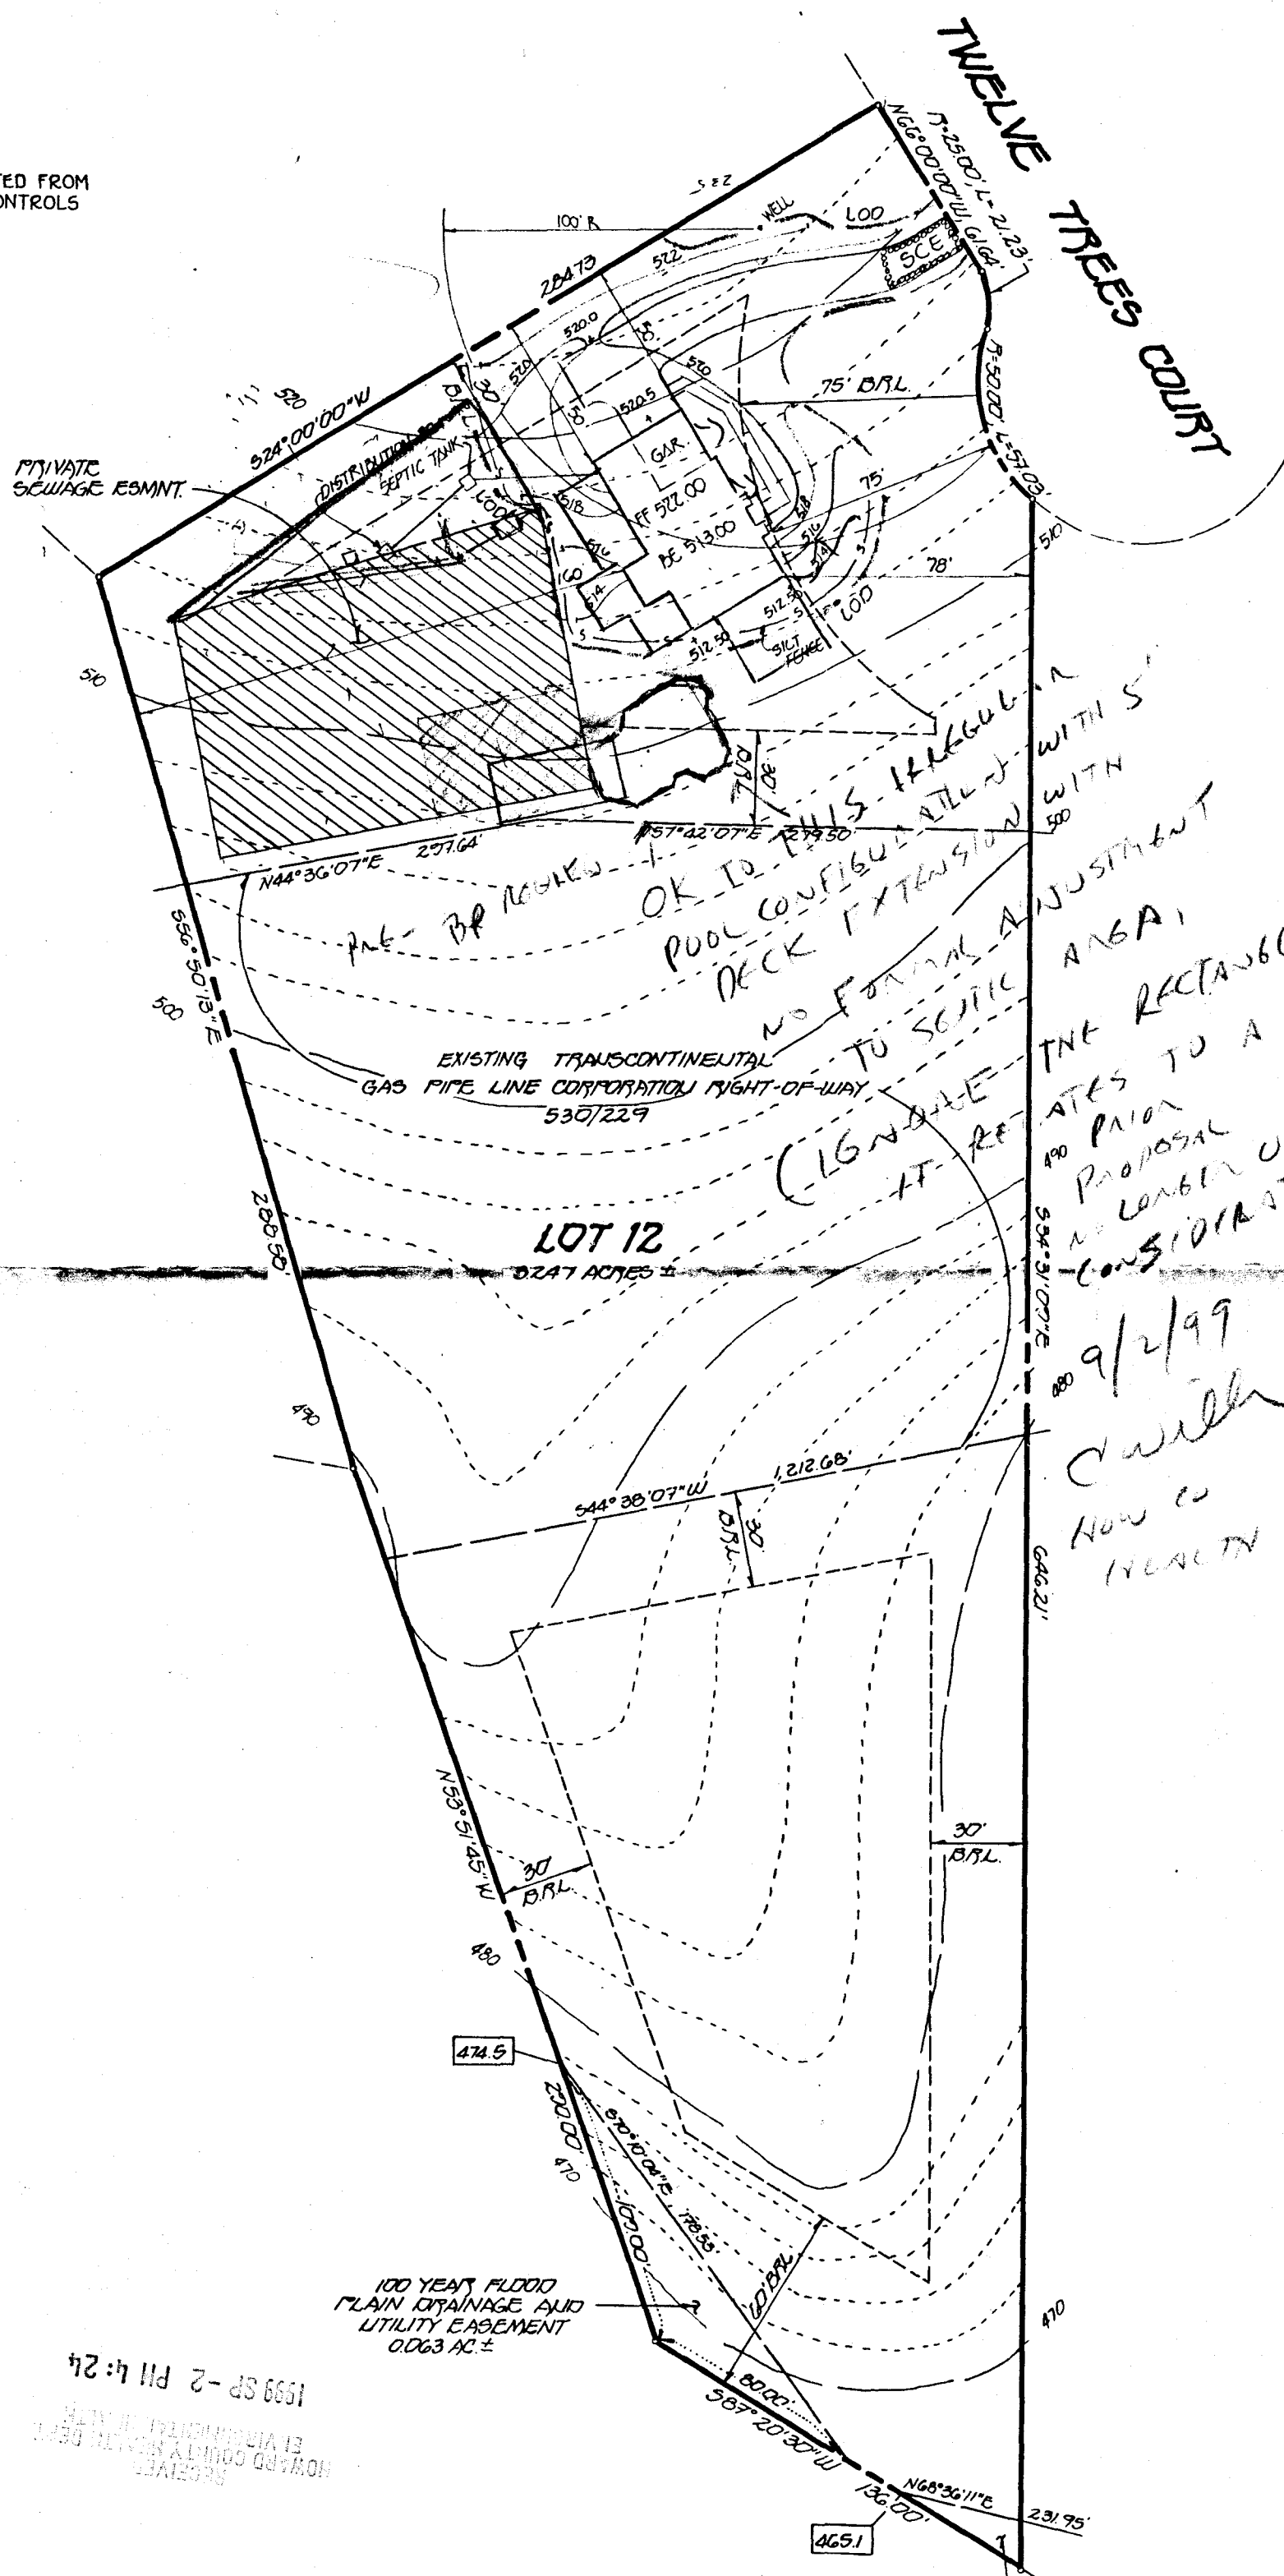

GENERAL NOTES

1. SEPTIC EASEMENT SUBJECT
2. PROPOSED 1500 GALLON SE
3. A. FIRST FLOOR ELEVATION
B. BASEMENT ELEVATION:
C. INVERT OF SEPTIC SYST
D. INVERT IN AT SEPTIC T
E. INVERT OUT AT SEPTIC
F. PROPOSED GRADE OVER
G. INVERT AT DISTRIBUTION
H. EXISTING GROUND OVER
I. LENGTH OF TRENCH TO BE
ISSUANCE.
J. CONTRACTOR / BUILDER TO
ANY CONSTRUCTION.
6. THERE IS NO BASEMENT SE
7. MANHOLE CLEAN
SEPTIC TANK

Approved Septic System
Howard County Health

9/2/99
C. Miller
HOW CO
HEALTH

Amy McMillan
Signature



1999 SP-2 PH 4:24
HOWARD COUNTY HEALTH DEPT
RECEIVED

PLOT PA
TO ACCOMPANY APP
BUILDING PA
TWELVE
SECTION TWO
LOT 12
TAX MAP 2B PART C

IN PLAN.

SIZE THE SITE.

SSION IS GRANTED FROM
VE SEDIMENT CONTROLS
AREAS.

REDISTURBED

ING

/1000 SQ. FT.)

UGUST
R ANNUAL
1 AUGUST 14,
BS/1000SQ.FT.),
OTECT SITE BY
W MULCH AND
SOD.

10 SQ.FT.)
SEEDING
MULCH
1000 SQ.FT.)
FEET OR HIGHER,
ANCHORING

ICATION FOR SOIL
SODS NOT COVERED.

PRIVATE
SEWAGE ESMNT.

DISTRIBUTION
SEPTIC TANK

GAR.

FF 512.00

BE 513.00

512.50

512.50

TWELVE

TREES

COUNT

EXISTING TRANSCONTINENTAL
GAS PIPE LINE CORPORATION RIGHT-OF-WAY
530/229

LOT 12

3247 ACRES ±

BOO120412
POOL OK
WITH LIMITED
INTERUSION
TO SEPTIC AREA
566 MAKE-UP AREA
ON HIGH SIDE OF
PLATTED EASEMENT

9/18/99

C. W. L.

OK TO THIS ALLEGED
POOL CONFIGURATION WITH
DECK FITTING WITH
NO FORMAL ADJUSTMENT
TO SEPTIC AREA
(CLOSE-UP REF. THE REF
AFTER PROPOSED
CONSTRUCTION
9/14/99
C. W. L.
H. W. L.
1/1/00

DEPARTMENT OF INSPECTIONS, LICENSES AND PERMITS 3430 COURT HOUSE DRIVE ELLICOTT CITY, MD 21043 PERMITS (410) 313-2455 INSPECTIONS (410) 313-1810 AUTOMATED INFORMATION (410) 313-3800	HOWARD COUNTY PERMIT APPLICATION	PERMIT NUMBER B00121063
---	--	---

Building Address <u>13008 Twelve Trees Ct.</u> <u>Chicksville MD 21029</u> Suite/Apt. #: _____ SDP/WP/Petition #: _____ Census Tract <u>60051.01</u> Subdivision <u>Twelve Hills</u> Section <u>2</u> Area _____ Lot <u>12</u> Tax Map <u>28</u> Parcel <u>331</u> Grid <u>16</u> Zoning <u>R1</u> Map Coordinates <u>11B2</u> Lot size _____ Existing Use _____ Proposed Use _____ Estimated Construction Cost \$ <u>163,000.00</u> Description of Work <u>build 1 story sunroom addition</u> <u>off side of existing home - post & pier.</u> <u>finish basement to make fun room</u> Occupant or Tenant _____ Contact Name _____ Address _____ City _____ State _____ Zip Code _____ Phone _____ Fax _____	Property Owner's Name <u>Craig & Anne Rosenstein</u> Address <u>13008 Twelve Trees Ct.</u> City <u>Chicksville</u> State <u>MD</u> Zip Code <u>21029</u> Home Phone <u>301 951 4775</u> Work Phone _____ Applicant's Name & Mailing Address, (if other than stated hereon): _____ Phone _____ Fax _____ Contractor Company _____ Contact Person <u>Both</u> Address _____ City _____ State _____ Zip Code _____ License No. _____ Phone _____ Fax _____ Engineer or Architect Company _____ Contact Person _____ Address _____ City _____ State _____ Zip Code _____ Phone _____ Fax _____
---	---

BUILDING DESCRIPTION - <u>COMMERCIAL</u>		BUILDING DESCRIPTION - <u>RESIDENTIAL</u>	
Building Characteristics Height: _____ No. of stories: _____ Gross area, sq. ft. per floor: _____ Use group: _____ Construction type: ☐ Reinforced Concrete ☐ Structural Steel ☐ Masonry ☐ Wood Frame ☐ State Certified Modular	Utilities Water Supply: ☐ Public ☐ Private Sewage Disposal: ☐ Public ☐ Private Electric Yes ☐ No ☐ Gas Yes ☐ No ☐ Heating System: ☐ Electric ☐ Oil ☐ ☐ Natural Gas ☐ Propane Gas ☐ Sprinkler system: N/A ☐ ☐ Full ☐ Partial ☐ Other Suppression ☐ # of Heads _____	Building Characteristics SF Dwelling ☐ SF Townhouse ☐ 1st floor: <u>24</u> <u>34</u> 2nd floor: _____ Basement: _____ Finished Basement ☐ Unfinished Basement ☐ Crawl space ☐ Slab on Grade ☐ No. of Bedrooms: _____ Multi-family dwellings: No. of efficiency units: _____ No. of 1 BR units: _____ No. of 2 BR units: _____ No. of 3 BR units: _____ Other Structure: _____ Dimensions: <u>5' x 10'</u> Footings: _____ Roof: _____ ☐ State Certified Modular ☐ Manufactured Home	Utilities Water Supply: ☐ Public ☐ Private Sewage Disposal: ☐ Public ☐ Private Electric Yes ☐ No ☐ Gas Yes ☐ No ☐ Heating System: ☐ Electric ☐ Oil ☐ ☐ Natural Gas ☐ Propane Gas ☐ Sprinkler system: N/A ☐ ☐ NFPA #13D ☐ NFPA #13R ☐ Other: _____

THE UNDERSIGNED HEREBY CERTIFIES AND AGREES AS FOLLOWS: (1) THAT HE/SHE IS AUTHORIZED TO MAKE THIS APPLICATION; (2) THAT THE INFORMATION IS CORRECT; (3) THAT HE/SHE WILL COMPLY WITH ALL REGULATIONS OF HOWARD COUNTY WHICH ARE APPLICABLE THEREIN; (4) THAT HE/SHE WILL PERFORM NO WORK ON THE ABOVE REFERENCED PROPERTY NOT SPECIFICALLY DESCRIBED IN THIS APPLICATION; (5) THAT HE/SHE GRANTS COUNTY OFFICIALS THE RIGHT TO ENTER ONTO THIS PROPERTY FOR THE PURPOSE OF INSPECTING THE WORK PERMITTED AND POSTING NOTICES.

<u>Betty L. Wacklenant</u> Applicant's Signature <u>Starcom Design Build</u> Title/Company	<u>Betty L. Wacklenant</u> Print Name <u>10-27-99</u> Date
---	---

Checks payable to: DIRECTOR OF FINANCE OF HOWARD COUNTY
 ** PLEASE WRITE NEATLY AND LEGIBLY. **
 - FOR OFFICE USE ONLY -

AGENCY ☒ Land Development DPZ ☐ State Highways ☐ Building Official ☒ Dev. Engineering DPZ ☐ Health ☐ Fire Protection Is Sediment Control approval required prior to issuance? YES ☐ NO ☐	SIGNATURE APPROVAL <u>10/27/99</u> <u>Mark E. [Signature]</u> CONTINGENCY CONSTRUCTION START: ☐ ONE STOP SHOP: ☐	DPZ SETBACK INFORMATION Front: _____ Rear: _____ Side: _____ Side St: _____ All minimum setbacks met? YES ☐ NO ☐ Is Entrance Permit required? YES ☐ NO ☐ Historic District? YES ☐ NO ☐ Lot Coverage for NewTown Zone _____ SDP/Red-line approval date _____ Accepted by _____	PROPERTY ID# <u>20713</u> Filing fee \$ _____ Permit fee \$ _____ Excise tax \$ _____ Sub-total paid \$ _____ Add'l permit fee \$ _____ TOTAL FEES \$ _____ Balance due \$ _____ Check # <u>11066</u> Validation # _____
---	---	--	---

Distribution of Copies-

White: Building Official

Green: LDD, DPZ

Yellow: DED, DPZ

Pink: Health

Gold: SHA

TWELVE TREES COURT

SUNROOM OK
MR 10/27/99WELL
36 BRL

SEPTIC TANK

Proposed
New
Sunroom

36 BRL

TRANS CONTINENTAL
GAS PIPE LINE

LOT E 12

ANN & CRAIG ROSENSTEIN RESIDENCE
LOT 12 SECTION A7530 13009 TWELVE TR
TWELVE HILLS
SCALE 1"=100'0"

13009 TWELVE TR
CLARKSVILLE W

