

APPLICATION

PERCOLATION TESTING

A 38570

P _____

HOWARD COUNTY HEALTH DEPARTMENT
BUREAU OF ENVIRONMENTAL HEALTH
P.O. BOX 476 ELLICOTT CITY, MARYLAND 21043
TELEPHONE: 461-9933

DISTRICT 5

DATE 12/17/86

TO: THE COUNTY HEALTH OFFICER
ELLICOTT CITY, MARYLAND

I, HEREBY, APPLY FOR THE NECESSARY TEST IN ORDER TO CONSTRUCT (OR RECONSTRUCT) A SEWAGE DISPOSAL SYSTEM.

PROPERTY OWNER ~~Attogether Limited Partnership~~ ^{CRAIG A & ANNE M. ROSENSTEIN} ~~Indemount~~
ADDRESS 10176 Baltimore National Pike Suite 210 PHONE 487-1100
465-5855

PROSPECTIVE BUYER _____

ADDRESS _____ PHONE final lot 12 sec 2

PROPERTY LOCATION: NEW 13 (april 87)

SUBDIVISION Attogether Twelve Hills Sec. 2 LOT NO. 12

ROAD AND DESCRIPTION Linden Church Rd + Rt 32 13008 Twelve Hills Rd.

TAX MAP 28 PARCEL # 66

SIZE OF LOT 5 acres TYPE BLDG. SFD - 4Bm 59342
(SINGLE FAMILY DWELLING OR COMMERCIAL)

THE SYSTEM INSTALLED UNDER THIS APPLICATION IS ACCEPTABLE ONLY UNTIL PUBLIC FACILITIES BECOME AVAILABLE. I FULLY UNDERSTAND THE

FEE CONNECTED WITH THE FILING OF THIS PERC TEST APPLICATION IS NON-REFUNDABLE UNDER ANY CIRCUMSTANCES. I ALSO AGREE TO COMPLY

WITH ALL M.O.S.H.A. REQUIREMENTS IN TESTING THIS LOT. M. J. Rein
(SIGNATURE OF APPLICANT)

APPROVED BY Sidney Abel FOR Deputy Health DATE 6-18-89

REJECTED BY _____ FOR _____ DATE _____

HOLD PENDING FURTHER TESTS _____ DATE _____

REASONS FOR REJECTION OR HOLDING 2/17/87 - Per OK / Hold for Plat P17

BLDG. PERMIT SIGNED

AND RETURNED 4/25/92

Serial # 43187 - SFD - 4 Bedroom

BLDG. PERMIT SIGNED

AND RETURNED 6-19-89

BP 27015 gsk


THIS IS NOT A PERMIT

GRAY
BROWN
SAND
MICA
LUM

GRAY
BROWN
SAND
LURN

GRAY
BANK
SAND
MICH
LOAN

GRAT
GROWN
SERIAL
IN KCP
LON

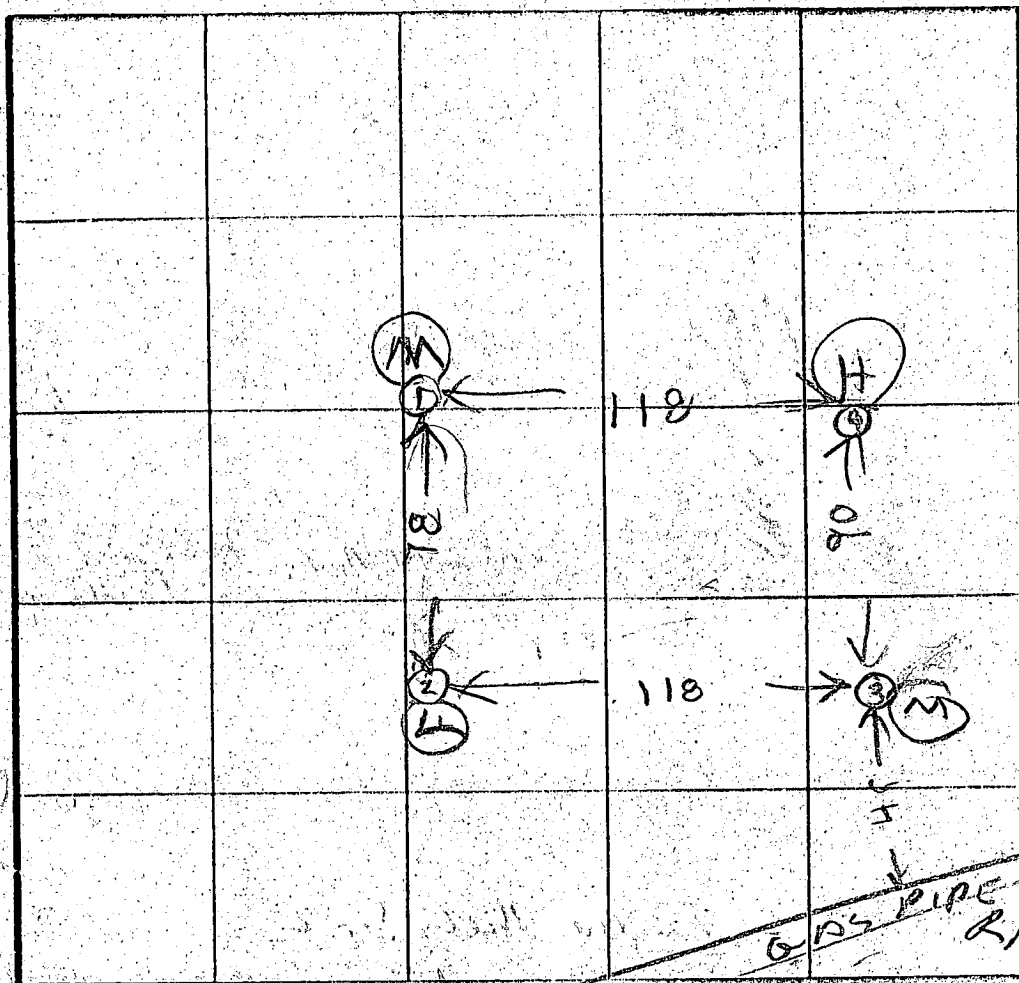

INDICATE NORTH NAME ADJOINING ROAD/VAY AS BASE LINE

[illegible]

av
Time
2 min
max
Depth
3 ft

REMARKS

TYPE OF SOIL

TESTED BY

Notes Day Per Plant

R HODGES

OKETTER in a
CLINT

ALSO PRESENT