

05-407141

P 50728

**A** 38570

## DISTRICT 5th

DATE 6-7-95

**DATE SYSTEM APPROVED** 8/9/95

~~X761X9913X~~ 313-2640

INSPECTOR *DICKS*

INDEXED

South Carroll Backhoe, Inc.

IS PERMITTED TO INSTALL ☒ ALTER

ADDRESS 4410 Salem Bottom Road, Westminster, Maryland 21157 PHONE 875-4197

SUBDIVISION Twelve Hills, Sec. 2 LOT 12 ROAD 13008 Twelve Trees Court

PROPERTY OWNER Craig A & Anne Rosenstein

**ADDRESS**

SEPTIC TANK CAPACITY: 1250 GALLONS

NUMBER OF BEDROOMS 4

180 SQUARE FEET PER BEDROOM

LINEAR FEET OF TRENCH REQUIRED 144

TRENCHES - Trench to be 2 feet wide. Inlet 3.5 feet below original grade. Bottom maximum depth 8.5 feet below original grade. Effective area begins at 3.5 feet below original grade. 5 feet of stone below distribution pipe.

LOCATION - Place distribution box 205 feet up the right lot line (284.73) and 35 feet off that same lot line as seen when facing the lot from Twelve Trees Court. Run trenches on contour in both directions.

NOTES - No trench to exceed 100 feet in length. Provide 6" - 8" diameter cleanout and cap to grade or above on septic tank. *OK PER 5-25-95*

22. PERMIT SIGNATURE

~~AND~~ RETURNED 10-22-94

PLANS APPROVED BY \_\_\_\_\_ Amy McMillen

DATE 05/02/95

**COVER NO WORK UNTIL INSPECTED AND APPROVED**

NEITHER THE HOWARD COUNTY COUNCIL NOR THE HEALTH DEPARTMENT IS RESPONSIBLE FOR THE SUCCESSFUL OPERATION OF ANY SYSTEM

**NOTE: CLEANOUT REQUIRED EVERY 70 FEET OF SEWER LINE AND/OR AT 90° SWEEPS IN LINES FROM HOUSE TO DRAIN FIELDS, 90° ELBOWS NOT ACCEPTABLE**

**NOTE: ALL PARTS OF SEPTIC SYSTEMS (I.E. TANK, DISTRIBUTION BOX TRENCHES) TO BE 100 FEET FROM WELL (UNLESS OTHERWISE SPECIFICALLY AUTHORIZED)**

**NOTE: IF DEEP TRENCH(ES) ARE USED CALL FOR INSPECTION BEFORE AND AFTER PLACING GRAVEL IN TRENCH(ES)**

**NOTE: NO DRY WELL SHALL EXCEED 15 FOOT IN DIAMETER NO ABSORPTION TRENCH TO EXCEED 100 FEET IN LENGTH**

**NOTE: ALL PIPE FROM HOUSE TO SEPTIC TANK MUST BE CAST IRON OR SCHEDULE 35/40 PVC OR ABS**

PERMIT VOID AFTER TWO YEARS

**NOTE: INSTALL STAND PIPE ON SEPTIC TANK AND DRY WELL STAND PIPES MUST BE 6 INCHES IN DIAMETER CAST IRON. CONCRETE OR TERRA COTTA OR PVA OR ABS ACCEPTED. IF TOP OF SEPTIC TANK IS DEEPER THAN 3 FEET, MANHOLE TO GRADE REQUIRED.**

**NOTE: DISTRIBUTION BOXES MUST HAVE BAFFLES**


**\*INSTALLER IS RESPONSIBLE FOR OBTAINING FINAL APPROVAL ON THIS PERMIT**

**HD-260(6-90)**

**\*CALL 461-9933 FOR INSPECTION OF SEPTIC SYSTEM.**

Add. Con-Deck  
 BLDG. PERMIT SIGNED  
 AND RETURNED 6-5-96.  
 Serial # B00100447

38570 A

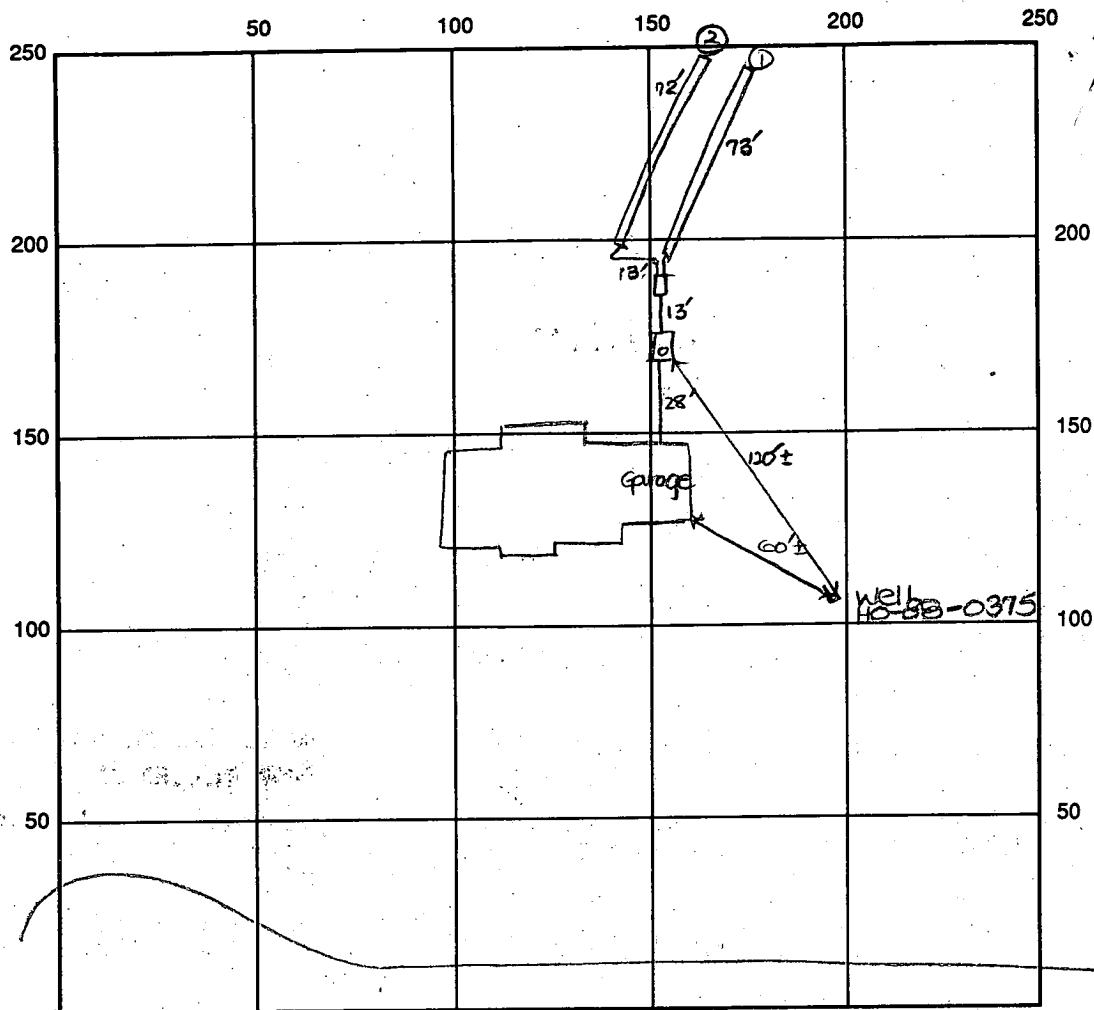

INDICATE NORTH - NAME ADJOINING ROADWAY AS BASE LINE

Twelve Trees Court

SEPTIC TANK LEVEL OK-1250 gal

CLEANOUTS one on s.t.

DISTRIBUTION BOX LEVEL OK-baffle in

DRAIN FIELD/TITLE DEPTH 3.5 FT.

TRENCH WIDTH 2 FT.

INLET DEPTH 3.5 FT.

EFFECTIVE GRAVEL DEPTH 5 FT.

TOTAL LENGTH (1) 73'  
(2) 72' FT.

NUMBER OF TRENCHES 2

ONE SIDEWALL/ ~~BOTTOM~~ AREA 725 SQ. FT.

DRYWALL INSIDE DIAMETER — FT.

EFFECTIVE DEPTH BELOW INLET — FT.

ABSORBENT AREA 725 SQ. FT.

REMARKS:

8/9/95 Final - OK to cover all work. DKS

DATE SYSTEM APPROVED

8/9/95

INSPECTOR

Donald K. See

LS AS SHOWN ON PLAN.

JING AND STABILIZE THE SITE.

IZED AND PERMISSION IS GRANTED FROM  
ISPECTOR, REMOVE SEDIMENT CONTROLS  
NING DISTURBED AREAS.

AREAS LIKELY TO BE REDISTURBED  
VE COVER IS NEEDED.

F SOIL BY RAKING, DISCING  
BEFORE SEEDING.

3-10 FERTILIZER (14 LBS./1000 SQ. FT.)

ROUGH APRIL 30, AND AUGUST  
3 WITH 1 1/2 BUSHEL PER ANNUAL  
THE PERIOD MAY 1 THRU AUGUST 14.  
SPRING LOVEGRASS (07 LBS./1000SQ.FT.).  
THRU FEBRUARY 28. PROTECT SITE BY  
F WELL ANCHORED STRAW MULCH AND  
N THE SPRING, OR USE SOD.

(CRE (70 TO 90 LBS./1000 SQ.FT.)  
RAW IMMEDIATELY AFTER SEEDING.  
FTER APPLICATION USING MULCH  
ONS PER ACRE (5 GAL./1000 SQ.FT.)  
AT ACRES, ON SLOPES 8 FEET OR HIGHER,  
8 GAL./1000 SQ.FT.) FOR ANCHORING.

D STANDARDS AND SPECIFICATION FOR SOIL  
OL FOR RATE AND METHODS NOT COVERED.

R  
I AS  
ULCH  
SHOULD

TJ  
JING.

IE  
IG.

F 15  
RE AS  
THIS

N. FENCE  
1. DRIVEN MIN.  
TO GROUND

HEIGHT OF FILTER  
6" MIN.

STANDARD SYMBOL

5 5

OR U  
WOOD

GA.  
ENING

MIRAFI  
A TH ON  
QUAL

LOFAB.  
R APPROVED

OR U  
WOOD

GA.  
ENING

MIRAFI  
A TH ON  
QUAL

LOFAB.  
R APPROVED

OR U  
WOOD

GA.  
ENING

MIRAFI  
A TH ON  
QUAL

LOFAB.  
R APPROVED

OR U  
WOOD

GA.  
ENING

MIRAFI  
A TH ON  
QUAL

LOFAB.  
R APPROVED

OR U  
WOOD

GA.  
ENING

MIRAFI  
A TH ON  
QUAL

LOFAB.  
R APPROVED

OR U  
WOOD

GA.  
ENING

MIRAFI  
A TH ON  
QUAL

LOFAB.  
R APPROVED

OR U  
WOOD

GA.  
ENING