

APPLICATION

A 15956

P _____

SEWAGE DISPOSAL TESTING

MARYLAND STATE DEPARTMENT OF HEALTH

HOWARD COUNTY 1000 Gal Tank

ELLCOTT CITY

DISTRICT 3DATE 5/19/71

5/15/71
9:30
Deep tile field - 750 sq ft bottom area
9:30 installed 6 FT to 9 FT below grade

Place tile field in area 10 FT to 40 ft from the left side of the lot as seen when facing the lot
TO: THE COUNTY HEALTH OFFICER
ELLCOTT CITY, MARYLAND *from Underwood Rd and between lot line*

I, HEREBY, APPLY FOR THE NECESSARY TESTS IN ORDER TO CONSTRUCT (OR RECONSTRUCT) A SEWAGE DISPOSAL SYSTEM. *10 FT and 145 FT from the back*

PROPERTY OWNER Richard C. MyersADDRESS Star Route 2, Box 27A, Underwood Rd., PHONE 465-2241
Sykesville, Md.

PROPERTY LOCATION:

SUBDIVISION Ridgeways LOT NO. 5ROAD AND DESCRIPTION Underwood Rd. (see original application for better directions)

OCCUPANT _____ PHONE _____

PERSON TO CONSTRUCT SYSTEM _____

ADDRESS _____ PHONE _____

SIZE OF LOT 215" x 193" TYPE BLDG. _____

NUMBER OF BEDROOMS _____

IF NOT SINGLE RESIDENCE DESCRIBE _____

SIGNATURE OF APPLICANT /s/ Sigrid S. MyersAPPROVED BY *Sigrid S. Myers* FOR *Tile Field* DATE 5/25/71

(KIND OF SYSTEM)

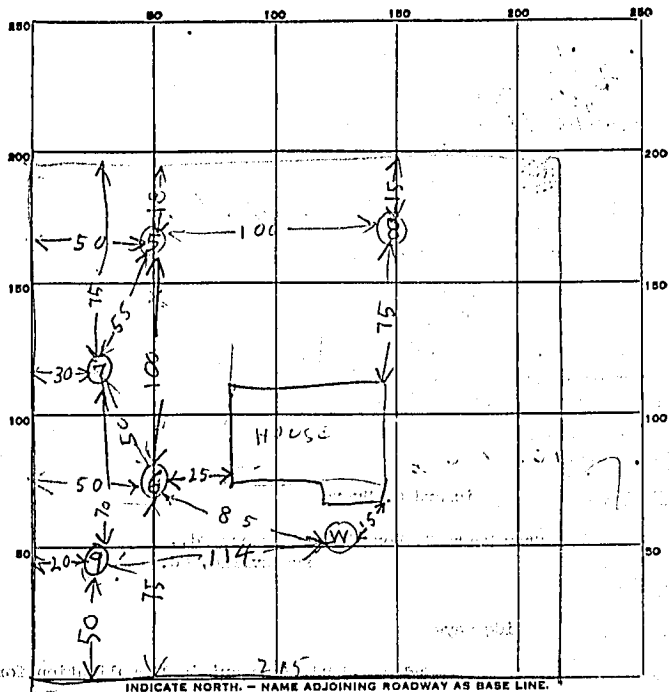
REJECTED BY _____ FOR _____ DATE _____

(KIND OF SYSTEM)

HOLD PENDING FURTHER TESTS _____ DATE _____

REASONS FOR REJECTION OR HOLDING _____

THIS IS NOT A PERMIT

$$\begin{array}{r} 20 \\ 53 \\ 12 \\ 18 \\ \hline 03 \\ 29 \end{array}$$


INDICATE NORTH. - NAME ADJOINING ROADWAY AS BASE LINE.

UNDERWOOD RID

[illegible]

SOIL AUGER FINDING.

TESTED BY.

REMARKS

UNDERWOOD

ROAD

A13269

S. 02° 15' E

215.30'

133.00'

BUILDING

RESTRICTION

LINE

133.00'

4'x4'
Porch

1STY. BRICK
& FRAME

4.2'x13.0'
Cellar Wall

5' UTILITY RESERVATION

N. 03° 15' W.

215.30'

133.00'

PLOT PLAN

LOT N° 5

RIDGEWAY'S SUBDIVISION

THIRD ELECTION DISTRICT

HOWARD COUNTY, MD.

PURDUM & JESCHKE

Engineers

MAY 3, 1971

SCALE: 1"=30'

24 PACE AVE., ELLICOTT CITY, MD.