

4/29/71
needs review before
lets water
Noted. Needed
5/6/71 R.H.

6/24/71

PERMIT

SEWAGE DISPOSAL SYSTEM

P 15915

A 13269

MARYLAND STATE DEPARTMENT OF HEALTH

HOWARD COUNTY

ELLICOTT CITY

DISTRICT 3

DATE 4/28/71

INDEXED

Collins Brothers IS PERMITTED TO INSTALL ☒ ALTER

ADDRESS Sykesville, Maryland PHONE

A SEWAGE DISPOSAL SYSTEM LOCATED AT

SUBDIVISION Ridgeway's ROAD Underwood (see application for better directions) LOT 5

PROPERTY OWNER Mr. and Mrs. Richard C. Myers

ADDRESS

SPECIFICATIONS - 3 bedrooms

DRAIN FIELD DEPTH FEET, BOTTOM AREA SQ. FT.

SEEPAGE PITS ABSORBENT SIDE-WALL AREA SQ. FT.

SEPTIC TANK CAPACITY 1,000 GALLONS

FOR GARBAGE GRINDER, INCREASE DISPOSAL AREA 22% & TANK CAPACITY 50%.

OTHER Dry well - 300 sq. ft. sidewall area below the top 5 ft. of clayish soil. Place the dry well 45 ft. to 65 ft. from the back lot line and 40 ft. to 60 ft. from the left side of the lot as seen when facing the lot from Underwood Rd.
Retested 5/22/71 Retested 5/22/71
DO NOT INSTALL BASEMENT TOILETS. Place the house in area shown on the plot plan of

November 27, 1967.

NOTE: ALL PIPE FROM HOUSE TO SEPTIC TANK MUST BE CAST IRON.


PLANS APPROVED BY Raymond Hodges DATE 11/28/67
PERMIT VOID AFTER THREE YEARS.

FILL SEPTIC TANK AND DISTRIBUTION BOX WITH WATER BEFORE CALLING FOR AN INSPECTION. COVER NO WORK UNTIL INSPECTED AND APPROVED.

NEITHER THE HOWARD COUNTY COMMISSIONERS NOR THE HEALTH DEPARTMENT IS RESPONSIBLE FOR THE SUCCESSFUL OPERATION OF ANY SYSTEM.

Deep Tilt Field 750 sq ft bottom area 6 FT to 9 FT below
Place the field in area 10 ft to 14 ft from left
side of the lot as seen when facing lot from
Underwood Rd & 10 FT to 145 FT from the back lot line

13269

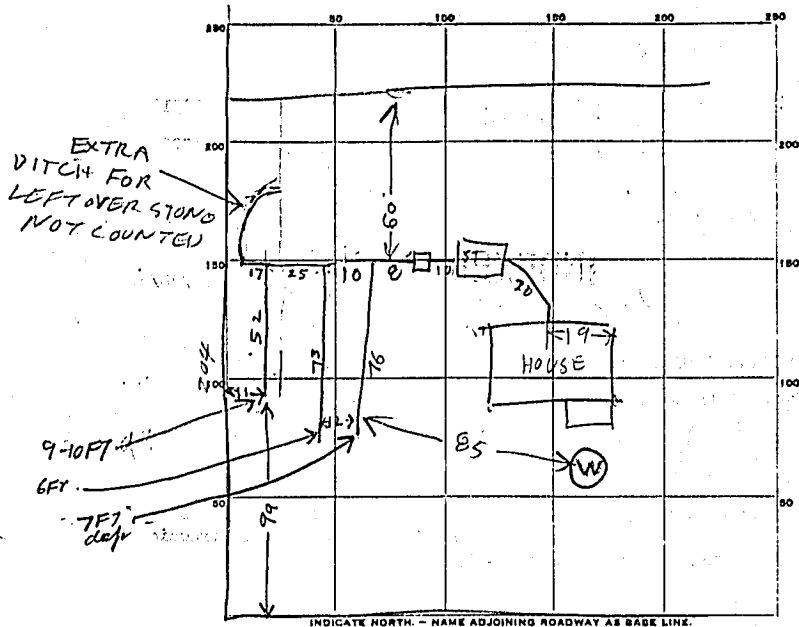

28
10
10

1076
73
52
17
25
10
8

261
3
783

PERMIT CARD _____
 SEPTIC TANK, LEVEL 614 concrete 1000 CLEANOUTS 0 15
 DISTRIBUTION BOX, LEVEL _____
 TILE FIELD, DEPTH 6-9 FT. TRENCH WIDTH 3 FT.
 GRAVEL DEPTH 24 IN. TOTAL LENGTH 261 FT.
 NUMBER OF TRENCHES 3 TOTAL BOTTOM AREA 783
 SEEPAGE PITS, INSIDE DIAMETER _____ FT. DEPTH BELOW INLET _____ FT.
 ABSORBENT AREA _____ SQ. FT.

REMARKS 4/24/71 See Reverse side of Septic System Plans

DATE SYSTEM APPROVED 6/24/71 INSPECTOR Raymond Rodger