



HOWARD COUNTY HEALTH DEPARTMENT

74966

DATE 7/6/23

Received From

PHONE #

410 795-2947

Freedom Septic Repair

For

Septic Permit / 1241

Handwritten way

CASH

CHECK

NO.

511


Two hundred sixty five

Dollars

\$ 265.00

Received By

Handwritten signature

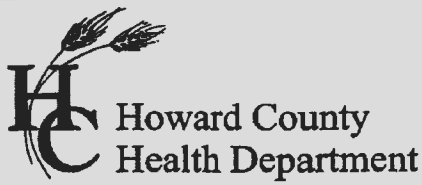

Bureau of Environmental Health
8930 Stanford Boulevard, Columbia, MD 21045
Main: 410-313-2640 | Fax: 410-313-2648
TDD 410-313-2323 | Toll Free 1-866-313-6300
www.hchealth.org
Facebook: www.facebook.com/hocohealth

Maura J. Rossman, M.D., Health Officer

RECEIPT DATE: 7/24/2023 ONSITE SEWAGE DISPOSAL SYSTEM P 574966

APPROVAL DATE: 7/26/2023 SP PERMIT: REPAIR A Repair

PROPERTY ADDRESS: 7241 Meadow Wood Way

SUBDIVISION: n/a LOT: n/a TAX ID:

CONTRACTOR: Freedom Septic EMAIL: Christy@freedomseptic.com

CONTRACTOR ADDRESS: 2809 Liberty Rd, Sykesville, MD 21784 PHONE: 410-795-2947

PROPERTY OWNER: Brenda Allen EMAIL:

OWNER ADDRESS: Same as above PHONE:

SEPTIC TANK SIZE: Existing PUMP TANK CAPACITY: n/a PUMP SIZE: n/a

DISTRIBUTION SYSTEM: [X] GRAVITY [] PRESSURE DOSED BEDROOMS: 6 APPLICATION RATE: 0.8

Table with trench specifications: LINEAR FEET REQUIRED: 102, INLET DEPTH: 3, TRENCH WIDTH: 2, MAXIMUM BOTTOM DEPTH: 9, MINIMUM SPACE BETWEEN TRENCHES: 9, EFFECTIVE AREA BEGINNING DEPTH: 5

LOCATION: TO BE STAKED BY SANITARIAN DURING PRE-CONSTRUCTION INSPECTION.


NOTES: Install system per approved design plan.

ISSUED BY: K. Wolf ISSUE DATE: 7/25/2023 EXPIRATION DATE: 7/25/2024

- NOTE: CONTRACTOR MUST SCHEDULE A PRE-CONSTRUCTION INSPECTION PRIOR TO BEGINNING ANY INSTALLATION
NOTE: CONTRACTOR MUST SCHEDULE AN INSPECTION AND GAIN APPROVAL OF ALL COMPONENTS PRIOR TO COVERING
NOTE: STONE MUST BE APPROVED BY HEALTH DEPARTMENT AND GRAVEL TICKET MUST BE AVAILABLE FOR REVIEW.
NOTE: WATERTIGHT SEPTIC TANKS REQUIRED
NOTE: ALL PARTS OF SEPTIC SYSTEM SHALL BE AT LEAST 100 FEET DOWNGRADIENT FROM ANY WATER WELL
NOTE: MANHOLE RISERS REQUIRED ON ALL SEPTIC TANKS AND PUMP CHAMBERS
NOTE: AN ELECTRICAL PERMIT IS REQUIRED FOR INSTALLATION OF ANY ELECTRICAL COMPONENTS OF THE SYSTEM
NOTE: THE HCHD DOES NOT WARRANTY ANY SYSTEM AND CANNOT GUARANTEE THE PERFORMANCE OF THIS SYSTEM AS DESIGNED. BY ACCEPTING THIS PERMIT, THE OWNER AND/OR APPLICANT ACKNOWLEDGE THAT THE SPECIFICATIONS DETAILED IN THIS DESIGN ARE ONE POSSIBLE OPTION AND THAT THE HCHD WILL REVIEW OTHER PROPOSALS. YOU HAVE THE OPTION TO SEEK THE ADVICE OF A QUALIFIED DESIGN CONSULTANT OR PROFESSIONAL ENGINEER FOR FURTHER GUIDANCE.
NOTE: AN INDIVIDUAL CERTIFIED BY MDE AND THE MANUFACTURER FOR BAT INSTALLATION MUST BE PRESENT AT ALL TIMES DURING BAT INSTALLATION.
NOTE: MDE RECOMMENDS SEPTIC TANKS, BAT, AND OTHER PRETREATMENT UNITS BE PUMPED AT A FREQUENCY ADEQUATE TO ENSURE THAT SOLIDS ARE NOT DISCHARGED TO THE DISPOSAL AREA

NEITHER THE HOWARD COUNTY COUNCIL NOR THE HEALTH DEPARTMENT IS RESPONSIBLE FOR THE SUCCESSFUL OPERATION OF ANY SYSTEM.
PERMITTEE RESPONSIBLE FOR OBTAINING FINAL APPROVAL ON THIS PERMIT.
CALL 410-313-1771 TO SCHEDULE INSPECTIONS.

NOT TO SCALE

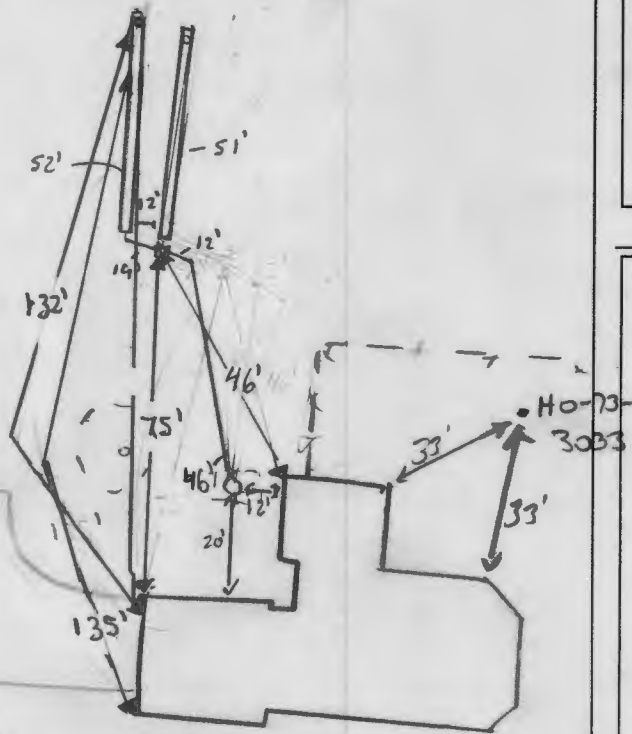

ROAD NAME

TRENCH/DRAINFIELD DATA

WIDTH	INLET	BOTTOM
2'	3'	9'
NUMBER OF TRENCHES		2
TOTAL LENGTH		103'
ABSORPTION AREA		206 ft ²
DISTRIBUTION BOX LEVEL		YES
DISTRIBUTION BOX BAFFLE		YES
DISTRIBUTION BOX PORT		YES

SEPTIC TANK DATA

SEPTIC TANK I LEVEL	YES
MANUFACTURER	N/A
CAPACITY	1500 GAL
SEAM LOC	mid
TANK LID DEPTH	5'
BAFFLES	YES
BAFFLE FILTER	-
MANHOLE LOC	Rear
6" PORT LOC	
WATERTIGHT TEST	OK
SLOTTED	NO
DATE ON LID	N/A
PUMP/SEPTIC TANK LEVEL	N/A
MANUFACTURER	
CAPACITY	GAL
SEAM LOC	
TANK LID DEPTH	
BAFFLES	
BAFFLE FILTER	
MANHOLE LOC	
6" PORT LOC	
WATERTIGHT TEST	
SLOTTED	
DATE ON LID	

PRE-CONSTRUCTION:

7/24/2023 Dig - plan approved. ok to continue w/ install (SP)

INSTALLATION: 7/25/2023 - Installer got stung by yellowjackets, had to close part of line coming out of tank. Stopped work for rest of the day. (SP)

7/26/2023 - Measured from front fence to 45' bend to O-box. Levelled O-box. Measured trenches, length @ 52' & 51'. Inlet @ 3' per plan. Measured bottom of lower trench, at 9' per plan. (SP)

Installer sent pic of pumped & crushed drywell (see attached pics) (SP)

FINAL INSPECTOR S. Page DATE OF APPROVAL 7/26/2023



Abandoned Drywell


Received by Installer 6/26/2023 (SF)

7241

490

7237

2x 52 Ft Trenches
 2 Ft wide
 inlet 3 Ft
 Bottom 9 Ft
 6 Ft Stone Below pipe

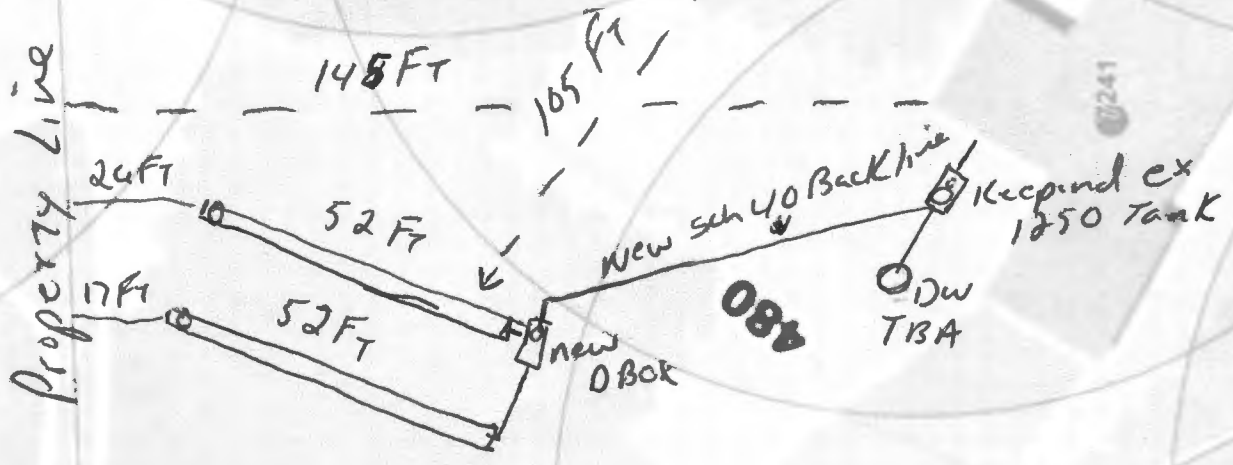

All neighboring wells
 Are over 100 Ft Away

070

Approved Septic System Plan
 Howard County Health Department

 Signature Date