

*Preliminary  
34-13' holes  
on 10,000 #*

# APPLICATION

A 24589

SEWAGE DISPOSAL TESTING

P \_\_\_\_\_

STATE OF MARYLAND - DEPARTMENT OF HEALTH AND MENTAL HYGIENE

HOWARD COUNTY HEALTH DEPARTMENT  
ENVIRONMENTAL HEALTH SERVICES

DISTRICT 3rd

P. O. BOX 476, ELLICOTT CITY, MARYLAND 21043  
TELEPHONE: 465-5000, EXT. 356

DATE 9/24/76

TO: THE COUNTY HEALTH OFFICER  
ELLICOTT CITY, MARYLAND

I, HEREBY, APPLY FOR THE NECESSARY TEST IN ORDER TO CONSTRUCT (OR RECONSTRUCT) A SEWAGE DISPOSAL SYSTEM.

PROPERTY OWNER ~~Fred James Pipes~~ Wayne Swift.

ADDRESS 13555 Old Frederick Road, Sykesville, Md. PHONE \_\_\_\_\_  
21784

PROPERTY LOCATION:

SUBDIVISION Annandale LOT NO. 24 24

ROAD AND DESCRIPTION 1701 Old Frederick Road, and Underwood Road

SIZE OF LOT 42,700 sq. ft. TYPE BLDG. 3 or 4

IF NOT SINGLE RESIDENCE DESCRIBE \_\_\_\_\_  
NUMBER OF BEDROOMS  
single family dwelling

THE SYSTEM INSTALLED UNDER THIS APPLICATION IS ACCEPTABLE ONLY UNTIL PUBLIC FACILITIES BECOME AVAILABLE.

SIGNATURE OF APPLICANT /s/ Fred James Pipes

APPROVED BY Prelim upon 8/16/76. FOR \_\_\_\_\_ DATE \_\_\_\_\_


REJECTED BY \_\_\_\_\_ FOR \_\_\_\_\_ DATE \_\_\_\_\_

HOLD PENDING FURTHER TESTS \_\_\_\_\_ DATE \_\_\_\_\_

REASONS FOR REJECTION OR HOLDING FINAL PLAT SIGNED

MAY 1977

## THIS IS NOT A PERMIT

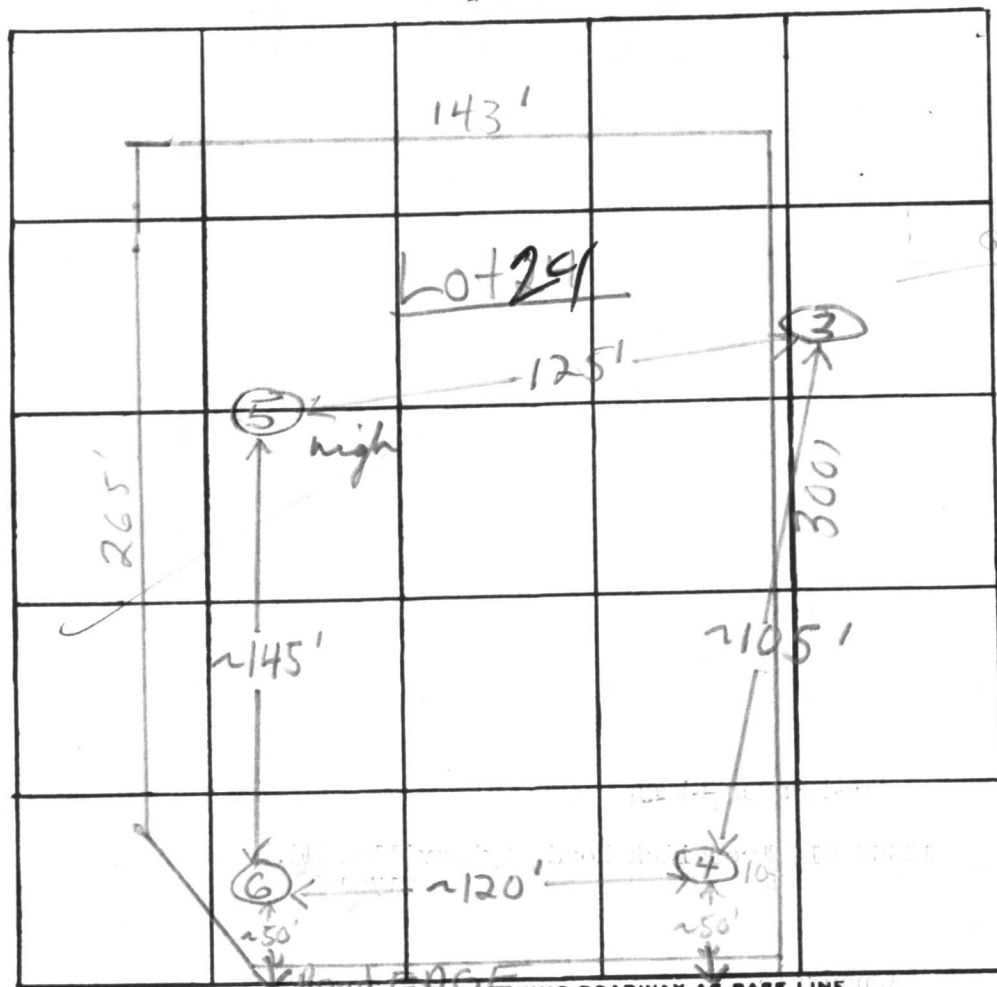

INDICATE NORTH: NAME ADJOINING ROADWAY AS BASE LINE.

UNDERWOOD ROAD

DATE	TEST NO.	DEPTH	PRE-WET		TEST - 1" DROP		TIME
			START	STOP	START	STOP	
7/23/76	3	13'	11:59	12:02	12:02	12:11	9min
	3A	4'	12:03	12:20	12:20	12:40	20min
	4	13'	12:13	12:23	12:23	12:41	18min
	4A	4'	12:18	12:22	12:22	12:29	7min
	5	4'	12:34	12:39	12:39	12:48	9min
	5A	13'	12:45	12:48	12:48	12:52	4min
	6	4'	12:53	pulled peg - still clayey			
	6A	13 1/2'	12:53	12:58	12:58	1:04	6min
	6B	5'	1:38	pulled peg - still clayey			
	6C	5 1/2'	2:20	2:24	2:24	2:32	8min

REMARKS

③ is on lot 25

TYPE OF SOIL

clayey to 3-5' sandy loam below

TESTED BY

F.S.

ALSO PRESENT:

Pipes & Son