

6/22/67

PERMIT

app 6-23-67
LW

P 12716
A 09856

SEWAGE DISPOSAL SYSTEM

MARYLAND STATE DEPARTMENT OF HEALTH

HOWARD COUNTY

ELLICOTT CITY

DISTRICT 2

DATE 6/5/67

INDEXED

_____ IS PERMITTED TO INSTALL ALTER _____
Emerson Feaga

ADDRESS Triadelphia Rd., Ellicott City, Md. PHONE AT 6-2516

A SEWAGE DISPOSAL SYSTEM LOCATED AT _____

SUBDIVISION Chamberlea ROAD Litor Dr. LOT 33

PROPERTY OWNER Douglas Lichtler

ADDRESS _____

SPECIFICATIONS - 3 bedrooms

DRAIN FIELD _____ DEPTH _____ FEET, BOTTOM AREA _____ SQ. FT.

SEEPAGE PITS _____ ABSORBENT SIDE-WALL AREA _____ SQ. FT.

SEPTIC TANK CAPACITY 750 GALLONS

FOR GARBAGE GRINDER, INCREASE DISPOSAL AREA 22% & TANK CAPACITY 50%.

OTHER Dry well - 300 sq. ft. sidewall area below inlet pipe. Inlet pipe

no deeper than 4 ft. below grade.

Place dry well 36 ft. from rear lot line and either 75 or 100 ft. from right

sideline as seen when facing lot from Litor Dr.

MAXIMUM DEPTH PERMITTED 13' below original grade.

PERMIT VOID AFTER THREE YEARS.

PLANS APPROVED BY D. W. Monaghan DATE 8/3/63


FILL SEPTIC TANK AND DISTRIBUTION BOX WITH WATER BEFORE CALLING FOR AN INSPECTION. COVER NO WORK UNTIL INSPECTED AND APPROVED.

NEITHER THE HOWARD COUNTY COMMISSIONERS NOR THE HEALTH DEPARTMENT IS RESPONSIBLE FOR THE SUCCESSFUL OPERATION OF ANY SYSTEM.

NOTIFY THE HEALTH DEPARTMENT 48 HOURS BEFORE EXCAVATIONS ARE TO BE BACK FILLED.

A. 09856

A 09856

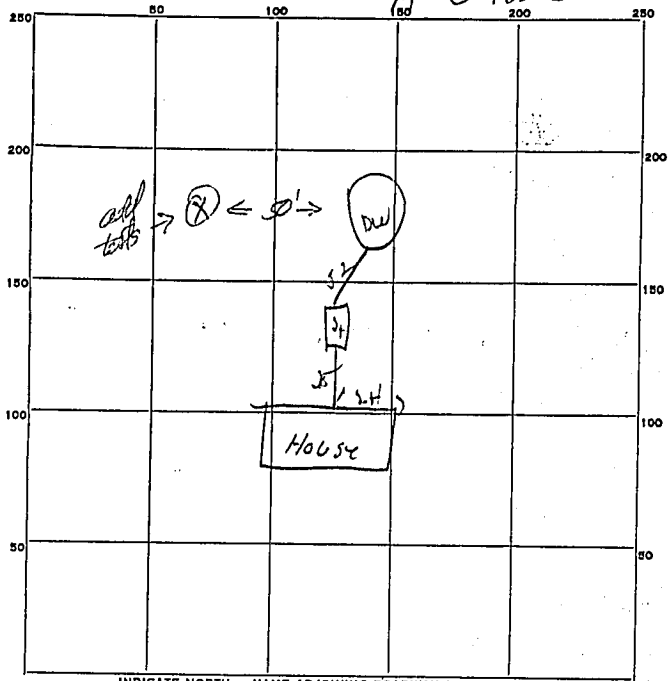

INDICATE NORTH. - NAME ADJOINING ROADWAY AS BASE LINE.

Let's show

PERMIT CARD OK

SEPTIC TANK, LEVEL OK

CLEANOUTS OK

DISTRIBUTION BOX, LEVEL _____

TILE FIELD, DEPTH _____ FT. TRENCH WIDTH _____ FT.

GRAVEL DEPTH _____ IN. TOTAL LENGTH _____ FT.

NUMBER OF TRENCHES _____ TOTAL BOTTOM AREA _____

SEEPAGE PITS, ^{outside} INSIDE DIAMETER 13 FT. DEPTH BELOW INLET 5 FT.

ABSORBENT AREA 326+ SQ. FT.

REMARKS _____

4/65 tests at D.W., 2 min at 10 ft, 4 min. at 5 ft.

DATE SYSTEM APPROVED 6-23-67 INSPECTOR NEW Warrington