

*Received*

# APPLICATION

A 17126  
P \_\_\_\_\_

SEWAGE DISPOSAL TESTING

MARYLAND STATE DEPARTMENT OF HEALTH.

HOWARD COUNTY

ELLICOTT CITY

DISTRICT 4  
DATE 6/7/72

TO: THE COUNTY HEALTH OFFICER  
ELLICOTT CITY, MARYLAND

I, HEREBY, APPLY FOR THE NECESSARY TESTS IN ORDER TO CONSTRUCT (OR RECONSTRUCT) A SEWAGE DISPOSAL SYSTEM.

PROPERTY OWNER Daisy Hill, Joint Venture

ADDRESS 1131 Univ. Blvd. W. Silver Spring, Md. PHONE 649-1500

PROPERTY LOCATION:

SUBDIVISION Daisy Hill Estates LOT NO. Parcel A, Section One

ROAD AND DESCRIPTION North side of Unida Chapel Road, 350' east of Daisy Road

OCCUPANT none PHONE \_\_\_\_\_

PERSON TO CONSTRUCT SYSTEM \_\_\_\_\_

ADDRESS \_\_\_\_\_ PHONE \_\_\_\_\_

SIZE OF LOT 7.2354 acres TYPE BLDG. three  
NUMBER OF BEDROOMS \_\_\_\_\_

IF NOT SINGLE RESIDENCE DESCRIBE \_\_\_\_\_

SIGNATURE OF APPLICANT Daisy Hill, Joint Venture, by *Susan Rosenthal* Partner


APPROVED BY \_\_\_\_\_ FOR \_\_\_\_\_ (KIND OF SYSTEM) \_\_\_\_\_ DATE \_\_\_\_\_

REJECTED BY \_\_\_\_\_ FOR \_\_\_\_\_ (KIND OF SYSTEM) \_\_\_\_\_ DATE \_\_\_\_\_

HOLD PENDING FURTHER TESTS \_\_\_\_\_ DATE \_\_\_\_\_

REASONS FOR REJECTION OR HOLDING \_\_\_\_\_

## THIS IS NOT A PERMIT

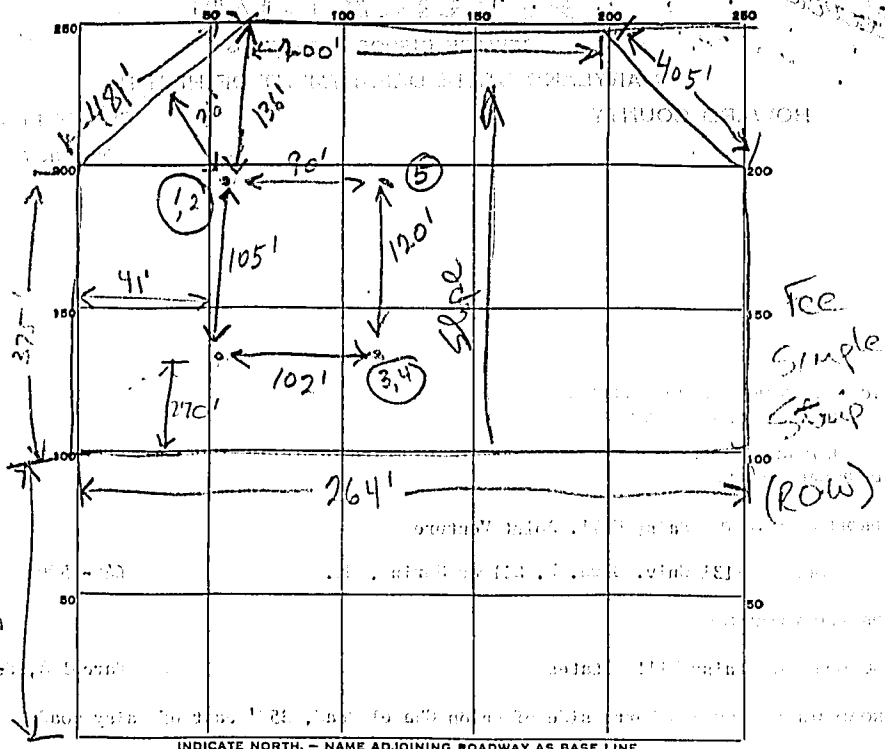

Fee  
Simple  
Strip  
(ROW)

435'

INDICATE NORTH - NAME ADJOINING ROADWAY AS BASE LINE.

Union Chapel

DATE	TEST NO.	DEPTH	PRE-WET		TEST - 1" DROP		TIME
			START	STOP	START	STOP	
8/2	1	4'	10:57	10:57	10:57	11:02	5 min
8/2	2	11'	10:58	11:10	11:10	11:32	34 min
	3	3 1/2'	11:35	11:37	11:37	11:41	6 min
	4	11'	11:18	11:25	11:25	11:37	19 min
	5	11'	11:38	11:48	11:48	12:03	25 min (top 3' clay)
	6						

Dry well

SOIL AUGER FINDING \_\_\_\_\_  
 TESTED BY \_\_\_\_\_  
 REMARKS \_\_\_\_\_