

# APPLICATION

A 21564

P \_\_\_\_\_

SEWAGE DISPOSAL TESTING

STATE OF MARYLAND - DEPARTMENT OF HEALTH AND MENTAL HYGIENE

HOWARD COUNTY HEALTH DEPARTMENT  
ENVIRONMENTAL HEALTH SERVICES  
P. O. BOX 476, ELLICOTT CITY, MARYLAND 21043  
TELEPHONE: 465-5000, EXT. 356

DISTRICT 4

DATE 5/27/75

TO: THE COUNTY HEALTH OFFICER  
ELLICOTT CITY, MARYLAND

I, HEREBY, APPLY FOR THE NECESSARY TEST IN ORDER TO CONSTRUCT (OR RECONSTRUCT) A SEWAGE DISPOSAL SYSTEM.

PROPERTY OWNER Carlton J. Dingman (Dingman)

ADDRESS Daisy Road, Woodbine, Md. PHONE 489-4724

PROPERTY LOCATION:

SUBDIVISION \_\_\_\_\_ LOT NO. \_\_\_\_\_

ROAD AND DESCRIPTION Corner of Daisy Road & Union Chapel Road

SIZE OF LOT \_\_\_\_\_ TYPE BLDG. Stora bldg.  
NUMBER OF BEDROOMS \_\_\_\_\_

IF NOT SINGLE RESIDENCE DESCRIBE \_\_\_\_\_

THE SYSTEM INSTALLED UNDER THIS APPLICATION IS ACCEPTABLE ONLY UNTIL PUBLIC FACILITIES BECOME AVAILABLE.

SIGNATURE OF APPLICANT /s/ Herman Sirk

APPROVED BY \_\_\_\_\_ FOR \_\_\_\_\_ DATE \_\_\_\_\_  
(KIND OF SYSTEM)


REJECTED BY \_\_\_\_\_ FOR \_\_\_\_\_ DATE \_\_\_\_\_  
(KIND OF SYSTEM)

HOLD PENDING FURTHER TESTS \_\_\_\_\_ DATE \_\_\_\_\_

REASONS FOR REJECTION OR HOLDING \_\_\_\_\_

## THIS IS NOT A PERMIT

A 21564

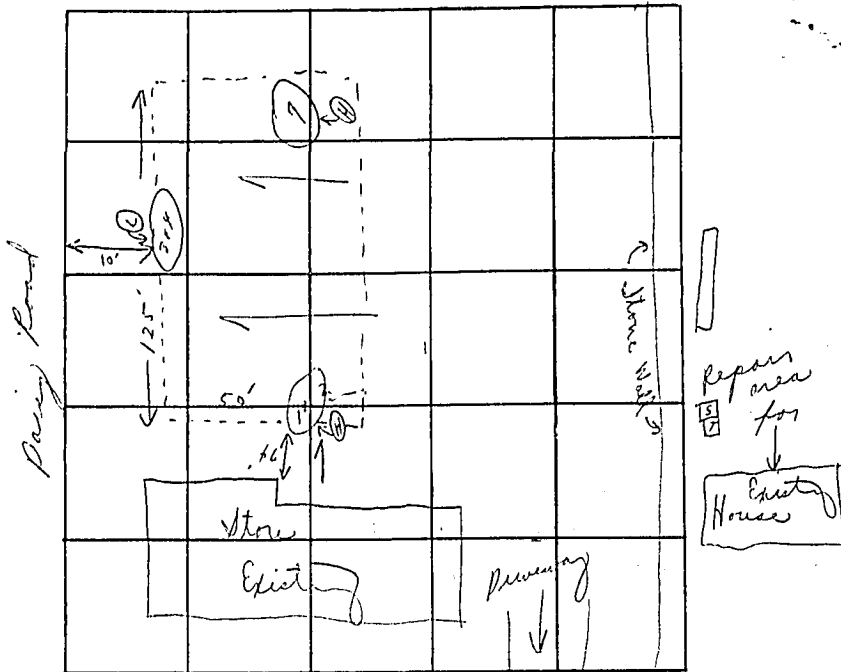

INDICATE NORTH - NAME ADJOINING ROADWAY AS BASE LINE

Union Chapel Rd

DATE	TEST NO.	DEPTH	PRE-WET		TEST - 1" DROP		TIME
			START	STOP	START	STOP	
9/20/75	1	4 1/2' s	10:16	10:20	10:20	10:26	6 min
	2	12' 0"	10:15	10:17	10:17	10:21	4 min
	3	6' s	10:40	10:44	10:44	10:55	11 min
	4	12 1/2' d	10:29	10:31	10:31	10:35	4 min
	5	X	X	X	X	X	X
	6	X	X	X	X	X	X
	7	(10 1/2')	Visual				similar to others

(clay to 5 1/2")

REMARKS 3 holes only per F.F.  
 TYPE OF SOIL Westland shale below clay clay first  
 TESTED BY C. B. V. ALSO PRESENT: Dick + crew

Mullins Ford