

5/27/75  
5-29-75

Hold for  
call  
for  
final

P.C.O  
P.C.O  
P 21566  
A \_\_\_\_\_

# PERMIT

SEWAGE DISPOSAL SYSTEM

MARYLAND STATE DEPARTMENT OF HEALTH

HOWARD COUNTY

## INDEXED

ELLICOTT CITY

DISTRICT 4th

DATE 5/23/75

Herman Sirk IS PERMITTED TO INSTALL \_\_\_\_\_ ALTER X  
ADDRESS Jennings Chapel Road, Woodbine, Maryland 21797 PHONE 489-4724

A SEWAGE DISPOSAL SYSTEM LOCATED AT \_\_\_\_\_

SUBDIVISION \_\_\_\_\_ ROAD Corner of Daisy Road & Union Chapel Rd. LOT \_\_\_\_\_

PROPERTY OWNER Carlton J. Dingman

ADDRESS Daisy Road, Daisy, Maryland Phone: 489-7610

SPECIFICATIONS  
DRAIN FIELD \_\_\_\_\_ DEPTH \_\_\_\_\_ FEET, BOTTOM AREA \_\_\_\_\_ SQ. FT.  
SEEPAGE PITS \_\_\_\_\_ ABSORBENT SIDE-WALL AREA \_\_\_\_\_ SQ. FT.  
SEPTIC TANK CAPACITY 1000 GALLONS

FOR GARBAGE GRINDER, INCREASE DISPOSAL AREA 22% & TANK CAPACITY 50%.

OTHER Repair - Call for inspection when ground is opened up so Sanitarian can recommend repair system.

for houses; recommend new septic tank and 50'-50' of trench D.I.C.C. 6' gravel under pipe (Regulate existing system)


PLANS APPROVED BY Palmer F. Wine DATE 5/23/75

FILL SEPTIC TANK AND DISTRIBUTION BOX WITH WATER BEFORE CALLING FOR AN INSPECTION. COVER NO WORK UNTIL INSPECTED AND APPROVED.

NEITHER THE HOWARD COUNTY COMMISSIONERS NOR THE HEALTH DEPARTMENT IS RESPONSIBLE FOR THE SUCCESSFUL OPERATION OF ANY SYSTEM.

P 21566

21560.

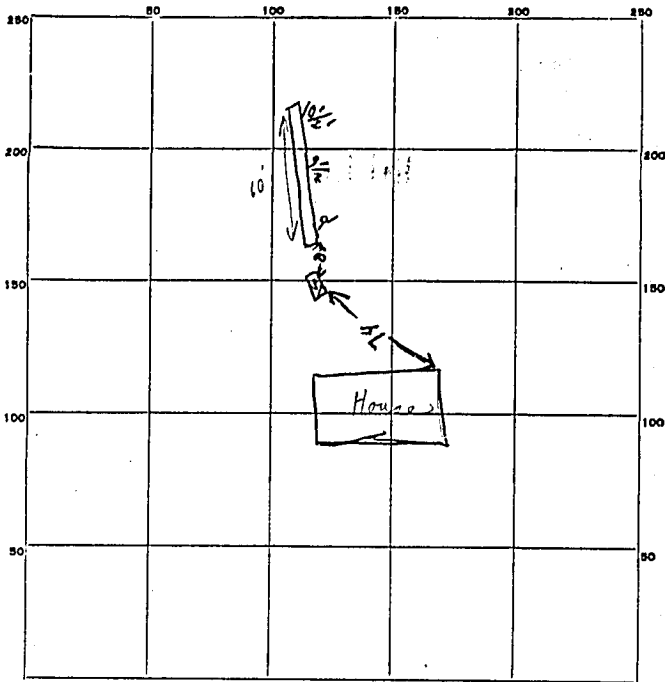

INDICATE NORTH. - NAME ADJOINING ROADWAY AS BASE LINE.

PERMIT CARD (1+2) (North view) Union Chapel Road S.T.

SEPTIC TANK, LEVEL 1000 TOP M 1/2 FT CLEANOUTS 1/2 NOTE 7 5/29/75  
below grade

DISTRIBUTION BOX, LEVEL \_\_\_\_\_

TILE FIELD, DEPTH \_\_\_\_\_ FT. TRENCH WIDTH \_\_\_\_\_ FT.

GRAVEL DEPTH 6-7 FT TOTAL LENGTH 10 FT.

NUMBER OF TRENCHES 1 TOTAL BOTTOM AREA \_\_\_\_\_

SEEPAGE PITS, INSIDE DIAMETER \_\_\_\_\_ FT. DEPTH BELOW INLET \_\_\_\_\_ FT.

ABSORBENT AREA 1 SQ. FT.

REMARKS 5/29/75 ① Hole for septic tank only. + small part of trench open for repair to existing system. ② Trench dug to 60' length + depth as indicated.

5/29/75 AM Well is in front of House OK to cover trench & tank. Install sewer line & Cleanout for Tank R.H. 5/29/75 PM Cleanout & Sewer installed R.H.

DATE SYSTEM APPROVED 5/29/75 INSPECTOR Raymond Hodges