

**HOWARD COUNTY  
 PERMIT APPLICATION**

**309002833  
 PERMIT NUMBER**

Building Address 13482 Villadest DR  
Highland 20777  
 Suite/Apt. #: \_\_\_\_\_ SDP/WP/Petition #: \_\_\_\_\_  
 Census Tract \_\_\_\_\_ Subdivision \_\_\_\_\_  
 Section \_\_\_\_\_ Area \_\_\_\_\_ Lot 12  
 Tax Map 34 Parcel 354 Grid 20  
 Zoning \_\_\_\_\_ Map Coordinates \_\_\_\_\_ Lot Size \_\_\_\_\_

Property Owner's Name MORRIS MICHAEL S  
 Address 137 Summer Wind DR  
 City Morrisville State NC Zip Code 28117  
 Home Phone \_\_\_\_\_ Work Phone \_\_\_\_\_  
 Applicant's Name & Mailing Address, (if other than stated herein): \_\_\_\_\_

Existing Use SFD  
 Proposed Use SAME AS TANK /with Tank  
 Estimated Construction Cost \$ 1000.00

Contractor Company Michel Welding & Mechanical  
 Contact Person Robert J Michel Sr  
 Address 2510 Green Rd  
 City Baldwin State MD Zip Code 21013  
 License No. 73061  
 Phone 410 692 5416 Fax 443 927 9357

Description of Work Install 1-500 UG  
PROPANE TANK AND Run line TO HOUSE

Engineer or Architect Company \_\_\_\_\_  
 Contact Person \_\_\_\_\_  
 Address \_\_\_\_\_  
 City \_\_\_\_\_ State \_\_\_\_\_ Zip Code \_\_\_\_\_  
 Phone \_\_\_\_\_ Fax \_\_\_\_\_

Occupant or Tenant OWNER  
 Contact Name \_\_\_\_\_  
 Address \_\_\_\_\_  
 City \_\_\_\_\_ State \_\_\_\_\_ Zip Code \_\_\_\_\_  
 Phone \_\_\_\_\_ Fax \_\_\_\_\_

**BUILDING DESCRIPTION - COMMERCIAL**

**BUILDING DESCRIPTION - RESIDENTIAL**

Building Characteristics	Utilities
Height: _____	Water Supply: _____ <input type="checkbox"/> Public <input type="checkbox"/> Private
No. of stories: _____	Sewage Disposal: _____ <input type="checkbox"/> Public <input type="checkbox"/> Private
Gross area, sq. ft. per floor: _____	Electric Yes <input type="checkbox"/> No <input type="checkbox"/> Gas Yes <input type="checkbox"/> No <input type="checkbox"/>
Use group: _____	Heating System: _____ Electric <input type="checkbox"/> Oil <input type="checkbox"/> Natural Gas <input type="checkbox"/> Propane Gas <input type="checkbox"/>
Construction type: _____ <input type="checkbox"/> Reinforced Concrete <input type="checkbox"/> Structural Steel <input type="checkbox"/> Masonry <input type="checkbox"/> Wood Frame <input type="checkbox"/> State Certified Modular	Sprinkler system: N/A <input type="checkbox"/> <input type="checkbox"/> Full <input type="checkbox"/> Partial <input type="checkbox"/> Other Suppression # of Heads _____

Building Characteristics	Utilities
SF Dwelling <input type="checkbox"/> SF Townhouse <input type="checkbox"/> Depth _____ Width _____ 1 <sup>st</sup> floor: _____ 2 <sup>nd</sup> floor: _____ Basement: _____	Water Supply: _____ <input type="checkbox"/> Public <input checked="" type="checkbox"/> Private
Finished Basement <input type="checkbox"/> Unfinished Basement <input type="checkbox"/> Crawl space <input type="checkbox"/> Slab on Grade <input type="checkbox"/>	Sewage Disposal: _____ <input type="checkbox"/> Public <input checked="" type="checkbox"/> Private
No. of Bedrooms _____	Electric Yes <input checked="" type="checkbox"/> No <input type="checkbox"/> Gas Yes <input checked="" type="checkbox"/> No <input type="checkbox"/>
Multi-family dwellings: No. of efficiency units: _____ No. of 1 BR units: _____ No. of 2 BR units: _____ No. of 3 BR units: _____	Heating System: _____ Electric <input type="checkbox"/> Oil <input type="checkbox"/> Natural Gas <input type="checkbox"/> Propane Gas <input checked="" type="checkbox"/>
Other Structure: _____ Dimensions: _____ Footings: _____ Roof: _____	Sprinkler system: N/A <input type="checkbox"/> <input type="checkbox"/> NFPA #13D <input type="checkbox"/> NFPA #13R <input type="checkbox"/> Other: _____
<input type="checkbox"/> State Certified Modular <input type="checkbox"/> Manufactured Home	

THE UNDERSIGNED HEREBY CERTIFIES AND AGREES AS FOLLOWS: (1) THAT HE/SHE IS AUTHORIZED TO MAKE THIS APPLICATION; (2) THAT THE INFORMATION IS CORRECT; (3) THAT HE/SHE WILL COMPLY WITH ALL REGULATIONS OF HOWARD COUNTY WHICH ARE APPLICABLE THERETO; (4) THAT HE/SHE WILL PERFORM NO WORK ON THE ABOVE REFERENCED PROPERTY NOT SPECIFICALLY DESCRIBED IN THIS APPLICATION; (5) THAT HE/SHE GRANTS COUNTY OFFICIALS THE RIGHT TO ENTER ONTO THIS PROPERTY FOR THE PURPOSE OF INSPECTING THE WORK PERMITTED AND POSTING NOTICES.

Robert J Michel Sr  
 Applicant's Signature  
Michel Welding & Mechanical Repair  
 Title/Company

Robert J Michel Sr  
 Print Name  
10-16-09  
 Date

Checks payable to: DIRECTOR OF FINANCE OF HOWARD COUNTY


\*\*PLEASE WRITE NEATLY AND LEGIBLY\*\*

FOR OFFICE USE ONLY

AGENCY	DATE	SIGNATURE APPROVAL	DPZ SETBACK INFORMATION	PROPERTY ID #
Land Development, DPZ			Front: _____	Filing fee \$ _____
State Highways			Rear: _____	Permit fee \$ _____
Building Officials			Side: _____	Excise tax \$ _____
Dev. Engineering, DPZ			Side St.: _____	Add'l per fee \$ _____
Health <u>10/21/2009</u> <u>R. Bueker</u>			All minimum setbacks met?	TOTAL FEES \$ <u>110.00</u>
Fire Protection			YES <input type="checkbox"/> NO <input type="checkbox"/>	Sub-total paid \$ _____
Is Sediment Control approval required prior to issuance? YES <input type="checkbox"/> NO <input type="checkbox"/>			Is Entrance Permit Required? YES <input type="checkbox"/> NO <input type="checkbox"/>	Balance due \$ _____
			Historic District? YES <input type="checkbox"/> NO <input type="checkbox"/>	Check # _____
			Lot Coverage for New Town Zone _____	Validation # _____
			SDP/Red-line approval date _____	Accepted by _____

CONTINGENCY CONSTRUCTION START:   
 ONE STOP SHOP:

highlighted line appears  
 the black plastic tile  
 the original owner  
 was on the  
 2d slip of paper.

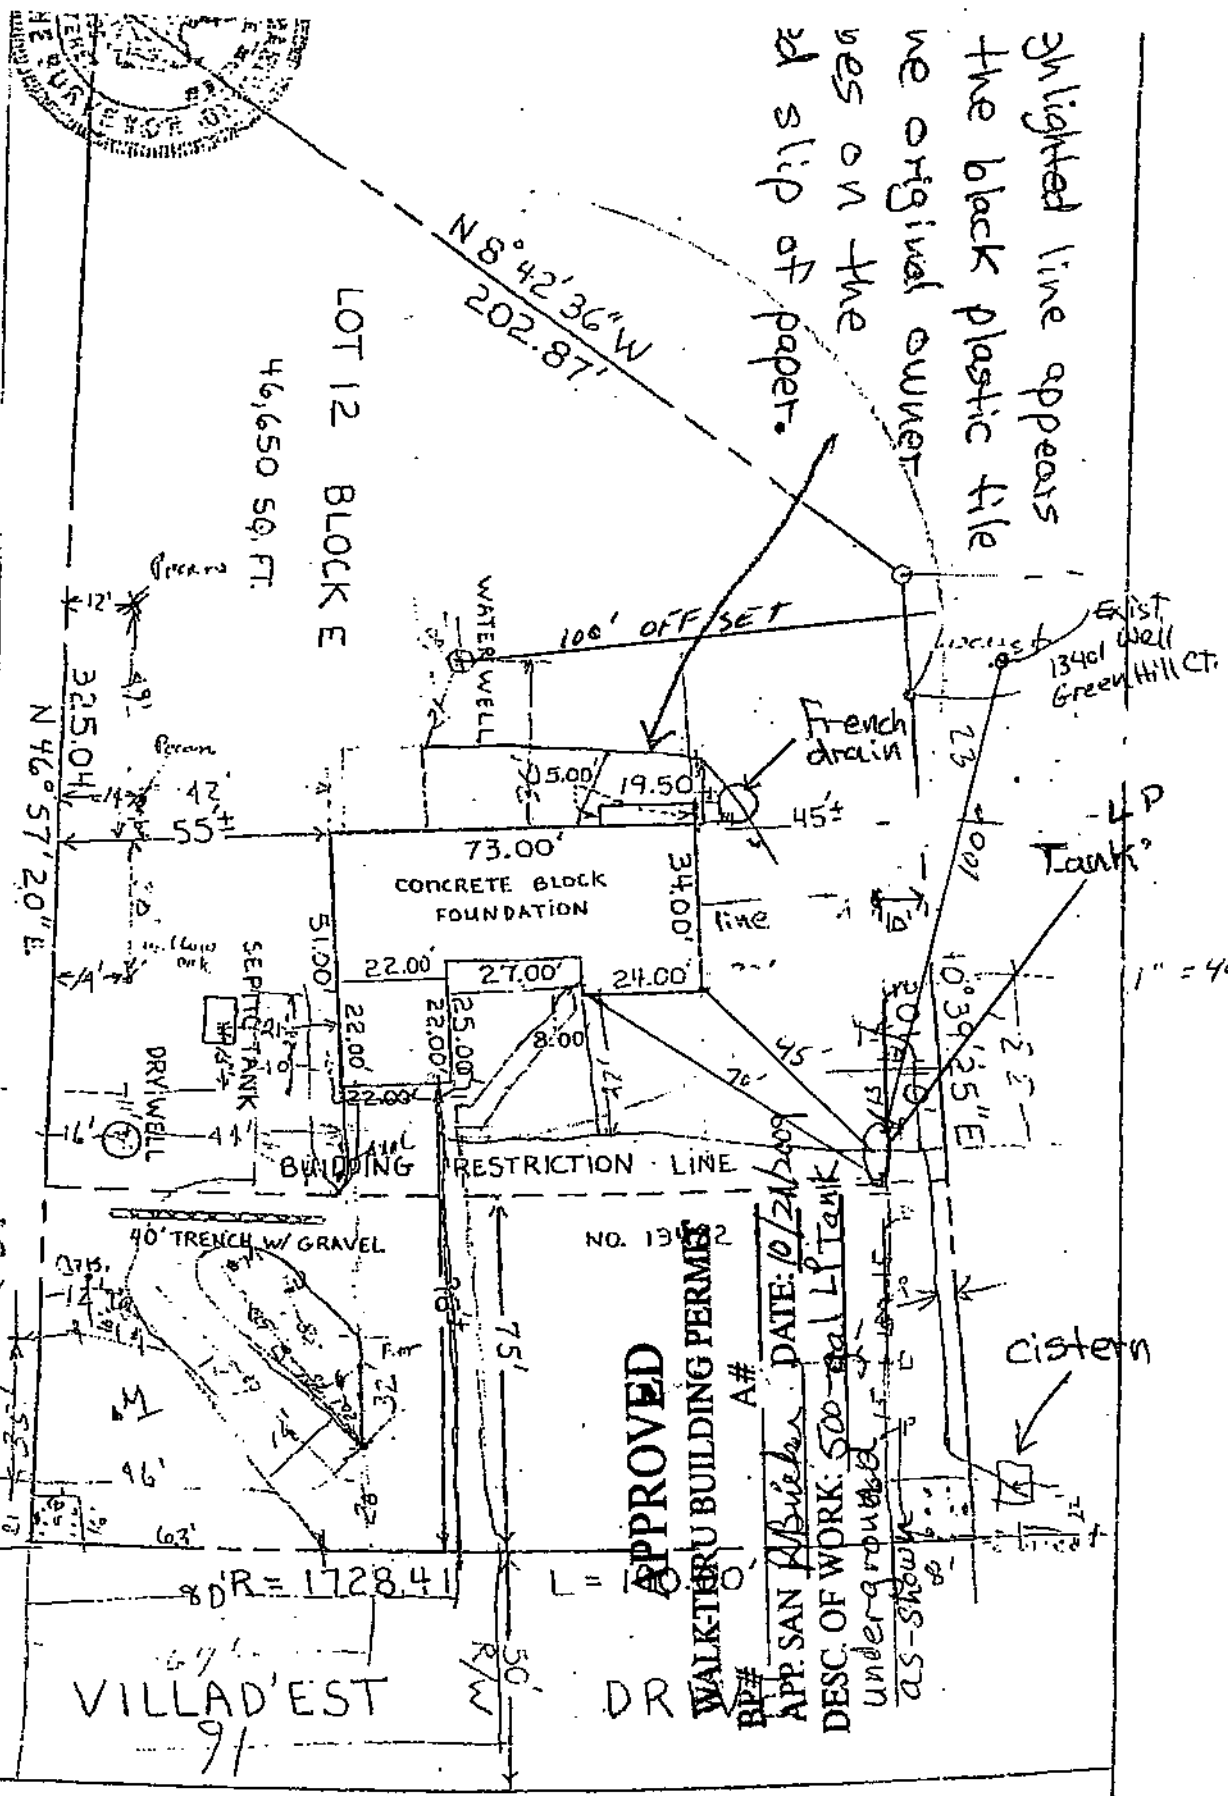

LOT 12 BLOCK E  
 46,650 SQ. FT.

**APPROVED**  
 WALKER BUILDING PERMITS  
 A# 1010  
 APP. SAN A. Bucher DATE: 10/21/2000  
 DESC. OF WORK: 500-gal LP tank  
 underground  
 as shown

VILLAD'EST

The French drain that I installed to drain the outside basement stairs is  
 w the level of the grass and about five feet from the wall of the stairs; so,  
 not likely to give you any problem in either burying the tank or installing the  
 there is a black plastic tile that drains the rear screen porch roof and extends  
 le back porch to the cistern at the street. This tile runs about midway  
 bedroom side) and the lot line (Pine trees) and is about 18 inches deep.  
 u exactly where this tile is located, your best approach probably is to simply  
 a gas line and when you cut the black tile just repair it. During the  
 ouse, the builder buried some construction trash fairly deep on the West side

THIS IS  
 FROM THE  
 ORIGINAL  
 OWNER,

MAP OF PROPERTY OF  
 MR. & MRS NORBERT SCHROEDE  
 SITUATED IN  
 ELECTION DISTRICT 5 HOWARD COU