

Bureau of Environmental Health 8930 Stanford Blvd | Columbia, MD 21045 410.313.2640 - Voice/Relay 410.313.2648 - Fax 1.866.313.6300 - Toll Free

Maura J. Rossman, M.D., Health Officer

MEMORANDUM

TO:

Linda Alexander

CLSI

FROM:

Jeff Williams

Deputy Director, Environmental Health

RE:

Revised PC 14080 Triadelphia Rd

DATE:

May 9, 2022

I have reviewed the revised perc cert submitted on 4/29/2022 and have the following comments:

- 1. The plan does not show sewage disposal areas on neighboring properties and does not identify or label sewage disposal systems on neighboring properties.
- 2. The proposed well location closest to the house is downgrade of the shared sewage disposal area on Parcel H and possibly downgrade of sewage disposal areas and a system at 14114 and 14116 Triadelphia.
- 3. The proposed well locations closer to 14110 Triadelphia Rd are downgrade of a portion of the sewage disposal area on 14080 and possibly a portion of the shared sewage disposal area on Parcel H.

Website: www.hchealth.org Facebook: www.facebook.com/hocohealth Twitter: @HoCoHealth

From:

Williams, Jeffrey

Sent:

Monday, November 15, 2021 3:16 PM

To:

'lalexander@clsimail.com'

Subject:

14080 Triadelphia Rd

Hello. We received a proposed perc cert revision moving a well box for this property. The perc cert does not show the shared sewage disposal system located on neighboring Parcel H. Furthermore, that system is located upgrade of the proposed well location. Please note that we will not consider wells downgrade of shared disposal areas even if they are able to be sited over 200' away.

Jeff Williams
Deputy Director
Bureau of Environmental Health
Howard County Health Dept.
410-313-4261
jewilliams@howardcountymd.gov

CONFIDENTIALITY NOTICE

This message and the accompanying documents are intended only for the use of the individual or entity to which they are addressed and may contain information that is privileged, confidential, or exempt from disclosure under applicable law. If the reader of this email is not the intended recipient, you are hereby notified that you are strictly prohibited from reading, disseminating, distributing, or copying this communication. If you have received this email in error, please notify the sender immediately and destroy the original transmission.

From:

Williams, Jeffrey

Sent:

Tuesday, December 28, 2021 2:25 PM

To:

Linda D. Alexander

Subject:

RE: 14080 Triadelphia Rd Hopkins choice Parcel I 2006016A

It looks like anything near the road and near the existing well would be easy approvals. In terms of anything closer: the well box as shown by the driveway is a no-go downgrade of the shared system. The individual well by 14100 might be possible, the one on the left. We'd have to see the proposed PC with neighboring septics. If the well is away from the swale by the shared driveway, it might be possible to argue that it is not downgrade of the shared system. We'd have to take a closer look on paper.

From: Linda D. Alexander < lalexander@clsimail.com>

Sent: Thursday, December 23, 2021 10:20 AM

To: Williams, Jeffrey < jewilliams@howardcountymd.gov>

Subject: RE: 14080 Triadelphia Rd Hopkins choice Parcel I 2006016A

[Note: This email originated from outside of the organization. Please only click on links or attachments if you know the sender.]

Jeff,

See the attached for other possible locations shown in red. The situation is the existing well needs some work done to it plus the size of the pump is huge to get the water the whole way back to the house. A well driller told the owner that it would

probably be better to drill a new well. Also the numerous cleanouts that we field located for the existing shared septic system.

Could you please look at the attachment? I am trying to speed up the process for a possible new well. I want to show the one

that we can get approved.

Thank you in advance for your help with this matter.

Linda D. Alexander Associate / Senior Project Manager

CLSI

439 East Main Street, Westminster, MD. 21157 lalexander@clsimail.com


direct: 410-871-4475 cell: 443-375-9903


From: Williams, Jeffrey <jewilliams@howardcountymd.gov>


Sent: Monday, November 15, 2021 3:16 PM

To: Linda D. Alexander < lalexander@clsimail.com>

Subject: 14080 Triadelphia Rd

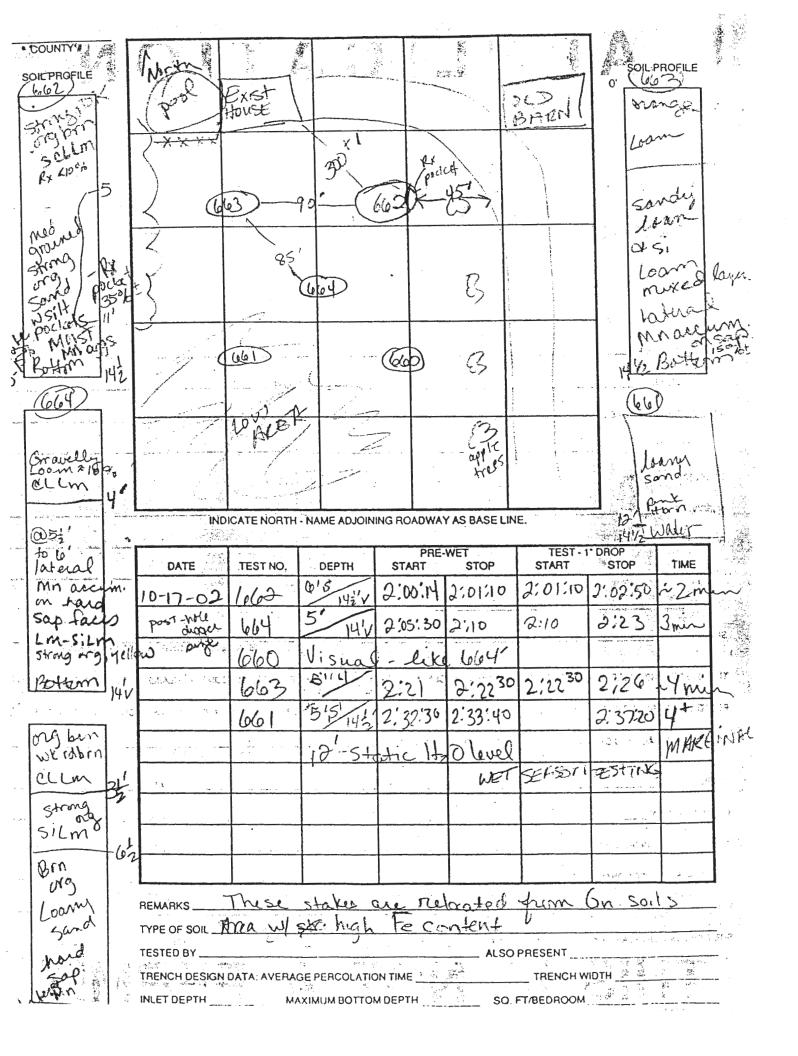

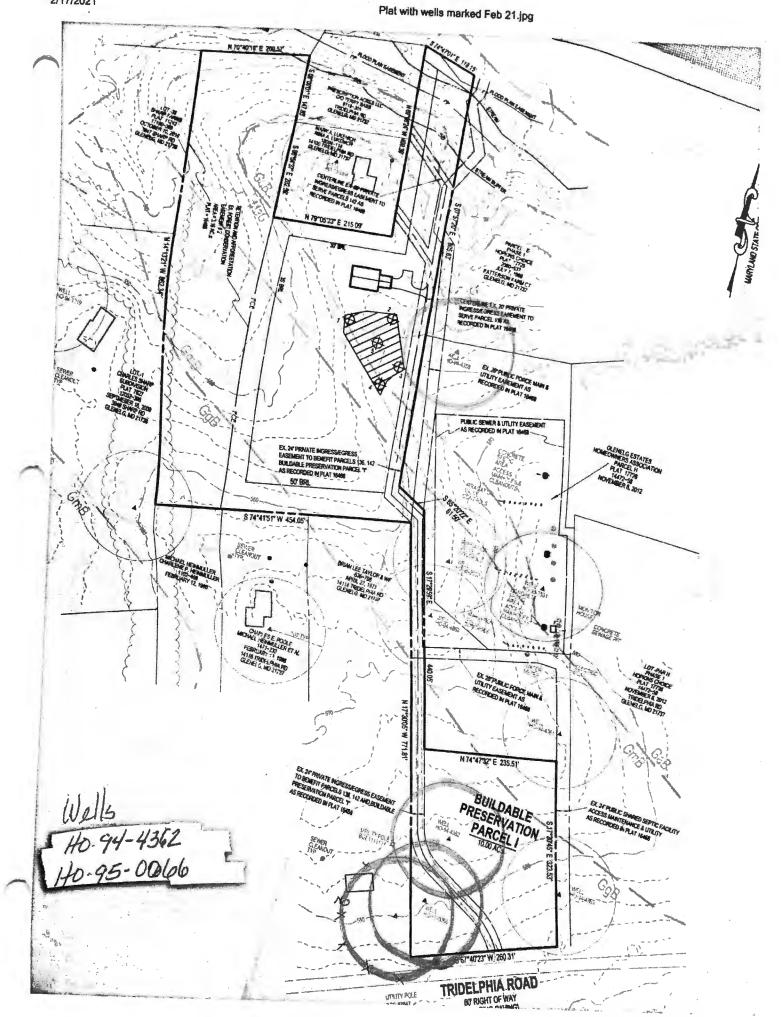

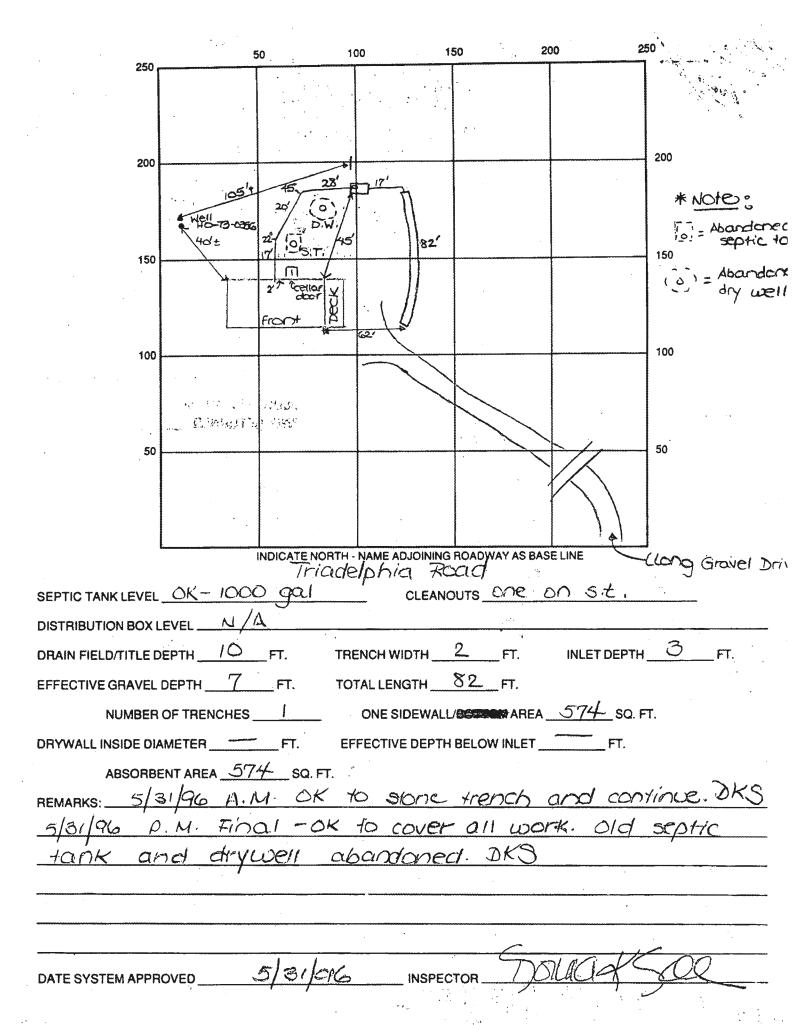

From:

Williams, Jeffrey

Sent:

Thursday, March 16, 2023 10:15 AM

To: Subject: Linda D. Alexander RE: hopkins choice

Attachments:

WS HopkinsChoice PercCert Jeff.pdf

Hi Linda. In digging through the file, we found the attached perc cert from 2004 where they identified a well box in the bottom corner. In looking at the neighboring lots, I don't see a problem with this location and we would prefer it to the spot by 14100 Triadelphia. That lot is very limited with future septic repair area and we don't want to add a well near there to complicate things any further. This corner spot I would just suggest trying to get it more in the corner to keep it from being downgrade of their own SDA as much as possible. The further out of the swale it is the better for that purpose.

Jeff

From: Linda D. Alexander < lalexander@clsimail.com>

Sent: Thursday, February 16, 2023 2:11 PM

To: Williams, Jeffrey < jewilliams@howardcountymd.gov>

Subject: hopkins choice

[Note: This email originated from outside of the organization. Please only click on links or attachments if you know the sender.]

Linda D. Alexander
Senior Associate / Senior Project Manager

CLSI

439 East Main Street, Westminster, MD. 21157 lalexander@clsimail.com direct: 410-871-4475

cell: 443-375-9903

From:

Williams, Jeffrey

Sent:

Thursday, June 29, 2023 7:47 AM

To:

Wayne Watkins; Linda D. Alexander

Subject:

RE: Hopkins Choice phase 1

Hi Wayne. I did have a chance to review with the Director, Mike. Looking at this location, we are back in the large swale with the well location downgrade of 3 individual SDA's and the shared disposal system. Given that, we were not comfortable recommending the variance for this location. I'm not sure there are any locations left other than using the existing well down by the road.

From: Wayne Watkins < watkinsjwayne@gmail.com>

Sent: Tuesday, June 27, 2023 8:49 AM

To: Williams, Jeffrey <jewilliams@howardcountymd.gov>; Linda D. Alexander <lalexander@clsimail.com>

Subject: Re: Hopkins Choice phase 1

[Note: This email originated from outside of the organization. Please only click on links or attachments if you know the sender.]

A few weeks ago I delivered a plan of Well Relocation for your review.

Before we prepare the variance request I need to know if you recommend approval, base on that plan.

In the variance request we would be using said plan as the exhibit

On Thu, May 18, 2023, 8:51 AM Wayne Watkins <watkinsjwayne@gmail.com> wrote:

Thanks, Will be back after we discuss with our client

On Thu, May 18, 2023, 8:20 AM Williams, Jeffrey < jewilliams@howardcountymd.gov > wrote:

I did look at it. If you can get it 200' from everything, we can take a look at it. My concern with that spot is that it is downgrade of 3 separate sewage disposal areas, none of which have advanced pre-treatment. If you want to pursue this area we would need to see you wedge in a well box or 3 well sites meeting 200' and have the owners sign a variance request form for the downgrade location. We could review and send to MDE for consideration if we recommend. Thanks

Jeff

From: Wayne Watkins <watkinsjwayne@gmail.com>

Sent: Tuesday, May 16, 2023 9:21 AM


To: Williams, Jeffrey < jewilliams@howardcountymd.gov >


Subject: Hopkins Choice phase 1


[Note: This email originated from outside of the organization. Please only click on links or attachments if you know the sender.]

Did you have a chance to look at the sketch on the well relocation I dropped off last week?

It the colored aerial showing the well in yellow

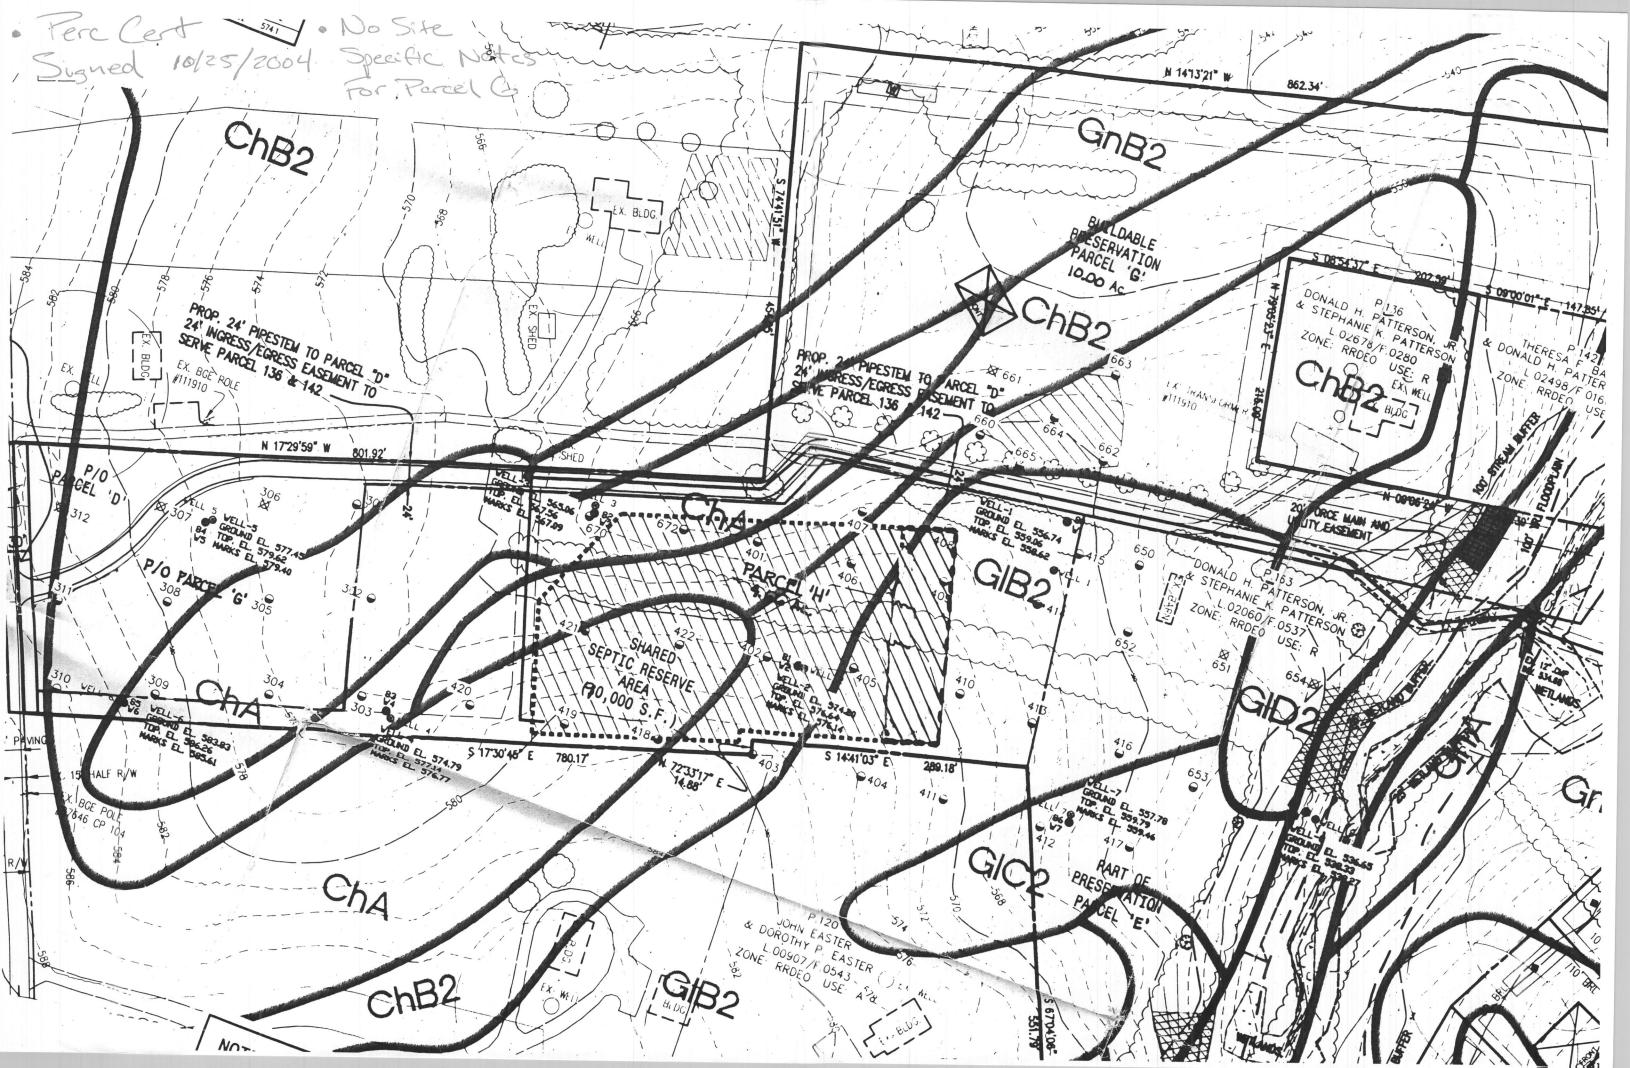

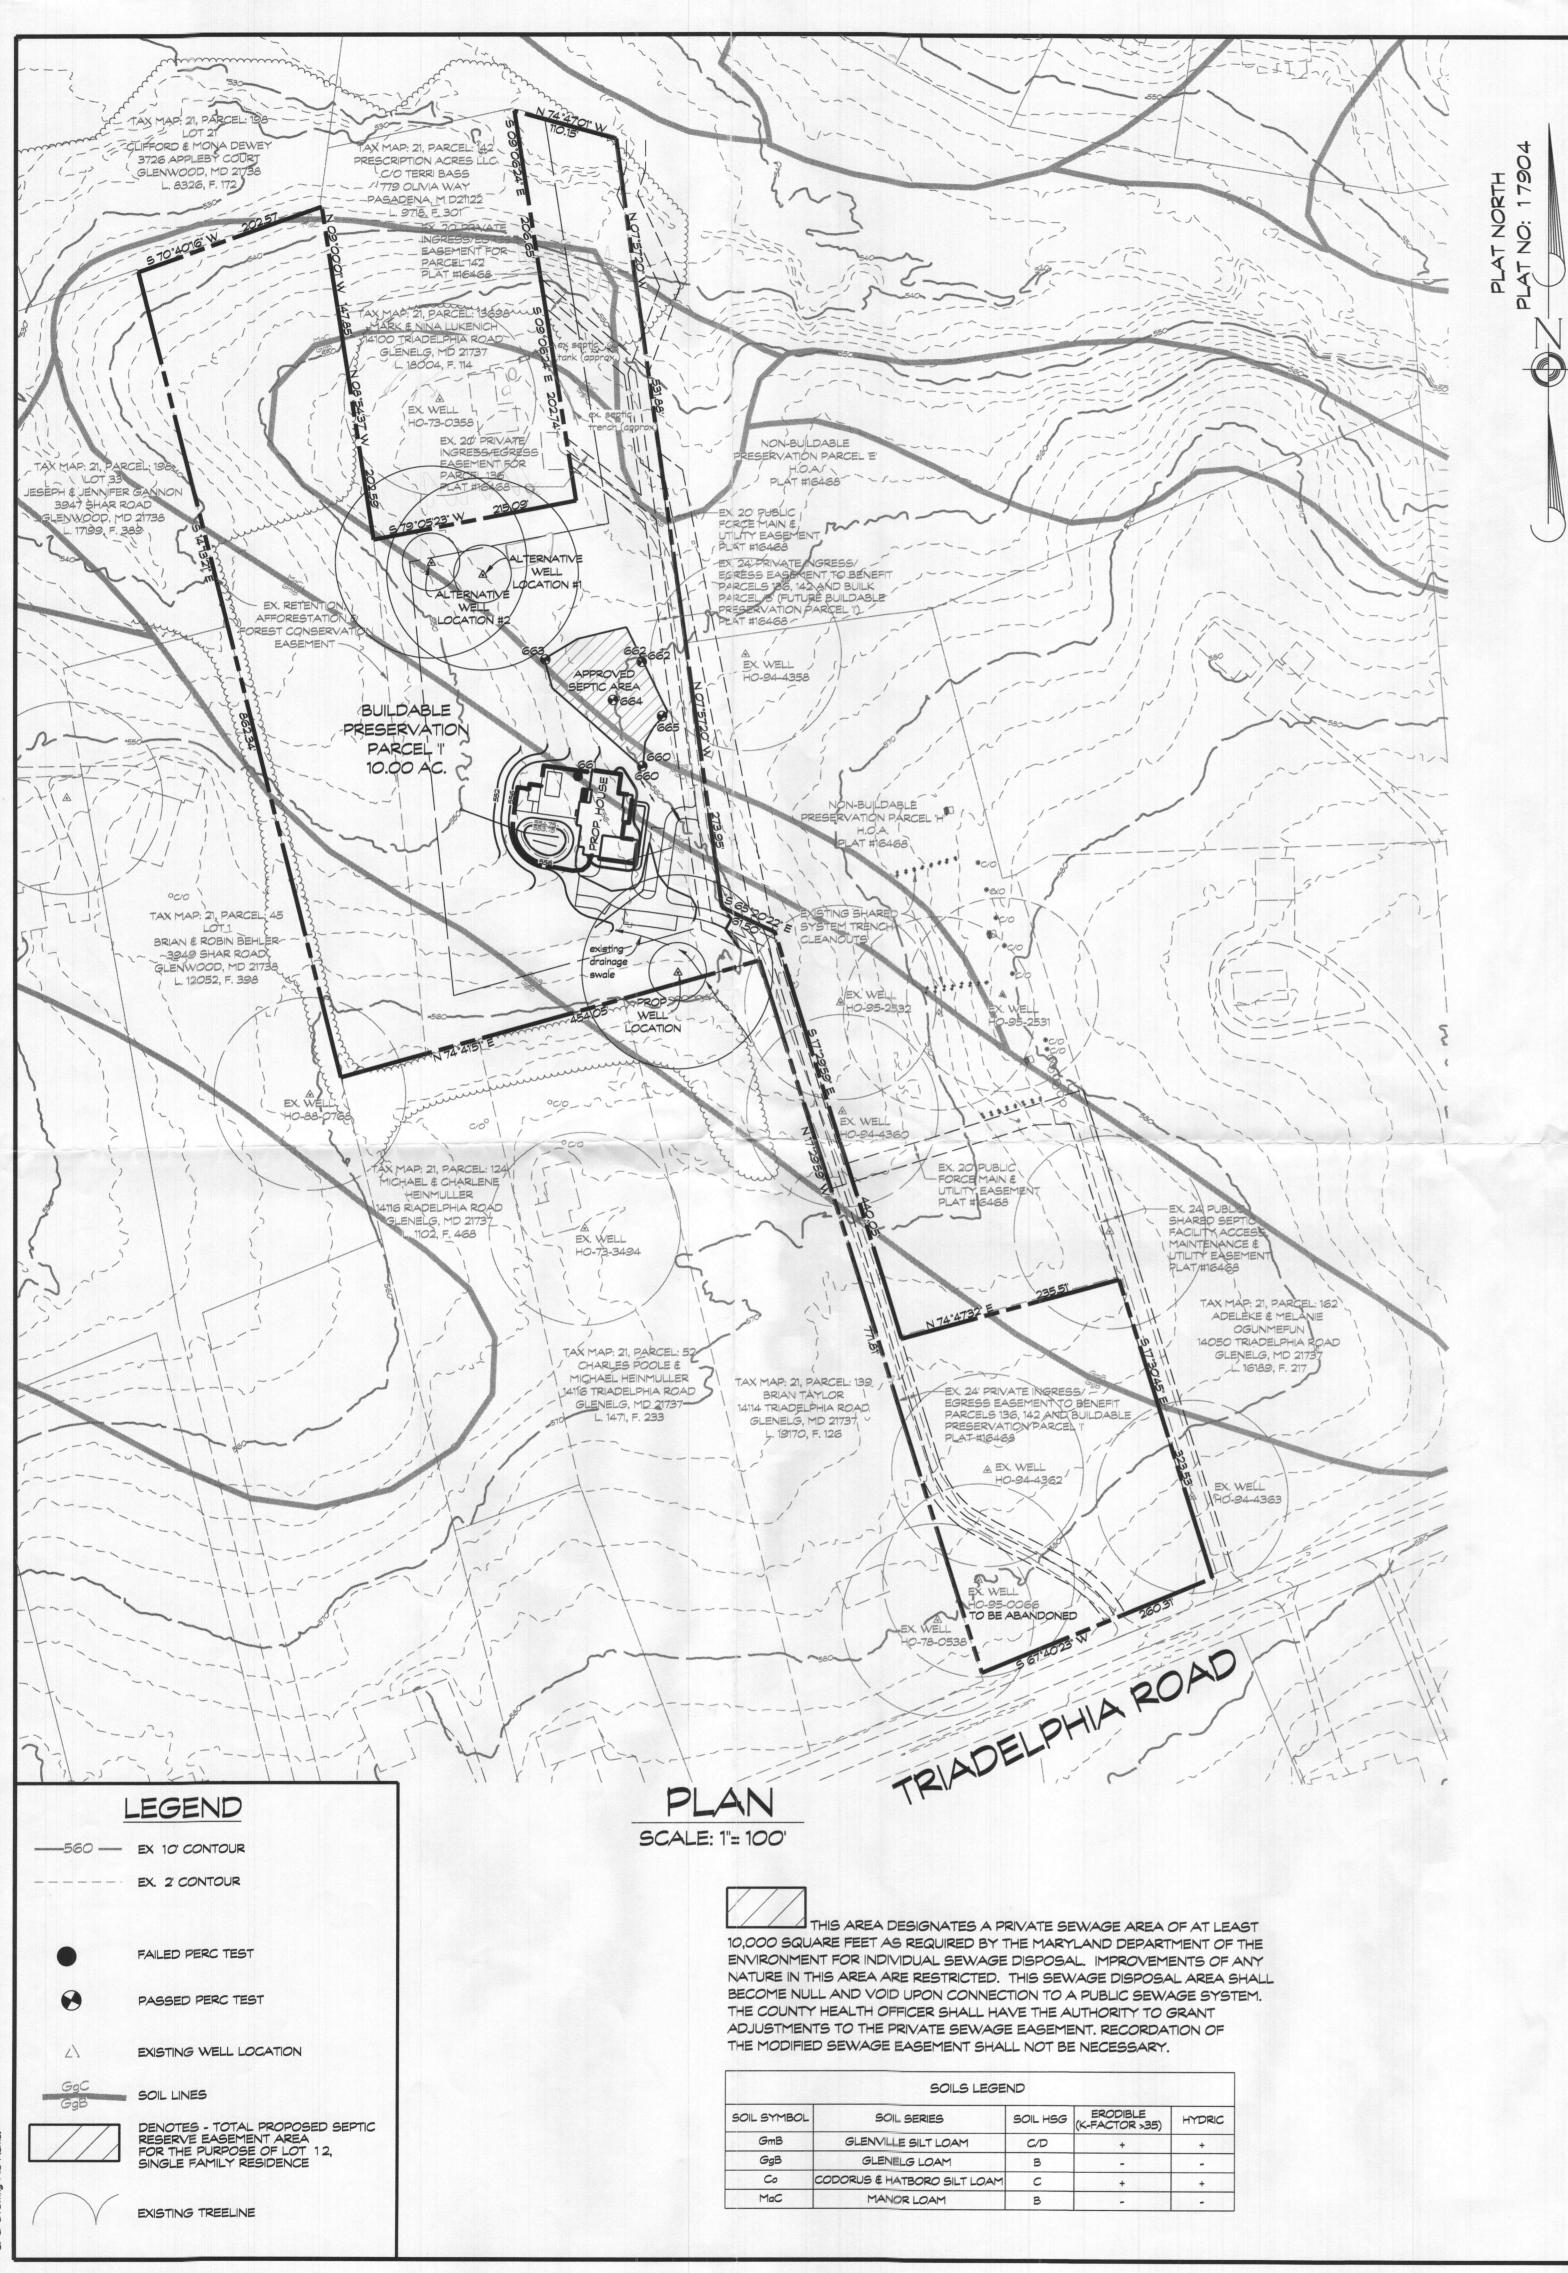

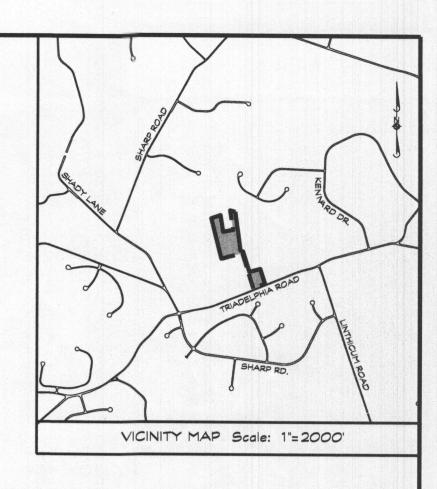

GENERAL NOTES

1. CURRENT TITLE REFERENCE:

OWNER: ERIC GWIN, ET AL

DEED REFERENCE: L. 21023, F. 483

DATE: OCTOBER 19, 2021

GRANTOR: DONALD PATTERSON JR.

2. THE LOT SHOWN HEREON COMPLIES WITH THE MINIMUM OWNERSHIP WIDTH AND LOT AREA AS REQUIRED BY THE MARYLAND STATE DEPARTMENT OF THE ENVIRONMENT.

3. THE TOPOGRAPHY SHOWN HEREON IS BASED ON HOWARD COUNTY 200' SCALE TOPO MAPS AND VERIFIED TO ACCURATELY REPRESENT THE RELATIVE CHANGES ON THE SUBJECT PROPERTY. TOPOGRAPHY OF THE SEWAGE DISPOSAL AREA WAS FIELD VERIFIED BY CLSI.

4. EXISTING WELLS AND/OR SEWER EASEMENTS WITHIN 100'
OF THE LOT LINES HAVE BEEN SHOWN. THERE ARE NO WELLS
200' DOWN GRADIENT OF THE SEPTIC EASEMENT AREA SHOWN.
5. ANY CHANGES TO THE PRIVATE SEWER EASEMENT AND/OR

5. ANY CHANGES TO THE PRIVATE SEWER EASEMENT AND/OR
 ALTERNATIVE WELL LOCATION SHALL REQUIRE A REVISED
 PERCOLATION CERTIFICATION PLAN.
 6. ALL STORMWATER MANAGEMENT DEVICES WILL MEET HOWARD

COUNTY SETBACKS TO ALL WELL SITES AND ON-SITE DISPOSAL SYSTEMS.

7. THE BOUNDARY SHOWN HEREON IS FROM PLAT TITLED HARLESS

MANOR PHASE 1 AND RECORDED IN PLAT M.D.R. NO. 12024. NO BOUNDARY SURVEYS WERE PERFORMED NOR CERTIFIED BY CLSI. 8. EX. WELL ON SITE TAG NUMBER HO-94-1454

9. THIS PLAN IS A BENEFIT TO THE CUSTOMER ONLY INSOFAR AS IT IS REQUIRED BY HOWARD COUNTY FOR THE PURPOSE OF THE APPROVAL OF THE PERCOLATION TEST. IT IS NOT TO BE RELIED UPON FOR THE ESTABLISHMENT OF BOUNDARY, EASEMENT OR RIGHT-OF-WAY LINES FOR ANY REASON, SUCH AS THE LOCATION OF FENCES, GARAGES, BUILDINGS OR FUTURE IMPROVEMENTS, OFFSETS OF BUILDING OR OTHER EXISTING OR FUTURE IMPROVEMENTS, OFFSETS OF BUILDINGS TO PROPERTY LINE ARE TO THE NEAREST FOOT (1) UNLESS OTHERWISE NOTED AND HAS AN ACCURACY OF ± 1 FOOT.

DATA TABULATIONS

ZONING DISTRICT: RR-DEO
 NUMBER OF BUILDING SITES: 1
 TOTAL AREA OF LOT: 10.00 ± ACRES

PURPOSE NOTE: THE PURPOSE OF THIS PERCOLATION CERTIFICATION PLAN IS TO SHOW A NEW WELL LOCATION CLOSER

TO THE PROPOSED HOUSE LOCATION.

OWNER/DEVELOPER

ERIC GWIN, ET AL

C/O MICHAEL SHARP

17005 HARDY ROAD

MT. AIRY, MD. 21771

PERC CERTIFICATION PLAN PARCEL I HOPKINS CHOICE - PHASE I

14080 TRIADELPHIA ROAD

PLAT NO. 17904
LIBER 21023, FOLIO 483
TAX MAP: 21 * BLOCK: 12 * PARCEL: 111
4th ELECTION DISTRICT * HOWARD COUNTY, MD

APPROVED FOR PRIVATE WATER AND SEWERAGE SYSTEM

"I HEREBY CERTIFY THAT THE INFORMATION SHOWN HEREON

IS BASED ON FIELD WORK PERFORMED BY ME OR UNDER MY

DIRECT SUPERVISION, AND IS CORRECT, TO THE BEST OF MY

JAVIER MORALES ROLDAN, PROFESSIONAL LAND SURVEYOR

HEALTH OFFICER, HOWARD COUNTY HEALTH DEPT.

HOWARD COUNTY HEALTH DEPARTMENT

KNOWLEDGE AND BELIEF."

NO. 21885 LICENSE EXPIRES 8/9/2023



439 East Main Street Westminster, MD 21157-5539 (410) 848-1790 FAX (410) 848-1791

Brian E. Wagner, P.E. (410) 848-1790 FAX (410) 848-1791

PROFESSIONAL CERTIFICATION: I HEREBY CERTIFY THAT THIS DOCUMENT WAS PREPARED OR APPROVED BY ME, AND THAT I AM A DULY LICENSED PROFESSIONAL ENGINEER UNDER THE LAWS OF THE STATE OF MARYLAND. LICENSE NO. 51063, EXPIRATION DATE: JUNE 7, 2023

Revisions

Revisions

Drawn By: MH

Designed By:

Reviewed By:


Date: JULY, 2021


Scale: AS SHOWN


Job No.: 20060 16


Sheet: 1 OF 2

County File No.

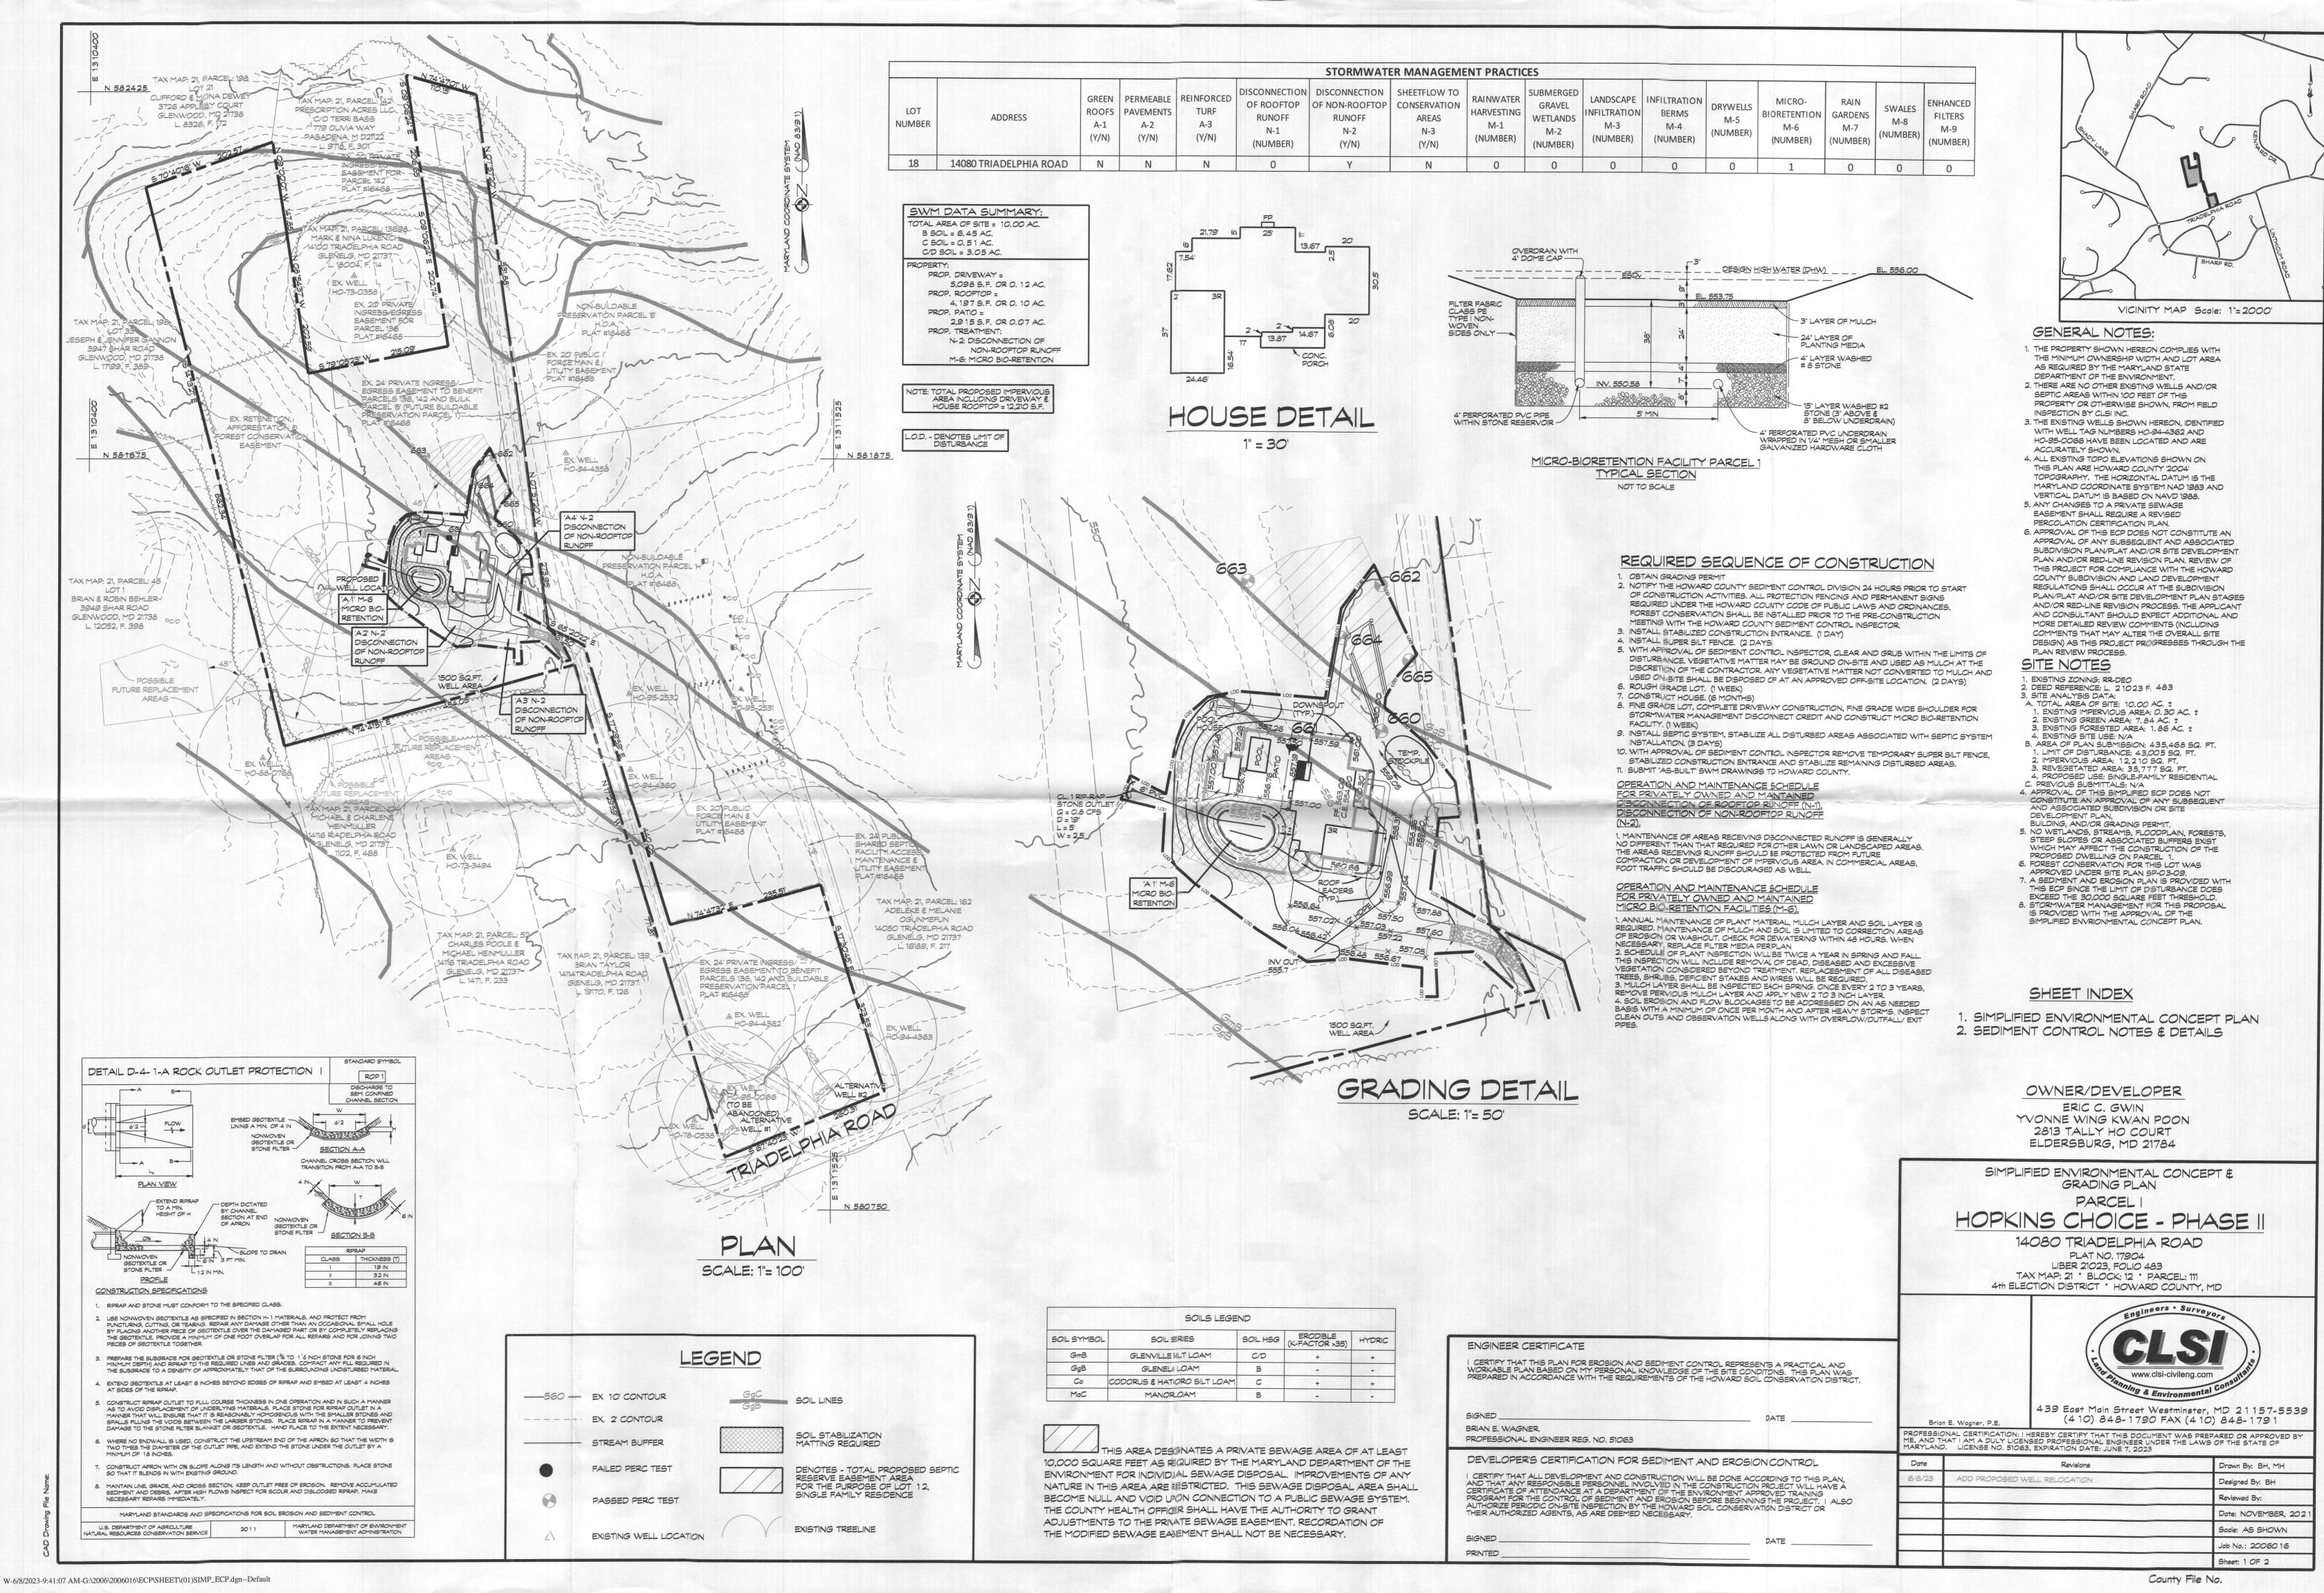

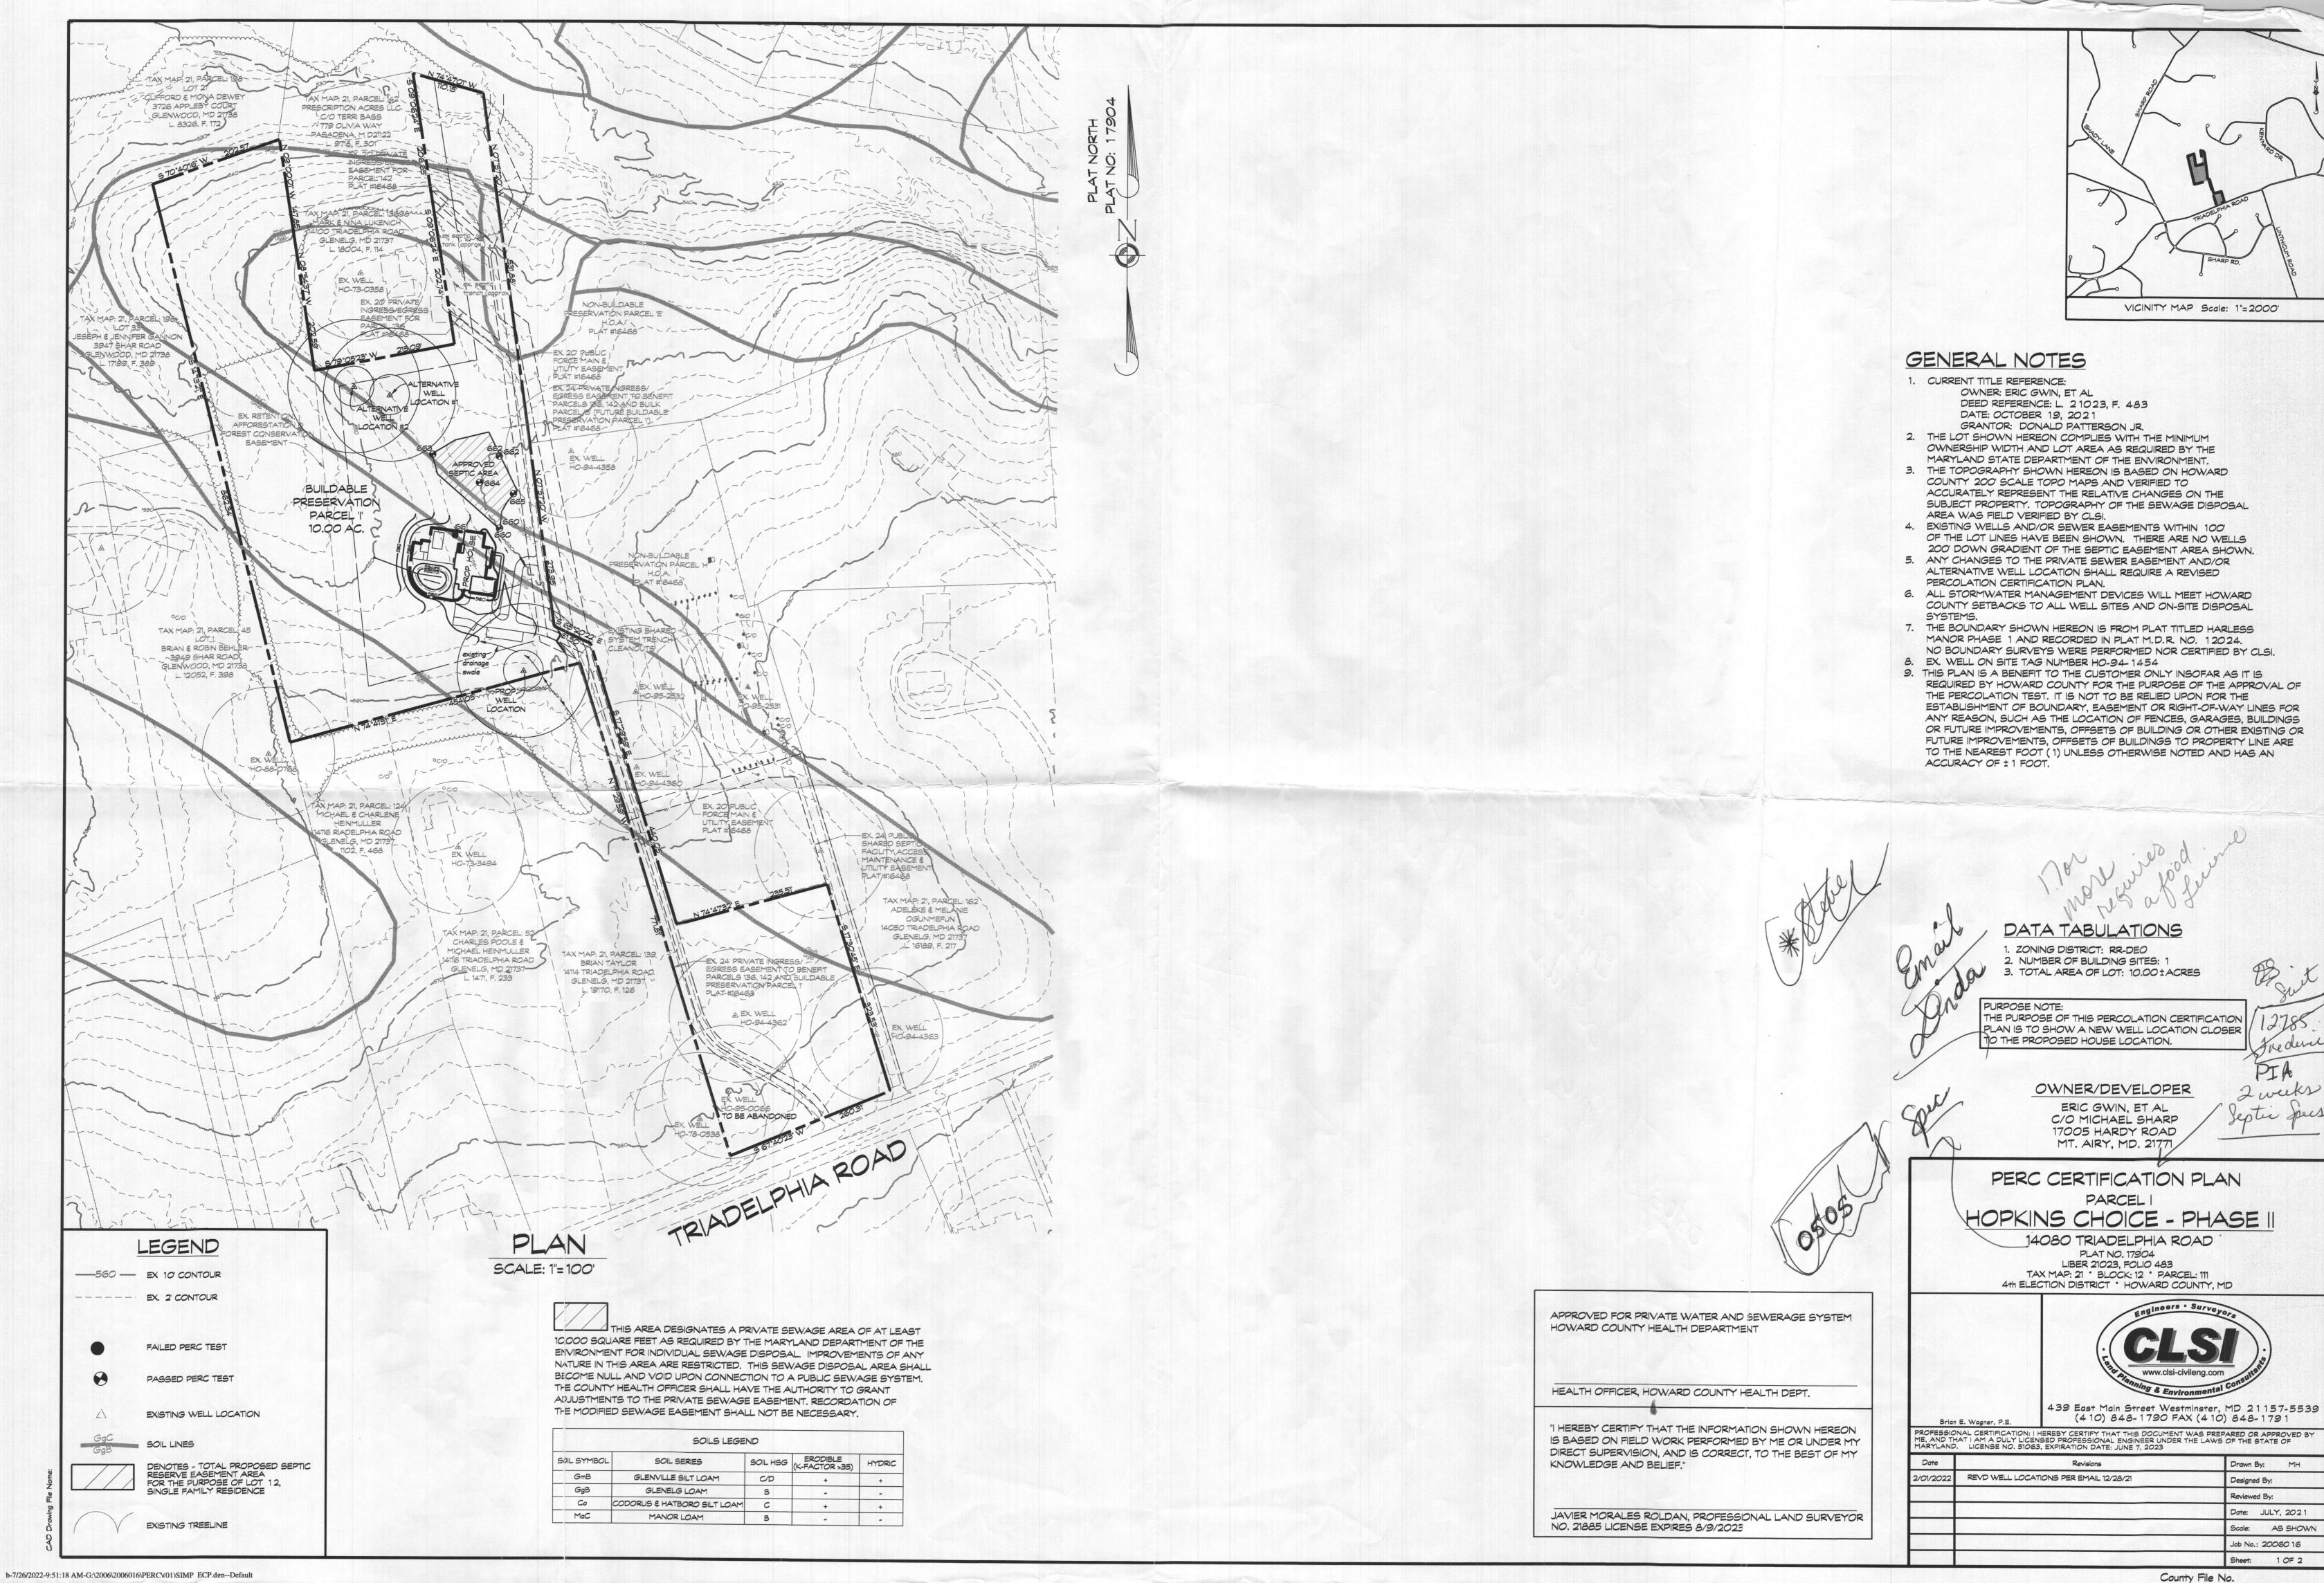

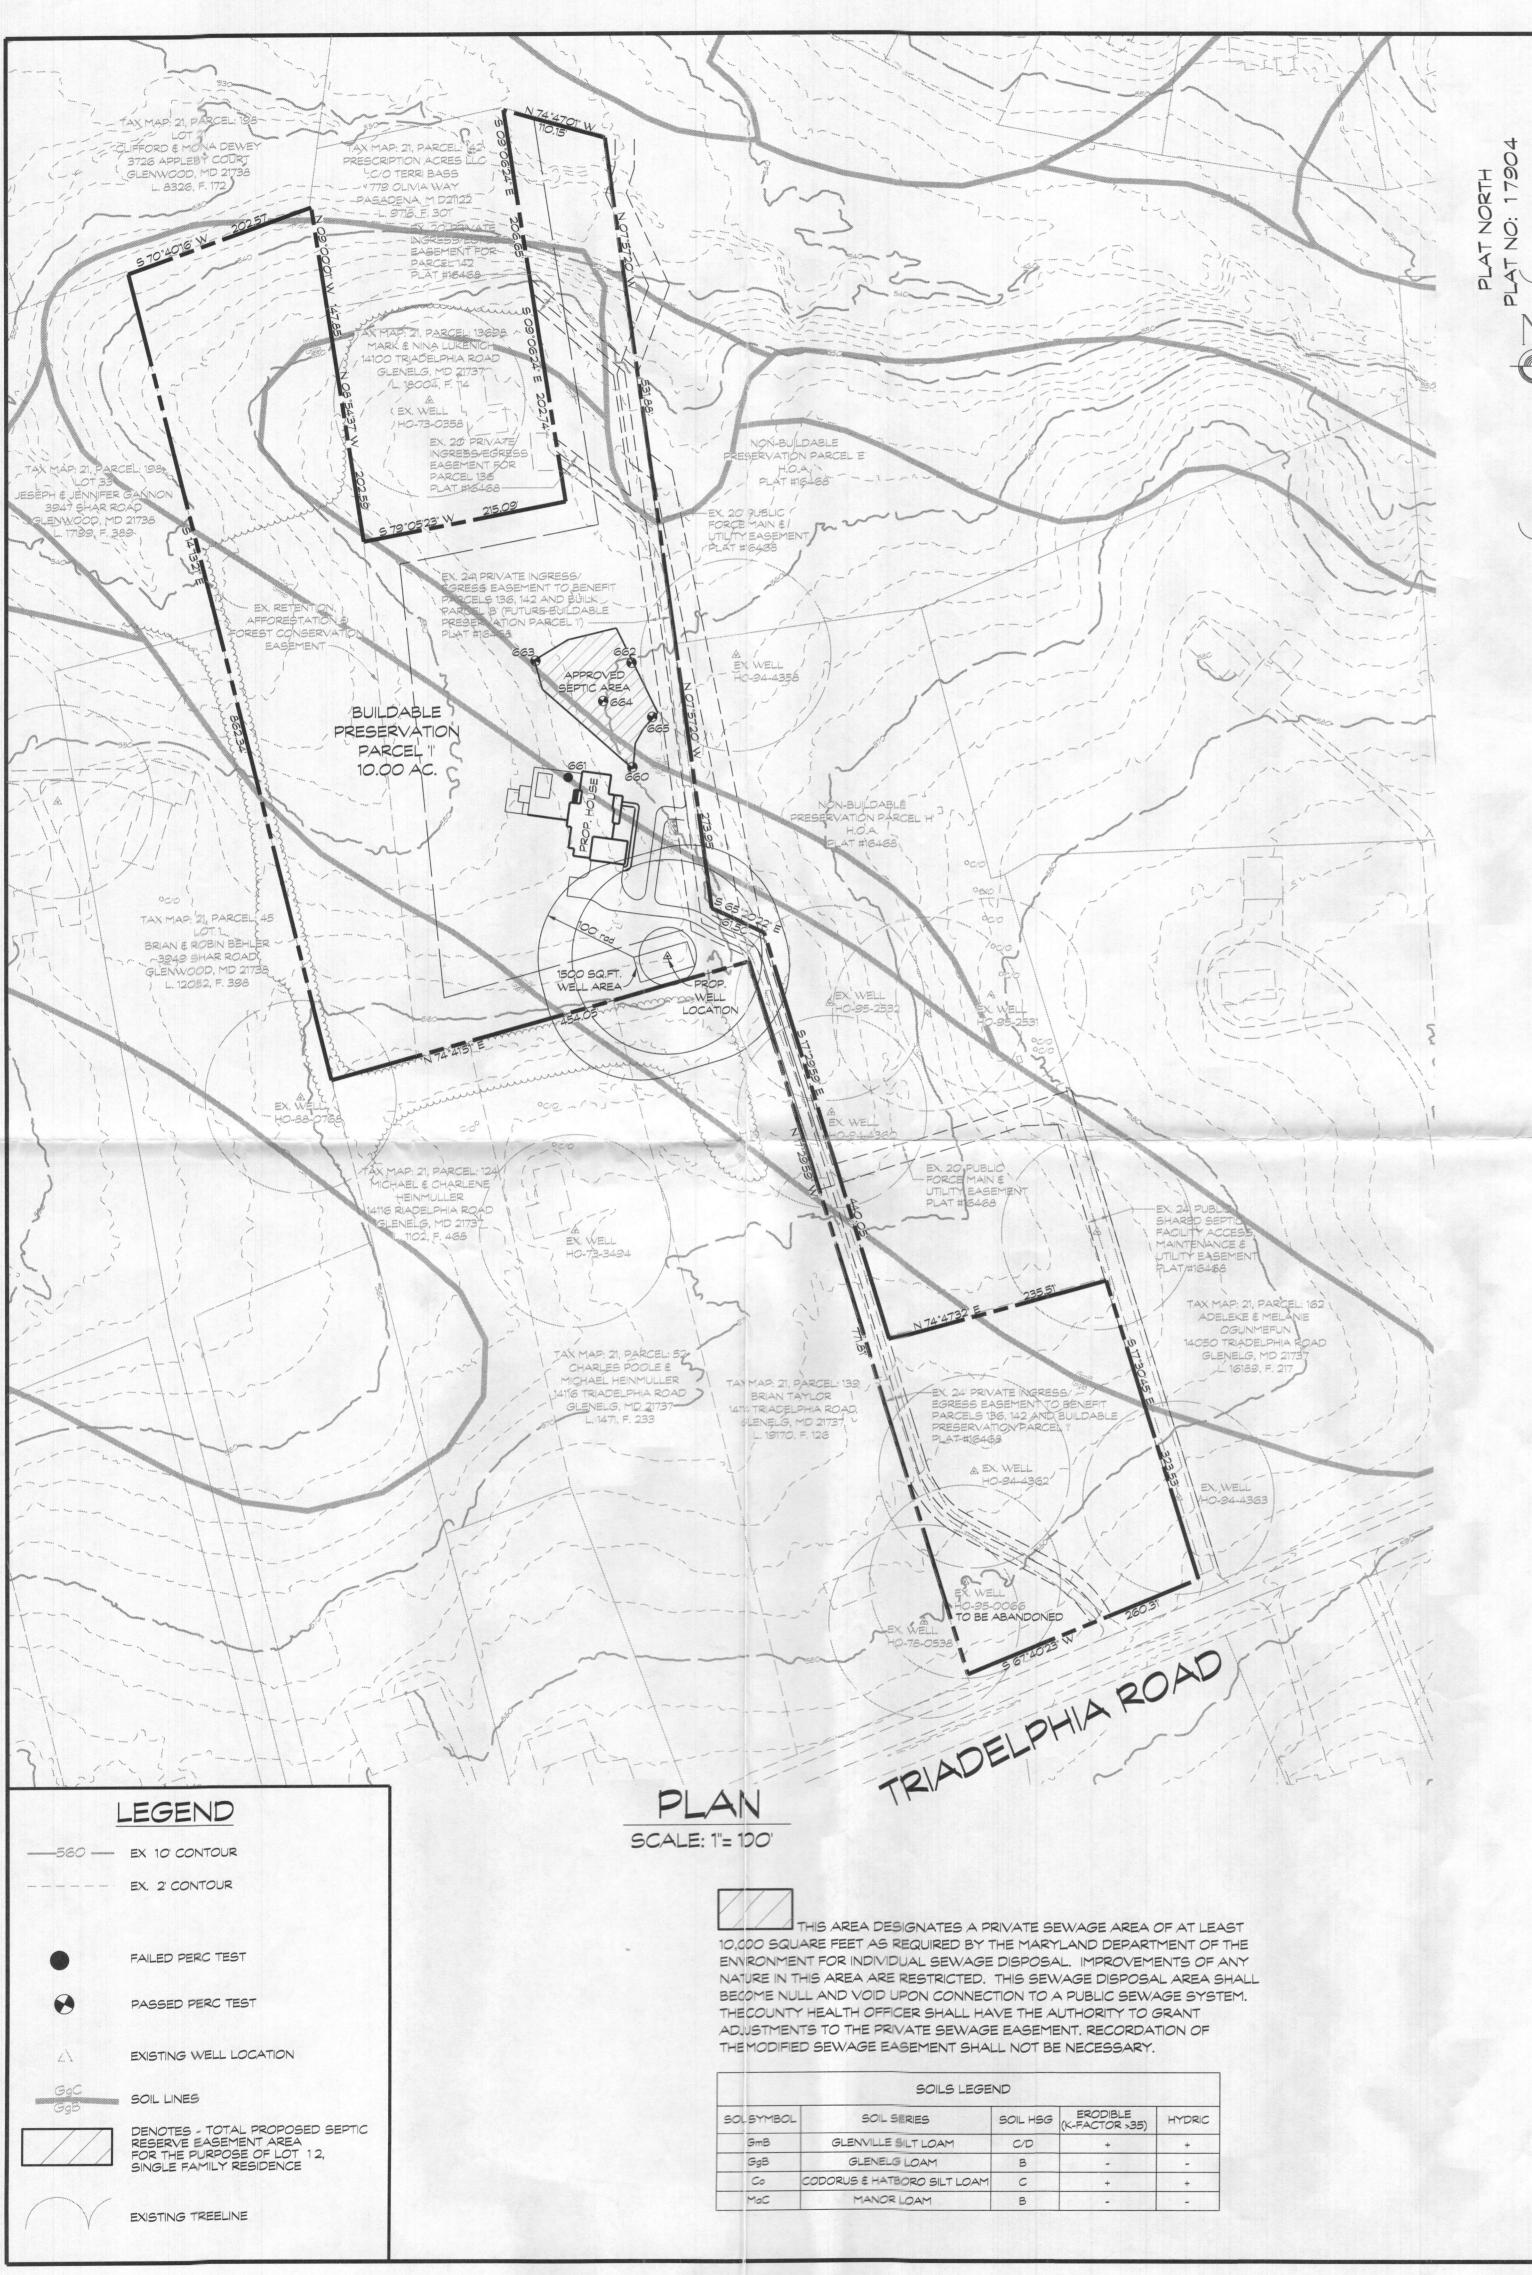

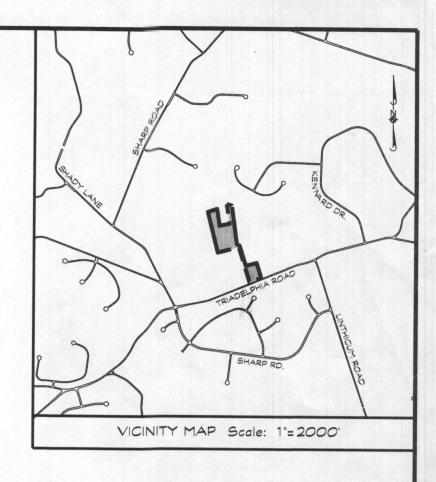

GENERAL NOTES

1. CURRENT TITLE REFERENCE: OWNER: ERIC GWIN, ET AL DEED REFERENCE: L. 21023, F. 483 DATE: OCTOBER 19, 2021

GRANTOR: DONALD PATTERSON JR. 2. THE LOT SHOWN HEREON COMPLIES WITH THE MINIMUM OWNERSHIP WIDTH AND LOT AREA AS REQUIRED BY THE MARYLAND STATE DEPARTMENT OF THE ENVIRONMENT.

- 3. THE TOPOGRAPHY SHOWN HEREON IS BASED ON HOWARD COUNTY 200' SCALE TOPO MAPS AND VERIFIED TO ACCURATELY REPRESENT THE RELATIVE CHANGES ON THE SUBJECT PROPERTY. TOPOGRAPHY OF THE SEWAGE DISPOSAL AREA WAS FIELD VERIFIED BY CLSI.
- 4. EXISTING WELLS AND/OR SEWER EASEMENTS WITHIN 100' OF THE LOT LINES HAVE BEEN SHOWN. THERE ARE NO WELLS 200' DOWN GRADIENT OF THE SEPTIC EASEMENT AREA SHOWN.
- 5. ANY CHANGES TO THE PRIVATE SEWER EASEMENT AND/OR ALTERNATIVE WELL LOCATION SHALL REQUIRE A REVISED PERCOLATION CERTIFICATION PLAN. 6. ALL STORMWATER MANAGEMENT DEVICES WILL MEET HOWARD
- COUNTY SETBACKS TO ALL WELL SITES AND ON-SITE DISPOSAL
- 7. THE BOUNDARY SHOWN HEREON IS FROM PLAT TITLED HARLESS MANOR PHASE 1 AND RECORDED IN PLAT M.D.R. NO. 12024. NO BOUNDARY SURVEYS WERE PERFORMED NOR CERTIFIED BY CLSI.
- 8. EX. WELL ON SITE TAG NUMBER HO-94-1454 9. THIS PLAN IS A BENEFIT TO THE CUSTOMER ONLY INSOFAR AS IT IS REQUIRED BY HOWARD COUNTY FOR THE PURPOSE OF THE APPROVAL OF THE PERCOLATION TEST. IT IS NOT TO BE RELIED UPON FOR THE ESTABLISHMENT OF BOUNDARY, EASEMENT OR RIGHT-OF-WAY LINES FOR

ANY REASON, SUCH AS THE LOCATION OF FENCES, GARAGES, BUILDINGS OR FUTURE IMPROVEMENTS, OFFSETS OF BUILDING OR OTHER EXISTING OR FUTURE IMPROVEMENTS, OFFSETS OF BUILDINGS TO PROPERTY LINE ARE TO THE NEAREST FOOT (1) UNLESS OTHERWISE NOTED AND HAS AN ACCURACY OF ± 1 FOOT.

DATA TABULATIONS

1. ZONING DISTRICT: RR-DEO 2. NUMBER OF BUILDING SITES: 1 3. TOTAL AREA OF LOT: 10.00 + ACRES

PURPOSE NOTE:

APPROVED FOR PRIVATE WATER AND SEWERAGE SYSTEM

"I HEREBY CERTIFY THAT THE INFORMATION SHOWN HEREON

IS BASED ON FIELD WORK PERFORMED BYME OR UNDER MY

DIRECT SUPERVISION, AND IS CORRECT, TO THE BEST OF MY

JAVIER MORALES ROLDAN, PROFESSIONAL LAND SURVEYOR

HOWARD COUNTY HEALTH DEPARTMENT

KNOWLEDGE AND BELIEF."

NO. 21885 LICENSE EXPIRES 8/9/2023

HEALTH OFFICER, HOWARD COUNTY HEALTH DEPT.

THE PURPOSE OF THIS PERCOLATION CERTIFICATION PLAN IS TO SHOW A NEW WELL LOCATION CLOSER TO THE PROPOSED HOUSE LOCATION.

OWNER/DEVELOPER

ERIC GWIN, ET AL C/O MICHAEL SHARP 17005 HARDY ROAD MT. AIRY, MD. 21771

PERC CERTIFICATION PLAN PARCEL

HOPKINS CHOICE - PHASE II 14080 TRIADELPHIA ROAD

PLAT NO. 17904 LIBER 9718, FOLIO 296

TAX MAP: 21 * BLOCK: 12 * PARCEL: 111
4th ELECTION DISTRICT * HOWARD COUNTY, MD



439 East Main Street Westminster, MD 21157-5539 (410) 848-1790 FAX (410) 848-1791

PROFESSIONAL CERTIFICATION: I HEREBY CERTIFY THAT THIS DOCUMENT WAS PREPARED OR APPROVED BY ME, AND THAT I AM A DULY LICENSED PROFESSIONAL ENGINEER UNDER THE LAWS OF THE STATE OF MARYLAND. LICENSE NO. 51063, EXPIRATION DATE: JUNE 7, 2023

Drawn By: MH Designed By: Reviewed By: Date: JULY, 2021 Scale: AS SHOWN Job No.: 20060 16 Sheet: 1 OF 2

County File No.

c-11/1/2021-5:47:06 PM-G:\2006\2006016\PERC\(01)SIMP ECP.dgn--Default