

APPLICATION

A 24333

P _____

SEWAGE DISPOSAL TESTING

STATE OF MARYLAND - DEPARTMENT OF HEALTH AND MENTAL HYGIENE

HOWARD COUNTY HEALTH DEPARTMENT
ENVIRONMENTAL HEALTH SERVICES
P. O. BOX 476, ELLICOTT CITY, MARYLAND 21043
TELEPHONE: 465-5000, EXT. 356

DISTRICT _____

DATE _____

*Note: This lot consists of Lot 13D, 14D, 15D or part of 16D on testing plat
See separate sheet on specs
Install septic system before building
TO: THE COUNTY HEALTH OFFICER
ELLICOTT CITY, MARYLAND
permit issued RH*

I, HEREBY, APPLY FOR THE NECESSARY TEST IN ORDER TO CONSTRUCT (OR RECONSTRUCT) A SEWAGE DISPOSAL SYSTEM.

PROPERTY OWNER KERWIN Miller
GREEN HILL MANOR VINELLA

ADDRESS _____ PHONE _____

PROPERTY LOCATION:

SUBDIVISION GREEN HILL MANOR LOT NO. 7 *(Several lots from Sect 4 combined)*

ROAD AND DESCRIPTION Cluster Court Lot B on Sect 4 of final
13491 Villa d'est DR.

SIZE OF LOT Must check final for location of lots TYPE BLDG. _____ NUMBER OF BEDROOMS _____

IF NOT SINGLE RESIDENCE, DESCRIBE _____

THE SYSTEM INSTALLED UNDER THIS APPLICATION IS ACCEPTABLE ONLY UNTIL PUBLIC FACILITIES BECOME AVAILABLE.

SIGNATURE OF APPLICANT _____

APPROVED BY Raymond Hodge FOR Dry Well DATE 10/27/77
(KIND OF SYSTEM)

REJECTED BY _____ FOR _____ DATE _____
(KIND OF SYSTEM)

HOLD PENDING FURTHER TESTS _____ DATE _____


REASONS FOR REJECTION OR HOLDING 3/9/77 Perc OK Hold for Plat RH
Final Plat OK 10/27/77 RH

BLDG. PERMIT SIGNED AND RETURNED 5-10-88

BP18370 *SM*

THIS IS NOT A PERMIT

Site plat for
Layout of
holes

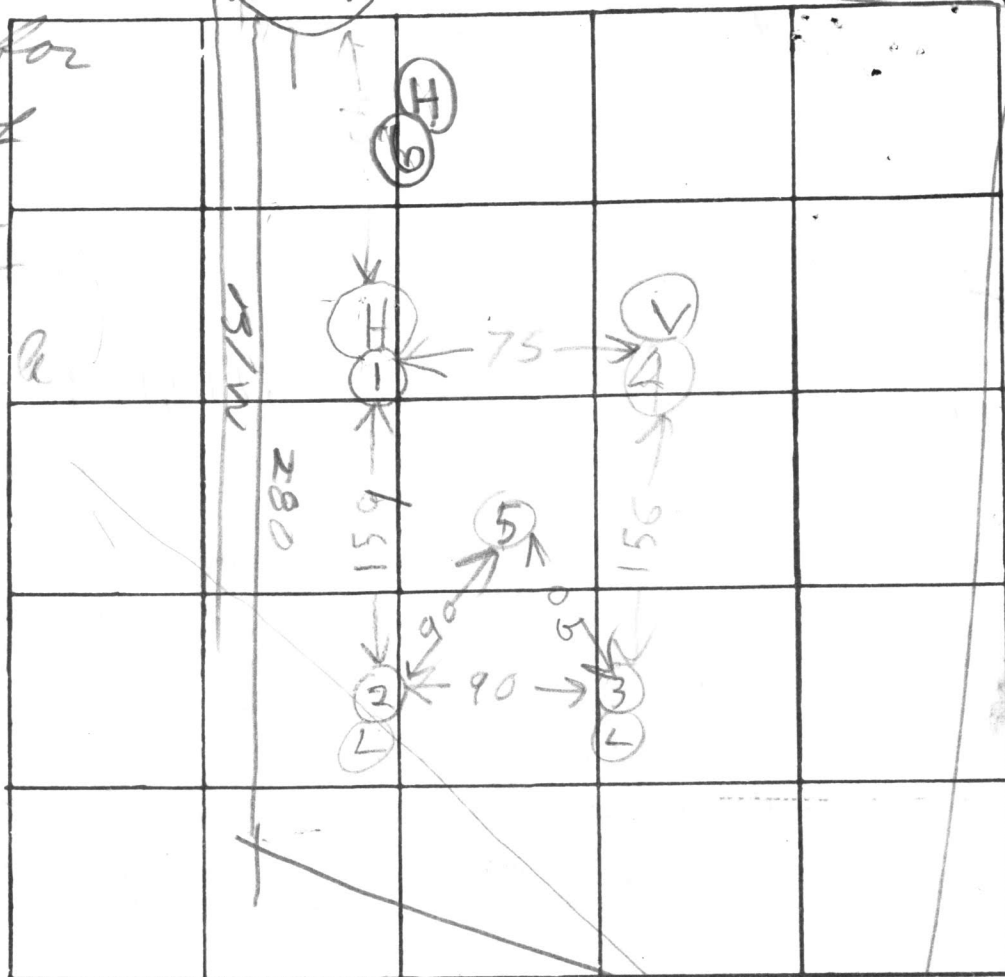

INDICATE NORTH. - NAME ADJOINING ROADWAY AS BASE-LINE

159
159

DATE	TEST NO.	DEPTH	PRE-WET		TEST - 1" DROP		TIME
			START	STOP	START	STOP	
3/9/77	1D	12	1019	1021	1021	1027	6
	1S	5	1019	1022	1022	1027	5
	2D	13	1026	1028	1028	1037	9
	2S	6	1026	1028	1028	1032	4
	3D	13 1/2	1036	1040	1040	1045	5
	3S	6 1/2	1036	1040	1040	1044	7
	4V	13	TOP BOT	2 FT 11 FT	CLAY SANDY	DRY	
3/9/77	5V	13	TOP BOT	2 FT 11 FT	CLAY SANDY		
4/11/78	6S	14	1254	1257	1257	1058	8
4/11/78	6D	6	1254	1257	1257	1058	8

17022
ELEVATION

① HIGH
② USE
FOR DW
② = LOW
③ = LOW
④ = HIGH

REMARKS

TYPE OF SOIL

TESTED BY

R. HODGES

ALSO PRESENT:

J. FYOCIC
VIINELLA

Lot 1