



# APPLICATION

## FOR PERCOLATION TESTING AND SITE EVALUATION

TEST DATE(S) \_\_\_\_\_ TEST TIME \_\_\_\_\_ AP 522884

AGENCY REVIEW: \_\_\_\_\_ DATE 7/8/05

DO NOT WRITE ABOVE THIS LINE

I HEREBY APPLY FOR THE NECESSARY TESTING/EVALUATION PRIOR TO ISSUANCE OF SEWAGE DISPOSAL SYSTEM PERMIT(S) TO:

CHECK AS NEEDED:

- CONSTRUCT NEW SEPTIC SYSTEM(S)
- REPAIR/ADD TO AN EXISTING SEPTIC SYSTEM
- REPLACE AN EXISTING SEPTIC SYSTEM

CHECK AS NEEDED:

- NEW STRUCTURE(S)
- ADDITION TO AN EXISTING STRUCTURE
- REPLACE AN EXISTING STRUCTURE

CHECK ONE:

- CREATE NEW LOT(S)
- BUILD ON AN EXISTING LOT IN A SUBDIVISION
- BUILD ON AN EXISTING PARCEL OF RECORD

IS THE PROPERTY WITHIN 2500' OF ANY RESERVOIR?

- YES PART 13.
- NO

THE TYPE OF STRUCTURE IS:

- RESIDENTIAL WITH 4 TO 5 PROPOSED BEDROOMS IN THE COMPLETED STRUCTURE (NOTE **UNKNOWN** IF APPROPRIATE)
- COMMERCIAL (PROVIDE DETAIL OF NUMBERS AND TYPES OF EMPLOYEES/ CUSTOMERS ON ACCOMPANYING PLAN)
- INSTITUTIONAL/GOVERNMENT (PROVIDE DETAIL OF NUMBERS AND TYPES OF EMPLOYEES/USERS ON ACCOMPANYING PLAN)

PROPERTY OWNER(S) WALTER & EVERLY JUSTIN

DAYTIME PHONE 443-367-0422 CELL \_\_\_\_\_ FAX \_\_\_\_\_

MAILING ADDRESS 11903 LIME KILN ROAD FUCTON MD 20759  
STREET CITY/TOWN STATE ZIP

APPLICANT DONALD R. REUWER

DAYTIME PHONE 443-367-0422 CELL \_\_\_\_\_ FAX 443-367-0420

MAILING ADDRESS 5300 TORREY HALL DRIVE ELLICOTT CITY, MD 21042  
STREET CITY/TOWN STATE ZIP

APPLICANT'S ROLE: DEVELOPER BUILDER BUYER RELATIVE/FRIEND REALTOR CONSULTANT

PROPERTY LOCATION  
SUBDIVISION/PROPERTY NAME JUSTIN PROPERTY LOT NO. 8

PROPERTY ADDRESS 11903 LIME KILN ROAD FUCTON, MD 20759  
STREET TOWN/POST OFFICE

TAX MAP PAGE(S) 46 GRID 1 PARCEL(S) 103 & 184 PROPOSED LOT SIZE 1 Act



AS APPLICANT, I UNDERSTAND THE FOLLOWING: THE SYSTEM INSTALLED SUBSEQUENT TO THIS APPLICATION IS ACCEPTABLE ONLY UNTIL PUBLIC SEWERAGE IS AVAILABLE. THIS APPLICATION IS COMPLETE WHEN ALL APPLICABLE FEES AND A SUITABLE SITE PLAN HAVE BEEN RECEIVED. I ACCEPT THE RESPONSIBILITY FOR COMPLIANCE WITH ALL M.O.S.H.A. AND "MISS UTILITY" REQUIREMENTS. APPROVAL IS BASED UPON SATISFACTORY REVIEW OF A PERC CERTIFICATION PLAN.

TEST RESULTS WILL BE MAILED TO APPLICANT.

SIGNATURE OF APPLICANT

HOWARD COUNTY HEALTH DEPARTMENT, BUREAU OF ENVIRONMENTAL HEALTH, WELL AND SEPTIC PROGRAM  
3525-H ELLICOTT MILLS DRIVE, ELLICOTT CITY, MARYLAND 21043-4544 (410) 313-1771 FAX (410) 313-2648  
TDD (410) 313-2323 TOLL FREE 1-877-4MD-DHMH

A/P

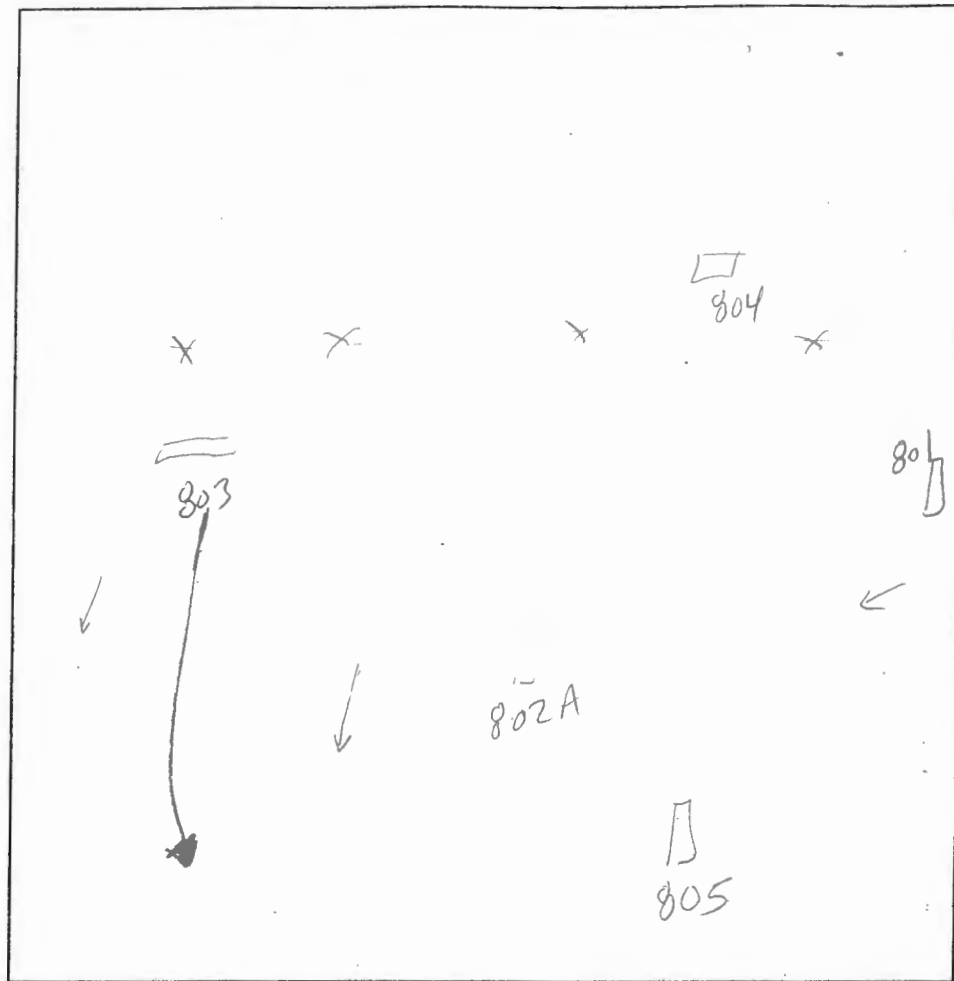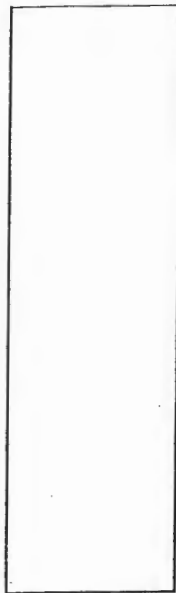

5  
brown L  
1'  
wk orange brown  
sil sg  
cw sbk  
micaceous  
5% gravel/chert

2A  
brown L  
11'  
orange brown  
hl -> sil  
micaceous  
cw sbk  
5'  
orange brown  
sil sg  
cw sbk  
micaceous  
5% gravel

3  
brown L  
1'  
orange brown  
hl -> sil  
micaceous  
cw sbk  
6.5'  
yellow brown  
sil  
micaceous  
cw sbk  
5% gravel

4  
brown L  
1'  
orange brown  
sil sg  
cobble/clay  
cw sbk  
6'  
yellow/orange brown  
sil sg  
micaceous  
5% gravel/chert

1  
brown L  
weak orange brown  
hl - sil  
cw sbk  
5% gravel  
~7.5'  
orange brown  
sil  
cw sbk  
micaceous  
12'

DATE	TEST #	DEPTH	START	BREAK 1" DROP	STOP 2" DROP	TIME OF 2nd INCH	P/F/H
8/24/05	804	6' / 12'	12:30	12:32	12:35	3	P
	1	7'5" / 12'	1:37	1:47	1:57	10	P
	5	3' / 12'6"	1:14 <sup>50</sup>	1:16 <sup>20</sup>	1:18 <sup>52</sup>	2	P
	2A	4'7" / 11'7"	1:21 <sup>26</sup>	1:23	1:27	4	P
	803	5'5" / 12'	1:29 <sup>01</sup>	1:36	1:46	10	P
	lots	6/7					

REMARKS Holes dug per plan - 2A restaked due to original being located in a full area.  
 SANITARIAN SF BACKHOE AEC (Mike J) OTHERS Rob Webster  
 TEST HOLES USED IN SDA \_\_\_\_\_ AVG. PERC TIME 6 SQ. FT/BR \_\_\_\_\_  
 TRENCH WIDTH \_\_\_\_\_ INLET DEPTH \_\_\_\_\_ MAX. BOT DEPTH \_\_\_\_\_ EFFECTIVE SW \_\_\_\_\_

ACRES  
No. 6858

perc cert

Non-Suitable  
Preservation  
Parcel C

-Suitable  
Preservation  
Parcel B

99B  
AREA TO  
BE ADDED  
712  
423.52

15,495 SQ.FT.  
711  
419.00

GRAVEYARD

Ex. House To  
Be Converted To  
Accessory Storage  
Ex. Kitchen & Bath  
To Be Removed

MaC

GnB

Wetland  
Area

