

PRELIMINARY

# APPLICATION

A 27720

P \_\_\_\_\_

## SEWAGE DISPOSAL TESTING

STATE OF MARYLAND - DEPARTMENT OF HEALTH AND MENTAL HYGIENE

HOWARD COUNTY HEALTH DEPARTMENT  
ENVIRONMENTAL HEALTH SERVICES  
P. O. BOX 476, ELLICOTT CITY, MARYLAND 21043  
TELEPHONE: 465-5000, EXT. 356

DISTRICT 5th

DATE 3/30/78

DEEP DITCH - 120 SOFT PER BED ROOM ONE SIDE  
OF DITCH DITCH TO BE 9 FT DEEP FILLED WITH 4 FT  
OF STONE (EXAMPLE 90 FT LONG FOR 3 BEDROOMS)  
RUN THE DITCH BETWEEN PERC HOLE ③ & PERC HOLE ①  
PERC HOLE ① IS LOCATED 15 FT FROM THE FRONT LOT LINE  
& 15 FT FROM THE LEFT SIDE OF THE LOT AS SEEN  
TO: THE COUNTY HEALTH OFFICER WHEN FACING THE LOT FROM  
ELLICOTT CITY, MARYLAND WILLIEST DRIVE

I, HEREBY, APPLY FOR THE NECESSARY TEST IN ORDER TO CONSTRUCT (OR RECONSTRUCT) A SEWAGE  
DISPOSAL SYSTEM. PERC HOLE ③ IS LOCATED 120 FT FROM THE  
FRONT LOT LINE & 15 FT FROM THE LEFT

PROPERTY OWNER V. L. Vinella SIDE OF THE LOT AS SEEN  
ADDRESS 12631 Circle Drive, Rockville, Md. 20850 PHONE Boender - 465-7777

OWNER Kerwin Miller

PROPERTY LOCATION:  
SUBDIVISION Green Hill Manor LOT NO. 2, Sec. 5  
ROAD AND DESCRIPTION 13506/13514 Villa D'Est Drive

SIZE OF LOT ? TYPE BLDG. 3 or 4 bedrooms  
NUMBER OF BEDROOMS

IF NOT SINGLE RESIDENCE DESCRIBE \_\_\_\_\_

THE SYSTEM INSTALLED UNDER THIS APPLICATION IS ACCEPTABLE ONLY UNTIL PUBLIC  
FACILITIES BECOME AVAILABLE.

SIGNATURE OF APPLICANT /s/ Dennis Rush

APPROVED BY Raymond Boender FOR DITCH DATE 3/17/80  
(KIND OF SYSTEM)

REJECTED BY \_\_\_\_\_ FOR \_\_\_\_\_ DATE \_\_\_\_\_  
(KIND OF SYSTEM)


HOLD PENDING FURTHER TESTS \_\_\_\_\_ DATE \_\_\_\_\_

REASONS FOR REJECTION OR HOLDING 4/5/78 PERC OK HOLD FOR PLAT R/L  
3/17/80 PERC OK

BOGD. PERMIT SIGNED AND RETURNED 5/16/80  
BOGD. PERMIT SIGNED AND RETURNED 12-2-88  
BP 22810  
SAE  
BP 18372

# THIS IS NOT A PERMIT

lot #2

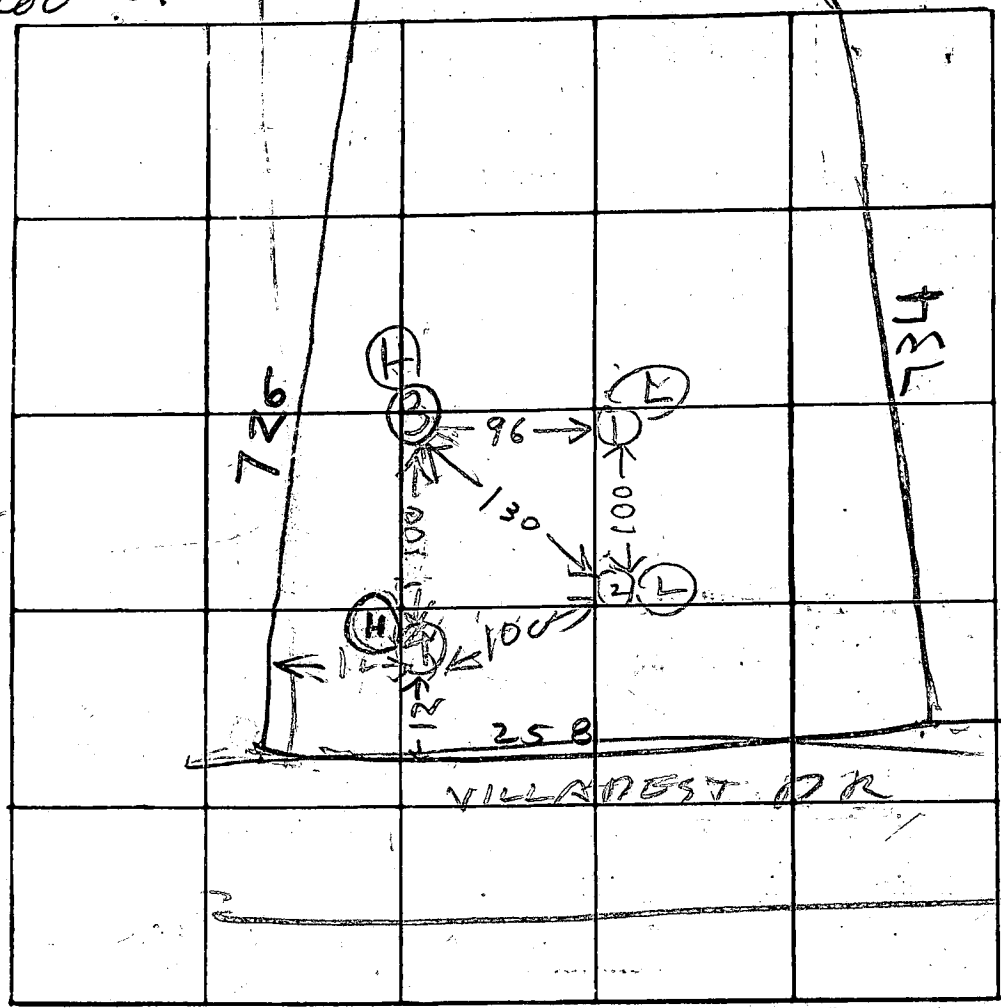

INDICATE NORTH - NAME ADJOINING ROADWAY AS BASE LINE

DATE	TEST NO.	DEPTH	PRE-WET		TEST - 1" DROP		TIME
			START	STOP	START	STOP	
4/5/78	1D	14 1/2	1115	1125	1125	1238	12
	1S	3 1/2	1115	1120	1120	1124	4
	2D	12	1126	1134	1134	1150	16
	2S	4	1127	1128	1128	1137	3
	3D	12 1/2	1150	1210	little pen		
	3S	5	1150	1155	1155	1204	9
	3M	8	1257	1000	100	100	6
	4S	5	1253	100	100	105	5
	4M	9	1255	100	100	112	12
4/5/78	4D	13	TOP 1307	TOP 1307	CLAY 9 F	CLAY SAND 01 DR	7

9  
0/67  
04  
at tunnel  
9 min  
Max Depth  
4 ft

REMARKS DITCH BETWEEN (3) & (4)

TYPE OF SOIL

TESTED BY R. HONGES

ALSO PRESENT: V. VINELLA  
O. KETTERMAN

LOT 2