

9/3/74 French
10/29/74

PERMIT

SEWAGE DISPOSAL SYSTEM

MARYLAND STATE DEPARTMENT OF HEALTH
HOWARD COUNTY

P 20291
A 08432

INDEXED

ELLCOTT CITY
DISTRICT 6th
DATE 7/5/74

By Garnet S. Bean

IS PERMITTED TO INSTALL ALTER

12655 Lime Kiln Road, Fulton, Md. ADDRESS PHONE 776-6816

A SEWAGE DISPOSAL SYSTEM LOCATED AT
(See City of Fulton)

SUBDIVISION ROAD Lime Kiln Road - see application for directions LOT

PROPERTY OWNER Garnet S. Bean

ADDRESS Lime Kiln Road, Fulton, Maryland

SPECIFICATIONS 3 bedrooms - 1000 gallon tank
4 bedrooms - 1250 gallon tank

DRAIN FIELD DEPTH FEET, BOTTOM AREA SQ. FT.

SEEPAGE PITS ABSORBENT SIDE-WALL AREA SQ. FT.

SEPTIC TANK CAPACITY GALLONS

FOR GARBAGE GRINDER, INCREASE DISPOSAL AREA 25% & TANK CAPACITY 50%.

OTHER TRENCH - 100 feet long, 9 feet deep, 5 foot gravel, trench starting 75 feet from right side and running toward left side and 130 feet from edge of road, trench to be inspected before gravel is installed.

NOTE: ALL PIPE FROM HOUSE TO DRY WELL MUST BE CAST IRON.
PERMIT VOID AFTER THREE YEARS.


NOTE: INSTALL STAND PIPE ON SEPTIC TANK AND DRY WELL.

PLANS APPROVED BY R. D. Fletcher & Fred Frommelt DATE 6/2/64

FILL SEPTIC TANK AND DISTRIBUTION BOX WITH WATER BEFORE CALLING FOR AN INSPECTION. COVER NO WORK UNTIL INSPECTED AND APPROVED.

NEITHER THE HOWARD COUNTY COMMISSIONERS NOR THE HEALTH DEPARTMENT IS RESPONSIBLE FOR THE SUCCESSFUL OPERATION OF ANY SYSTEM.

A 08432

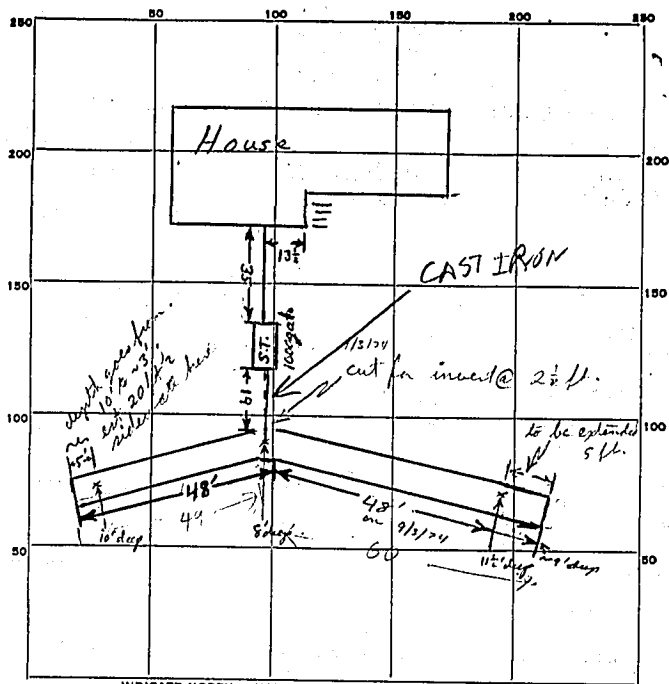

INDICATE NORTH. - NAME ADJOINING ROADWAY AS BASE LINE.

← Lime Kiln Rd. →

PERMIT CARD 20291

SEPTIC TANK, LEVEL

CLEANOUTS _____

DISTRIBUTION BOX, LEVEL _____

MANHOLE DEPTH _____ TRENCH WIDTH _____ FT.

GRAVEL DEPTH 7 ^{FT.} _{conical} TOTAL LENGTH _____ FT.

NUMBER OF TRENCHES 1 TOTAL ^{Sidewall} BOTTOM AREA _____

_____ TRENCH DEPTH BELOW GROUND _____ FT.

ABSORBENT AREA _____ SQ. FT.

REMARKS 9/13/74 ① Extend the 48' section of trench for 5 more feet ② pour in the gravel but leave the extended end open for inspection ③ install all piping downstream from the S.T. ④ install the S.T. cleanout ⑤ cover pipe from house to S.T. ⑥ call when ready R.M.

10/23 trench has been lengthened pipe is being laid R.M.

10/29/74 - System finished and cleanout on tank (Cleanout is set in next to tank NO FURTHER INSPECTION NEEDED)

DATE SYSTEM APPROVED 10/29/74 INSPECTOR Raymond Hooper

13
69

APPLICATION

SEWAGE DISPOSAL TESTING

Bees
A 08432
P _____

MARYLAND STATE DEPARTMENT OF HEALTH

HOWARD COUNTY

ELLICOTT CITY

DISTRICT 6

DATE 5/28/64

HOWARD COUNTY HEALTH DEPT. - SANITATION

Fill out in triplicate
Thank you for your cooperation!

Septic tank - 4000 gal. w/ 3 bedrooms
4350 gal. " 4 "

Drywell - 336 sq. ft. absorbent
sideyard area below inlet pipe for
3 bedrooms; 448 sq. ft. for 4 bedrooms

Locate drywell 66 ft. from right side
line and 290 ft. from back left line or lot
in sec. water flowing in from Taylor Knicker Rd.

TO: THE COUNTY HEALTH OFFICER
ELLICOTT CITY, MARYLAND
Trench, 100 ft. length 9 ft. deep, 5 ft. gravel, trench starting
75 ft. from it, and running toward left side of 190 ft. from edge
of road, trench to be covered with gravel installed 7 ft.

I, HEREBY, APPLY FOR THE NECESSARY TESTS IN ORDER TO CONSTRUCT (OR RECONSTRUCT) A SEWAGE DISPOSAL SYSTEM.

PROPERTY OWNER Joseph H. Thompson (Garrett Bees)

ADDRESS 3/4 Second St PHONE PA 5-2061

Laurel Maryland

PROPERTY LOCATION: _____

SUBDIVISION _____ LOT NO. _____

ROAD AND DESCRIPTION On right hand side of Selma Kilm road from
Brown Bridge road. Corner lot of Joseph H. Thompsons farm.

OCCUPANT _____ PHONE _____

PERSON TO CONSTRUCT SYSTEM _____

ADDRESS _____ PHONE _____

SIZE OF LOT 1.829 acres TYPE BLDG. none
NUMBER OF BEDROOMS _____

IF NOT SINGLE RESIDENCE DESCRIBE _____

SIGNATURE OF APPLICANT Joseph H. Thompson 6/2/64

APPROVED BY R. D. F. Clifton FOR Drywell DATE _____
(KIND OF SYSTEM)


REJECTED BY _____ FOR _____ DATE _____
(KIND OF SYSTEM)

HOLD PENDING FURTHER TESTS _____ DATE _____

REASONS FOR REJECTION OR HOLDING _____

THIS IS NOT A PERMIT

86
254

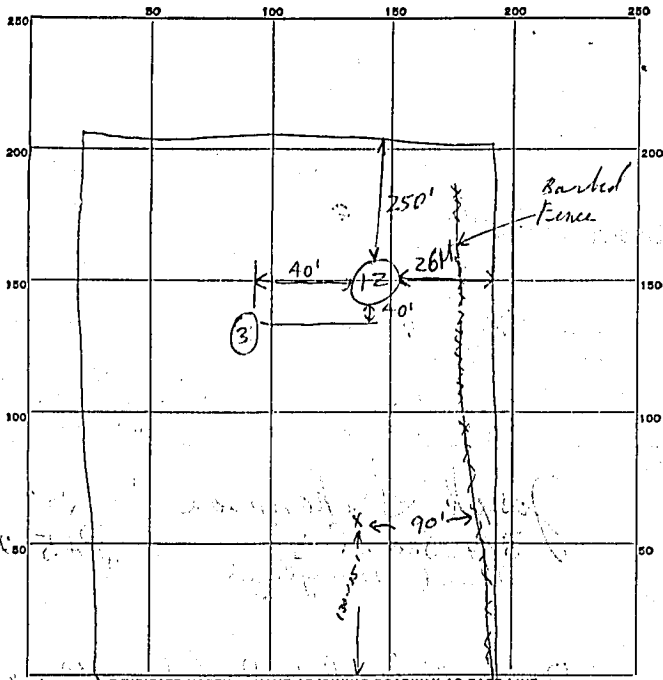

wood pile
trunk

DATE	TEST NO.	DEPTH	PRE-WET		TEST - 1" DROP		TIME
			START	STOP	START	STOP	
6/2/64	1	5 ft.	950	954	954	1000	6 min.
	2	9 ft.	950	954	954	1008	14 min.
	3	9 ft.	1007	1010	1010	1020	10 min.

SOIL AUGER FINDING _____

TESTED BY *RDF* 6/2/64 _____

REMARKS _____

ALSO PRESENT *South of Thorton* LOT NO. _____

C-1 9648

SEQUENCE NO. 4
IDWR USE ONLY

STATE OF MARYLAND
WATER RESOURCES ADMINISTRATION
TAWES STATE OFFICE BLDG., ANNAPOLIS, MD. 21401
WELL COMPLETION REPORT

THIS REPORT MUST BE SUBMITTED WITHIN 30 DAYS AFTER WELL COMPLETION

FILL IN THIS FORM COMPLETELY

COUNTY NUMBER **A 08432**

DATE RECEIVED (IDWR USE ONLY)

March 25 1974

DEPTH OF WELL

36

PERMIT NO. FROM "PERMIT TO DRILL WELL"

H10-73-0587
28 29 30 31 32 33 34 35 36 37

DATE WELL COMPLETED

22 (TO NEAREST FOOT) 26

DRILLERS IDENTIFICATION NO. 273

OWNER **Bean**

Garnet S.

STREET OR RFD **Little Kille Rd.**

FIRST NAME **Fulton, MD.**

LAST NAME

FIRST NAME

WELL LOG

WELL DESCRIPTION

STATE THE KIND OF FORMATIONS PENETRATED, THEIR COLOR, DEPTH, THICKNESS AND IF WATER BEARING

DESCRIPTION (USE ADDITIONAL SHEETS IF NECESSARY)	FEET		CHECK IF WATER BEARING
	FROM	TO	
Sand	0	20	
Flint Rock	20	36	

GROUTING RECORD

WELL HAS BEEN GROUTED (CIRCLE APPROPRIATE BOX) YES NO

TYPE OF GROUTING MATERIAL (CIRCLE BOX) 44 44

CEMENT BENTONITE CLAY

NO. OF BAGS **9** NO. OF POUNDS **816**

GALLONS OF WATER **54**

DEPTH OF GROUT SEAL (TO NEAREST FOOT)

FROM **0** FT. TO **20** FT.
(ENTER 0 IF FROM SURFACE)

CASING RECORD

INSERT APPROPRIATE CODE BELOW:

STEEL CONCRETE

PLASTIC OTHER

MAIN CASING TYPE NOMINAL DIAMETER TOP (MAIN) CASING (NEAREST INCH) **6.** TOTAL DEPTH OF MAIN CASING (NEAREST FOOT) **22**

OTHER CASING (IF USED)

DIAMETER (INCH) FROM TO

SCREEN RECORD

INSERT APPROPRIATE CODE BELOW:

STEEL BRASS OR BRONZE OPEN HOLE

PLASTIC OTHER

C 2

1 2 3 (SEQ. NO.) 6

DEPTH (NEAREST WHOLE FOOT)

8 9 11 13 17 36

23 24 26 30 32 36

38 39 41 45 47 51

SLOT SIZE 1. 2. 3.

DIAMETER OF SCREEN (NEAREST INCH)

FROM 36 TO 60

GRAVEL PACK

IF WELL DRILLED WAS A FLOWING WELL CIRCLE BOX

IDWR USE ONLY (NOT TO BE FILLED IN BY DRILLER)

TELESCOPE CASING LOG INDICATOR OTHER DATA AVAILABLE

C 3

1 2 3 (SEQ. NO.) 6

PUMPING TEST

HOURS PUMPED (TO NEAREST HOUR) **2**

PUMPING RATE GALLONS PER MINUTE TO NEAREST GALLON **10**

METHOD USED TO MEASURE PUMPING RATE **Bailer**

WATER LEVEL (DISTANCE FROM LAND SURFACE) BEFORE PUMPING **20** (NEAREST FOOT)

WHEN PUMPING **0** (NEAREST FOOT)

TYPE OF PUMPED USED (CIRCLE APPROPRIATE BOX) (FOR PUMPING TEST)

AIR PISTON TURBINE

CENTRIFUGAL ROTARY OTHER (CIRCLE BELOW)

JET SUBMERSIBLE

Bailer

PUMP INSTALLED

TYPE OF PUMP (WRITE APPROPRIATE LETTER IN BOX - SEE ABOVE: A, C, J, P, R, S, T, O)

DRILLER WILL INSTALL PUMP (CIRCLE APPROPRIATE BOX) YES NO

CAPACITY:

GALLONS PER MINUTE (TO NEAREST GALLON) 31 35

PUMP HORSE POWER 37 41

PUMP COLUMN LENGTH (NEAREST FOOT) 43 47

CASING HEIGHT (CIRCLE APPROPRIATE BOX AND ENTER CASING HEIGHT)

ABOVE LAND SURFACE BELOW (NEAREST FOOT) **2**

LOCATION OF WELL ON LOT

SHOW PERMANENT STRUCTURE SUCH AS BUILDINGS, SEPTIC TANKS, AND/OR OTHER LAND MARKS AND INDICATE NOT LESS THAN TWO DISTANCES (MEASUREMENTS TO WELL).

*grout 2 1/2 cases
20 pipes
well pumps 153pm
water level 18' from surface
7 bags cement
not complete - 2 days with
3-22-74 RPK*

CIRCLE APPROPRIATE BOXES

A WELL WAS ABANDONED AND SEALED WHEN THIS WELL WAS COMPLETED

ELECTRIC LOG OBTAINED

TEST WELL CONVERTED TO PRODUCTION WELL

I HEREBY CERTIFY THAT I HAVE COMPLIED WITH ALL CONDITIONS STATED ON THE ABOVE CAPTIONED "PERMIT TO DRILL WELL", AND THAT INFORMATION CONTAINED IN THIS REPORT IS TRUE, ACCURATE, AND COMPLETE TO THE BEST OF MY KNOWLEDGE, INFORMATION AND BELIEF.

DRILLERS NAME **RALPH DOWNEY**

SIGNATURE *Ralph Downey*

Back

1337

well