

APPLICATION

A 09959

P _____

SEWAGE DISPOSAL TESTING

MARYLAND STATE DEPARTMENT OF HEALTH

HOWARD COUNTY

ELLICOTT CITY

DISTRICT 5DATE 4/2/65

*Dry well 12 ft. in dia. by 12 ft.
deep below the inlet located 12 ft.
off the front property line and 12 ft
off the right side property line
has determined when facing the lot
from Vista Rd.*

TO: THE COUNTY HEALTH OFFICER
ELLICOTT CITY, MARYLAND*1000 gal septic tank.*

I, HEREBY, APPLY FOR THE NECESSARY TESTS IN ORDER TO CONSTRUCT (OR RECONSTRUCT) A SEWAGE DISPOSAL SYSTEM.

PROPERTY OWNER Frank W. RobbinsADDRESS 112 Hunting Lane, Simpsonville, Md. PHONE AT 6-2534

PROPERTY LOCATION:

SUBDIVISION Holiday Hills LOT NO. 79, Sec. 6ROAD AND DESCRIPTION Vista Rd.

OCCUPANT _____ PHONE _____

PERSON TO CONSTRUCT SYSTEM _____

ADDRESS _____ PHONE _____

SIZE OF LOT 1 acre TYPE BLDG. 4

NUMBER OF BEDROOMS

IF NOT SINGLE RESIDENCE DESCRIBE _____

SIGNATURE OF APPLICANT Frank W. RobbinsAPPROVED BY J. Henniger FOR Dry Well DATE 4-20-65


(KIND OF SYSTEM)

REJECTED BY _____ FOR _____ DATE _____

(KIND OF SYSTEM)

HOLD PENDING FURTHER TESTS 4-9-65 DATE _____REASONS FOR REJECTION OR HOLDING 4-9-65 Possibly may get lot to go in front fordrain field, not suitable for other systems.

THIS IS NOT A PERMIT

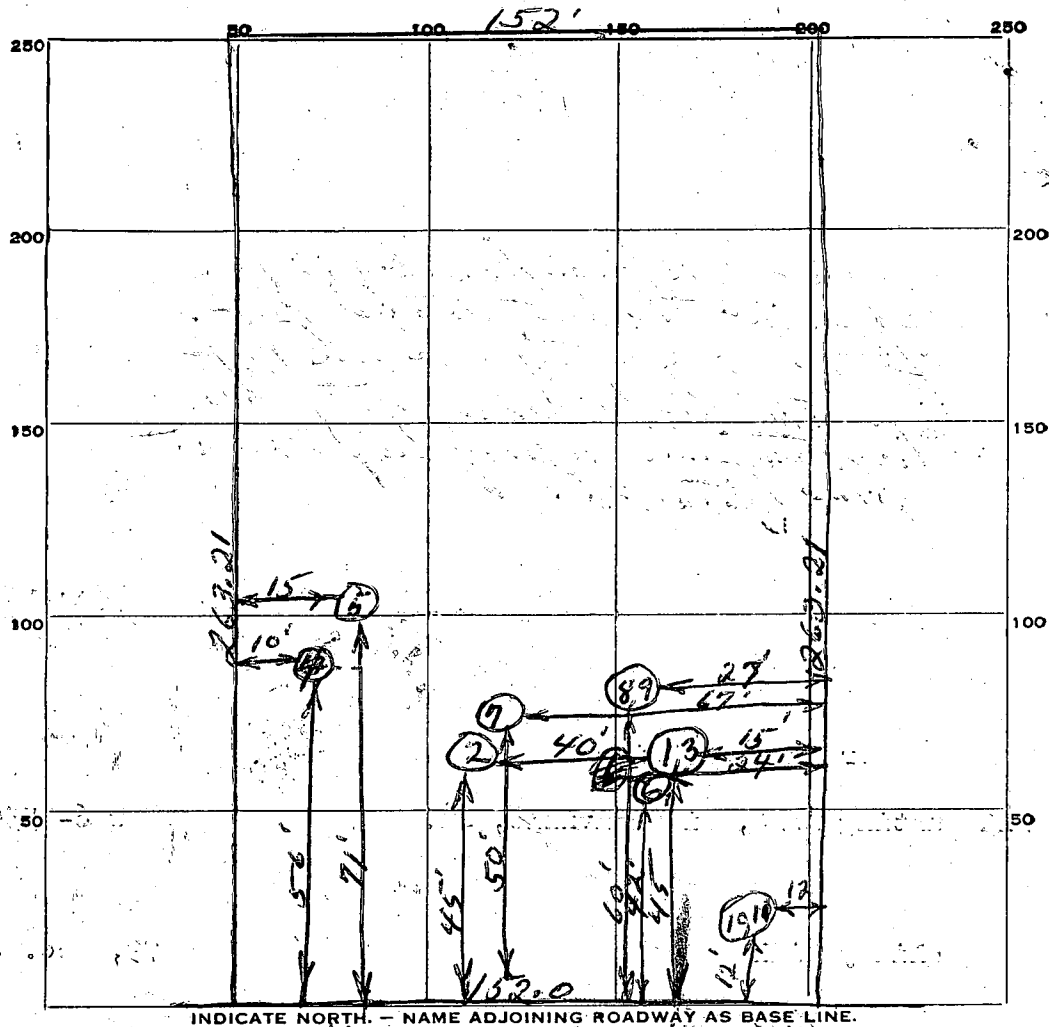

INDICATE NORTH. - NAME ADJOINING ROADWAY AS BASE LINE

Vista Road

DATE	TEST NO.	DEPTH	PRE-WET		TEST - 1" DROP		TIME
			START	STOP	START	STOP	
4-9-65	1	7'	9:58	10:08	10:08	10:22	14 min
	2	7'	Rock at 7 FT. couldn't break through - clay to 5' FT.				
	3 Same pit as #1	11 $\frac{3}{4}$	11:44	overtime - tight rotten rock starts about 10' ft down.			
	4	7	soil tight rotten rock at 7 FT. 15T 3' ft. fill clayish				
	5	6	soil tight - rotten rock at 6 FT. 15T 3 FT. fill				
4-20-65	6	3	10:28	11:18	50 min		
	7	3 $\frac{1}{2}$	10:36	11:20	7 $\frac{1}{8}$ "		
	8 Same	11	11:58	12:08	12:08	12:30	17 min
	9 Pit	5 $\frac{1}{2}$	12:00	12:01	12:01	12:04	3 min
	10 Same pit	3 $\frac{1}{2}$	12:11	12:16	12:16	12:29	13 min
	11	10 $\frac{1}{2}$	12:08	12:10	12:10	12:16	6 min

SOIL AUGER FINDING

TESTED BY

REMARKS

ALSO PRESENT

-LOT NO