

5/2/84  
9:30 A.M.

# PERMIT

P 33839  
A Repair

SEWAGE DISPOSAL SYSTEM

MARYLAND STATE DEPARTMENT OF HEALTH\*

HOWARD COUNTY  
BUREAU OF ENVIRONMENTAL HEALTH  
992-2330

05-363799  
INDEX

ELLICOTT CITY  
DISTRICT 5th  
DATE 4/30/84

Jenkins Brothers IS PERMITTED TO INSTALL \_\_\_\_\_ ALTER X

ADDRESS Frederick Road (Route 144), Ellicott City, Md. 21043 PHONE 465-6646

SUBDIVISION Holiday Hills ROAD 10825 Vista Road LOT 79, Sec. 6

PROPERTY OWNER R. R. Luman

ADDRESS 10825 Vista Road, Columbia, Maryland 21044 Phone: 531-2408

IF GARBAGE GRINDER IS USED INCREASE SEPTIC TANK CAPACITY BY 50% AND ABSORPTION AREA BY 22%.

GARBAGE GRINDER? YES \_\_\_\_\_ NO X

SEPTIC TANK CAPACITY \_\_\_\_\_ GALLONS NUMBER OF BEDROOMS 4

REPAIR - Call for an appointment when ground is opened up and Sanitarian will recommend the repair system. 5/2/84 ROCK 1

LEACHING BED 400 SQ FT BOTTOM AREA  
4 FT TO 6 FT DEEP FILLED WITH 1 FT TO 3 FT  
STONE PUT BED OFF OLD TANK AND KEEP AT  
LEAST 75 FT FROM WATER WELL

BLDG. PERMIT SIGNED  
AND RETURNED 4/24/84  
Serial # 71304 deck  
DATE 4/30/84

PLANS APPROVED BY Frank A. Skinner

COVER NO WORK UNTIL INSPECTED AND APPROVED.

NEITHER THE HOWARD COUNTY COUNCIL NOR THE HEALTH DEPARTMENT IS RESPONSIBLE FOR THE SUCCESSFUL OPERATION OF ANY SYSTEM.

NOTE: IF TRENCH IS USED CALL FOR INSPECTION BEFORE AND AFTER PLACING GRAVEL IN TRENCH.

NOTE: NO DRY WELL SHALL EXCEED 15 FOOT IN DIAMETER. NO ABSORPTION TRENCH TO EXCEED 100 FEET IN LENGTH.

NOTE: ALL PIPE FROM HOUSE TO SEPTIC TANK MUST BE CAST IRON OR SCHEDULE 40 PVC OR ABS.

PERMIT VOID AFTER THREE YEARS.

NOTE: INSTALL STAND PIPE ON SEPTIC TANK AND DRY WELL. STAND PIPES MUST BE 6 INCHES IN DIAMETER. CAST IRON, CONCRETE OR TERRA COTTA, OR PVC OR ABS ACCEPTED. IF TOP OF SEPTIC TANK IS DEEPER THAN 3 FEET MANHOLE TO GRADE REQUIRED.


**\*INSTALLER IS RESPONSIBLE FOR OBTAINING FINAL APROVAL ON THIS PERMIT**

\*CALL 992-2330 FOR INSPECTION OF SEPTIC SYSTEMS.

EH - 2-1082

33839

- ①  
RED BROWN CLAY  
3  
SAND  
6  
ROCK
- ②  
SAND  
4  
ROCK
- ③  
SANDY  
2 1/2  
ROCK

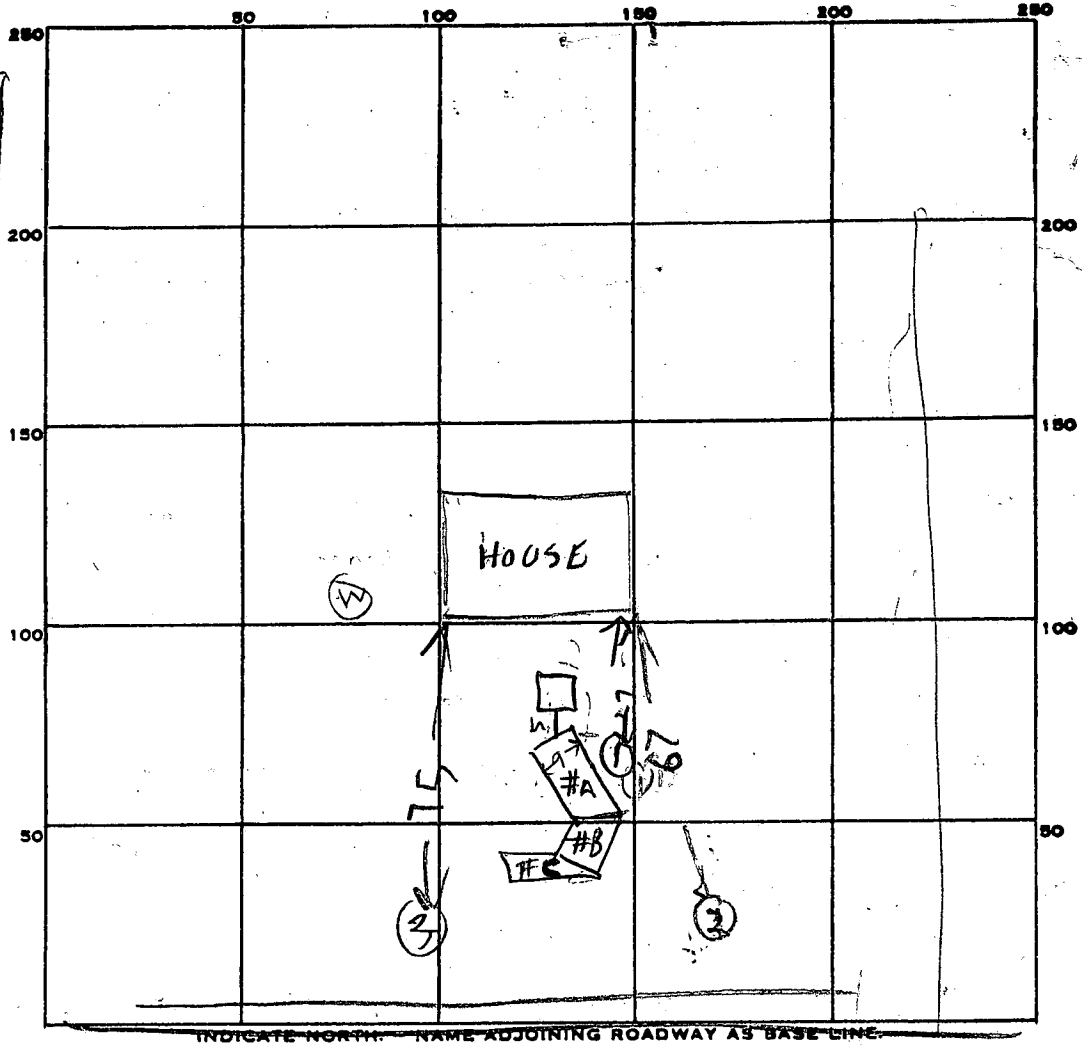

70  
-6-400  
30 15  
9 5  
2 7  
26  
7

INDICATE NORTH - NAME ADJOINING ROADWAY AS BASE LINE

PERMIT CARD \_\_\_\_\_

SEPTIC TANK, LEVEL \_\_\_\_\_ CLEANOUTS \_\_\_\_\_

DISTRIBUTION BOX, LEVEL \_\_\_\_\_

BED \_\_\_\_\_

TILE FIELD, DEPTH 6-8 FT. TRENCH WIDTH 5-9 FT.

GRAVEL DEPTH 3-5 FT. IN. TOTAL LENGTH 71 FT.

NUMBER OF TRENCHES 1 BED TOTAL BOTTOM AREA 527

SEEPAGE PITS, INSIDE DIAMETER \_\_\_\_\_ FT. DEPTH BELOW INLET \_\_\_\_\_ FT.

ABSORBENT AREA \_\_\_\_\_ SQ. FT.

270  
175  
182  

---

527  
30  
18  
26  
71

REMARKS 5/2/84 POOR GROUND DECIDED ON LEACHING  
BED. PART OF BED NEAR TANK IS 6 FT DEEP  
FINISH BED LEAVE FAR END OPEN FOR DEPTH MEASUREMENT  
ADD STONE 5/2/84 ODD SHAPED BED DUG & ABLE  
TO DIG 8 FT IN ONE AREA. #A = 30x9 = 270 SQ FT  
#B = 5x15 = 75 SQ FT, #C = 26x7 = 182 SQ FT

DATE SYSTEM APPROVED 5/2/84 INSPECTOR Raymond Hodge