


Scale
1" = 40'

PUBLIC DRAINAGE
UTILITY EASEMENT


Surveyed by
permit # 822062143
1115 Wilson Green Way.
Washington, D.C. 21004
607-967-0080

10.6' DRIVEWAY
ENCROACHMENT

LOT 18
43547 SQ. FT.
4' water
between
houses
14' 2" 14'
*Alphabet
Revised with
8" concrete
to match w/ 2nd floor

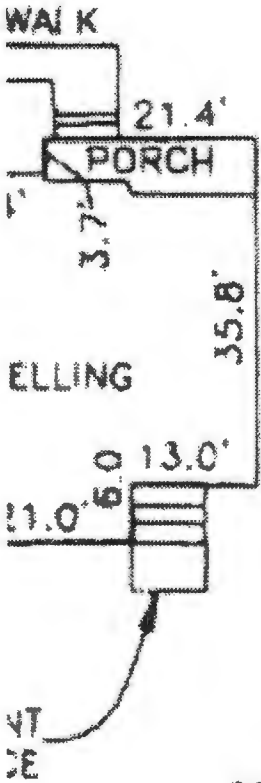

20' PRIVATE
SEPTIC ACCESS

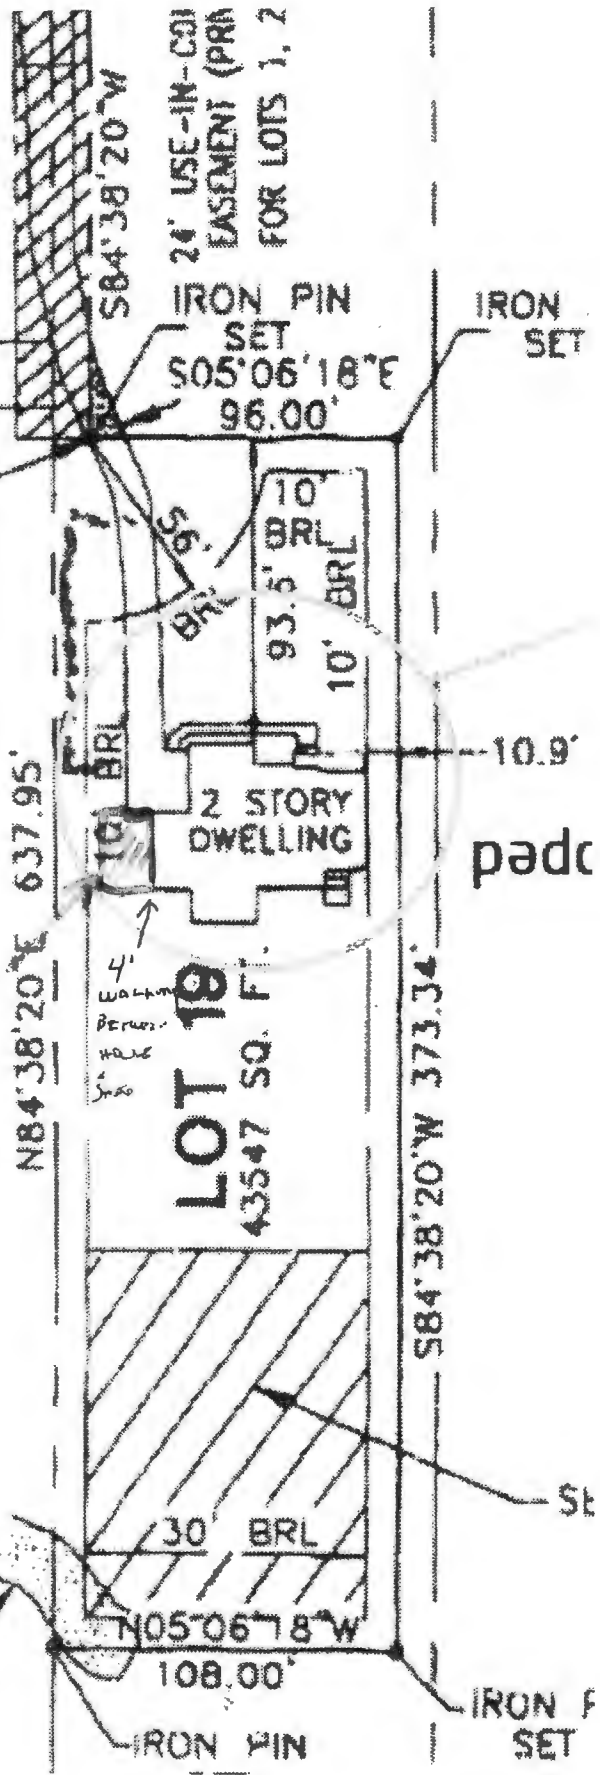

B22002143

1115 Willow Green
Way