

APPLICATION

4

Preel

SEWAGE DISPOSAL TESTING

STATE OF MARYLAND - DEPARTMENT OF HEALTH AND MENTAL HYGIENE

A 29476
P _____

HOWARD COUNTY HEALTH DEPARTMENT
ENVIRONMENTAL HEALTH SERVICES
P.O. BOX 476 ELLICOTT MARYLAND 21043
TELEPHONE: 992-2330

DISTRICT 4th

DATE 2/1/79

*10' x 3'
Max 4'*

TO: THE COUNTY HEALTH OFFICER
ELLICOTT CITY, MARYLAND

I, HEREBY, APPLY FOR THE NECESSARY TEST IN ORDER TO CONSTRUCT (OR RECONSTRUCT) A SEWAGE DISPOSAL SYSTEM.

PROPERTY OWNER Georgia Comm property, c/o E. Brooke Lee Hoke Rosensteel

ADDRESS 10000 Sweepstakes Road, Damascus, Md. 20750 PHONE Boender - 465-7777

PROPERTY LOCATION:

SUBDIVISION _____ LOT NO. Area 4 (10 7)

ROAD AND DESCRIPTION 914 Watersville Road

SIZE OF LOT 10 1/2 acres m/1 TYPE BLDG. 3 or 4 bedrooms

THE SYSTEM INSTALLED UNDER THIS APPLICATION IS ACCEPTABLE ONLY UNTIL PUBLIC FACILITIES BECOME AVAILABLE.

I FULLY UNDERSTAND THE FEE CONNECTED WITH THE FILING OF THIS PERC TEST APPLICATION IS NON-REFUNDABLE UNDER ANY CIRCUMSTANCES.

SIGNATURE OF APPLICANT /s/ Jack Boender for E. Brooke Lee

APPROVED BY _____ FOR Drainfields DATE _____

REJECTED BY _____ FOR _____ DATE _____

HOLD PENDING FURTHER TESTS Stephen Reel DATE 10-2-80

REASONS FOR REJECTION OR HOLDING Not sufficient AREA due to soil conditions +

Topography, 10-2-80 SKL 10-25-80 Perc OK Hold for

Certified holes, house + well site SK+FF

BLDG. PERMIT SIGNED
AND RETURNED 6-9-80


BP 18910 SKL

THIS IS NOT A PERMIT

10-22-80



93	3'	1:41	1:46	2:00	15 min
94	8'	1:49		1:51	* 2 min
100	8'	2:02	2:04	2:07	3 min
105	3'	2:06	2:10	2:17 2:27	10 min

(9)

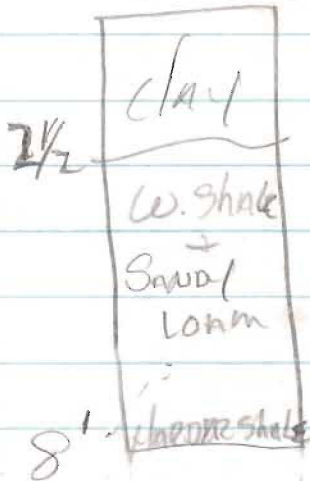

* 2 min 2 in

(10)

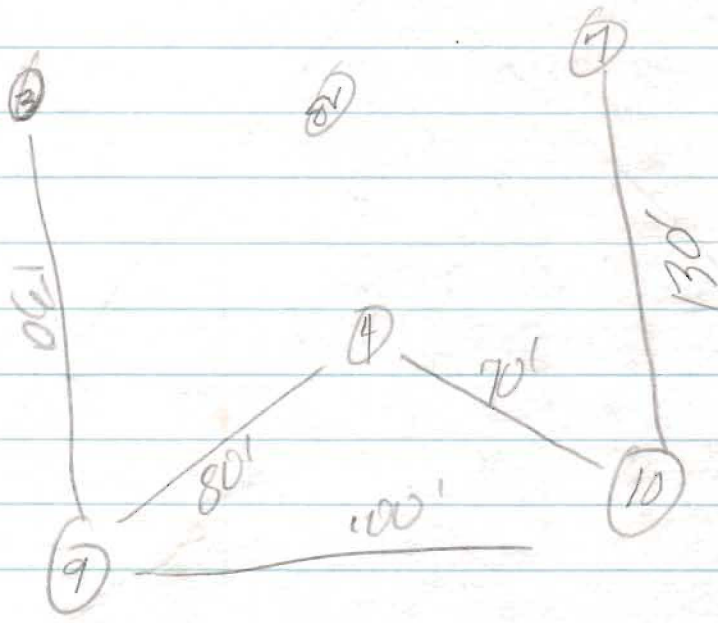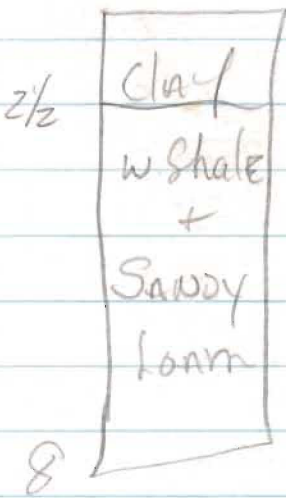

GEORGIA CONNING PROP

WATERSVILLE RD


Lot 7

H₀

see Plat

5/2/79	IV	6	TOP 2 FT CLAY MID 4 FT SHALE ROCK BOTTOM
--------	----	---	---

SEE PLAT

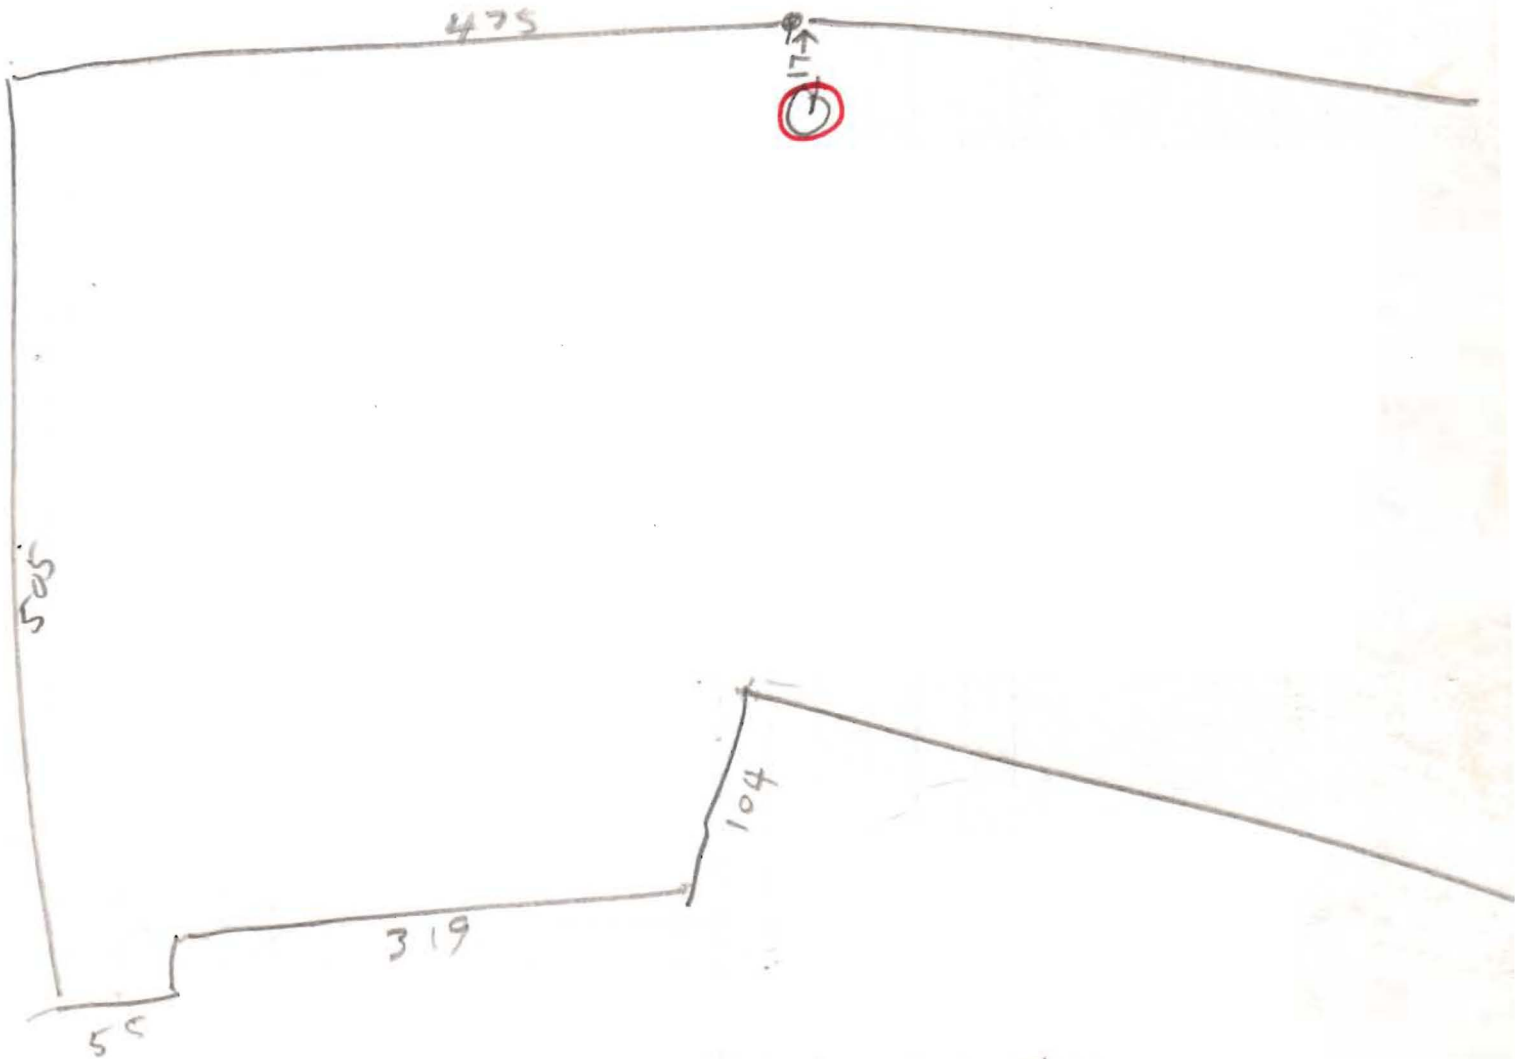

NOTE: NO FEE FOR LOT #7
HOWEVER LOT 4 & LOT 5 NOT
YET TESTED 5/2/79 RH