

04-341791

3/23/89 AM
6/28/90 2PM

Needs House connection

3/23/89 P.C.O. C.B.D.

P 33405

A 29476

PERMIT

SEWAGE DISPOSAL SYSTEM

MARYLAND STATE DEPARTMENT OF HEALTH

DISTRICT 4th

HOWARD COUNTY

BUREAU OF ENVIRONMENTAL HEALTH

461-9933

DATE 12/19/83

DATE SYSTEM APPROVED 6/28/90

INSPECTOR RH

Repair Permit P33405
Paid For But Never Issued

INDEXED

Arnold Septic Service, Inc.

IS PERMITTED TO INSTALL X ALTER

ADDRESS P. O. Box 15, Woodbine, Maryland 21797

PHONE 795-7873

SUBDIVISION Poplar Springs

ROAD 914 Watersville Road

LOT 4

PROPERTY OWNER Hoke Rosensteel

ADDRESS 404 N. Main St. Mt. Airy Md. 21771

IF GARBAGE GRINDER IS USED INCREASE SEPTIC TANK CAPACITY BY 50% AND ABSORPTION AREA BY 22%.

GARBAGE GRINDER? YES NO X

SEPTIC TANK CAPACITY 1000 GALLONS

NUMBER OF BEDROOMS 3

TRENCHES - 200 sq. ft. per bedroom. Trench to be 3 feet wide. Inlet 3 feet below original grade. Bottom maximum depth 5 feet below original grade. Effective area begins at 3 feet below original grade. 2 feet of stone below distribution pipe.

LOCATION - Beginning from the rear left corner (Intersect of the left 334.35' and rear 580') place the first trench 180 feet across the rear lot line and 135 feet off the same lot line. Run trench on contour toward the rear of lot.

NOTE - No trench to exceed 100 feet in length. Provide 6" - 8" diameter cleanout and cap to grade or above on septic tank. OK/CW

PLANS APPROVED BY Sid Abel

DATE 6/01/88

COVER NO WORK UNTIL INSPECTED AND APPROVED

NEITHER THE HOWARD COUNTY COUNCIL NOR THE HEALTH DEPARTMENT IS RESPONSIBLE FOR THE SUCCESSFUL OPERATION OF ANY SYSTEM

NOTE CLEANOUT REQUIRED EVERY 70 FEET OF SEWER LINE AND/OR AT 90° SWEEPS IN LINES FROM HOUSE TO DRAIN FIELDS

NOTE ALL PARTS OF SEPTIC SYSTEMS (I.E. TANK, DISTRIBUTION BOX, TRENCHES) TO BE 100 FEET FROM WELL (UNLESS OTHERWISE SPECIFICALLY AUTHORIZED)

NOTE IF DEEP TRENCHES ARE USED CALL FOR INSPECTION BEFORE AND AFTER PLACING GRAVEL IN TRENCHES

NOTE NO DRY WELL SHALL EXCEED 15 FOOT IN DIAMETER NO ABSORPTION TRENCH TO EXCEED 100 FEET IN LENGTH

NOTE: ALL PIPE FROM HOUSE TO SEPTIC TANK MUST BE CAST IRON OR SCHEDULE 40 PVC OR ABS

PERMIT VOID AFTER TWO YEARS

NOTE: INSTALL STAND PIPE ON SEPTIC TANK AND DRY WELL. STAND PIPES MUST BE 6 INCHES IN DIAMETER. CAST IRON, CONCRETE OR TERRA COTTA OR PVC OR ABS ACCEPTED. IF TOP OF SEPTIC TANK IS DEEPER THAN 3 FEET, MANHOLE TO GRADE REQUIRED

NOTE DISTRIBUTION BOXES MUST HAVE BAFFLES


*INSTALLER IS RESPONSIBLE FOR OBTAINING FINAL APPROVAL ON THIS PERMIT

*CALL 461-9933 FOR INSPECTION OF SEPTIC SYSTEMS.

676.6
675.6
1.0

11/29/83
Jr. Spitzer
Or. F.S.

House + Drain Line Elevations
House elev. Floor 689.6
House " basement 680.6
Invert elev. (out of house) 679.0
" " (into tank) 676.0
" " (out of ") 676.0
" " (into box) 675.6

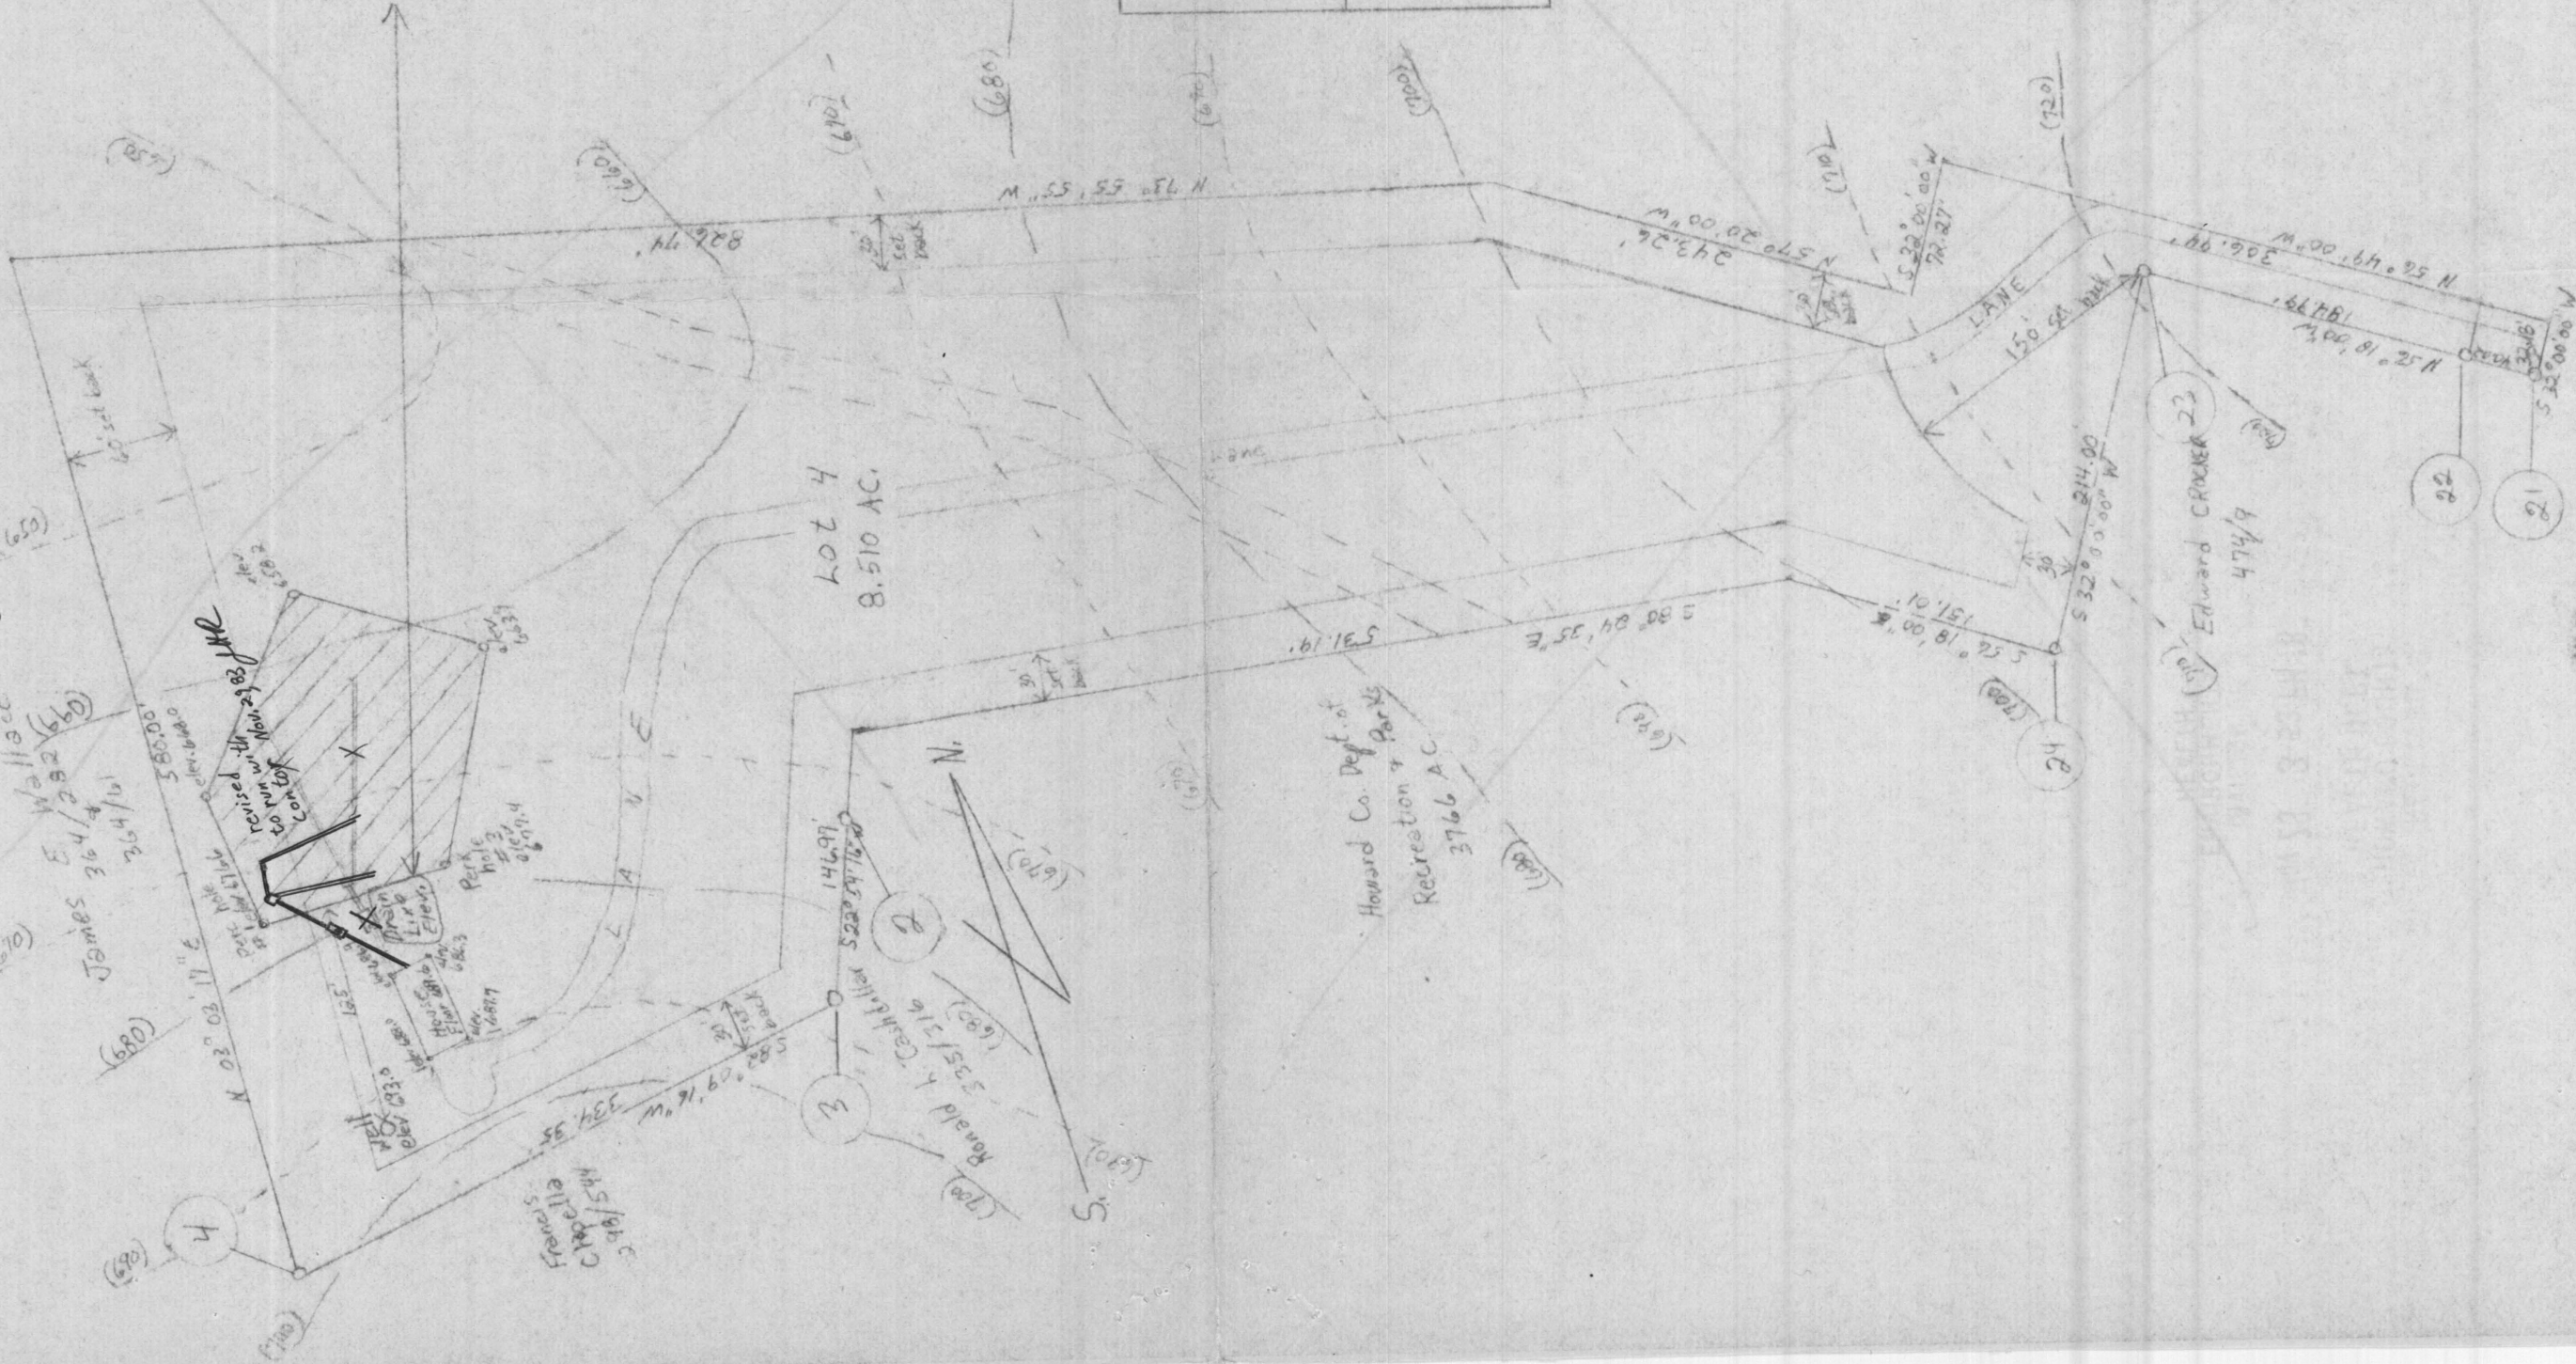

Nov 4, 1983

Foremost Industries, Inc.

9395 Buchanan Trail, West

Greencastle, PA 17225

Phone (717) 597-7166

Md. Sales Mgr. & Balto.-Wash. Co. Ord.

J. Hoke Rosensteel

404 N. Main St., Mt. Airy, Md.

21771 Phone (301) 829-0886

Poplar Springs Lot #4

Plate #4849 Parcel A

Tax Map 7 4th Elect. Dist.

From Survey by Boender Assoc.

J.H.R. For Foremost Industries

Scale: 1" = 100'