

05-392209 2 JUNE 87 1100 AM

PERMIT

P 39317

A 31352

SEWAGE DISPOSAL SYSTEM

MARYLAND STATE DEPARTMENT OF HEALTH DISTRICT 5th

HOWARD COUNTY

BUREAU OF ENVIRONMENTAL HEALTH

461-9933

INDEXED

DATE 5/12, 1987

DATE SYSTEM APPROVED 6/2/87

INSPECTOR RH

Donald Parlette IS PERMITTED TO INSTALL X ALTER

ADDRESS 6575 Route 32, Clarksville, MD 21029 PHONE 531-2140

SUBDIVISION Jocelyn Acres ROAD 6542 Mink Hollow Rd LOT 4

PROPERTY OWNER James Potts

ADDRESS _____

IF GARBAGE GRINDER IS USED INCREASE SEPTIC TANK CAPACITY BY 50% AND ABSORPTION AREA BY 22%.

GARBAGE GRINDER? YES _____ NO X

SEPTIC TANK CAPACITY 1000 GALLONS NUMBER OF BEDROOMS 3

TRENCHES - 200 sq. ft. per bedroom. Trench to be 2 feet wide. Inlet 4 feet below original grade. Bottom maximum depth 8 feet below original grade. Effective area begins at 4 feet below original grade. 4 feet of stone below distribution pipe.

LOCATION - Place the distribution box 100 feet from the front (375') lot line and 200 feet from the left (327') lot line as seen when facing the lot from Mink Hollow Road. Run trenches on contour toward front lot line.

NOTE - No trench to exceed 100 feet in length. Provide 6" - 8" diameter cleanout and cap to grade or above on septic tank. OK

PLANS APPROVED BY S. Abel DATE 12/02/86

COVER NO WORK UNTIL INSPECTED AND APPROVED.

NEITHER THE HOWARD COUNTY COUNCIL NOR THE HEALTH DEPARTMENT IS RESPONSIBLE FOR THE SUCCESSFUL OPERATION OF ANY SYSTEM.

NOTE: CLEANOUT REQUIRED EVERY 70 FEET OF SEWER LINE AND/OR AT 90° SWEEPS IN LINES FROM HOUSE TO DRAIN FIELDS.

NOTE: ALL PARTS OF SEPTIC SYSTEMS (I.E., TANK, DISTRIBUTION BOX, TRENCHES) TO BE 100 FEET FROM WELL (UNLESS OTHERWISE SPECIFICALLY AUTHORIZED)

NOTE: IF DEEP TRENCH(ES) ARE USED CALL FOR INSPECTION BEFORE AND AFTER PLACING GRAVEL IN TRENCH(ES).

NOTE: NO DRY WELL SHALL EXCEED 15 FOOT IN DIAMETER. NO ABSORPTION TRENCH TO EXCEED 100 FEET IN LENGTH.

NOTE: ALL PIPE FROM HOUSE TO SEPTIC TANK MUST BE CAST IRON OR SCHEDULE 40 PVC OR ABS.

PERMIT VOID AFTER TWO YEARS.

NOTE: INSTALL STAND PIPE ON SEPTIC TANK AND DRY WELL. STAND PIPES MUST BE 6 INCHES IN DIAMETER. CAST IRON, CONCRETE OR TERRA COTTA OR PVC OR ABS ACCEPTED. IF TOP OF SEPTIC TANK IS DEEPER THAN 3 FEET, MANHOLE TO GRADE REQUIRED.


NOTE: DISTRIBUTION BOXES MUST HAVE BAFFLES.

***INSTALLER IS RESPONSIBLE FOR OBTAINING FINAL APROVAL ON THIS PERMIT**

*CALL 461-9933 FOR INSPECTION OF SEPTIC SYSTEMS.

EH - 2-1186

A 31352

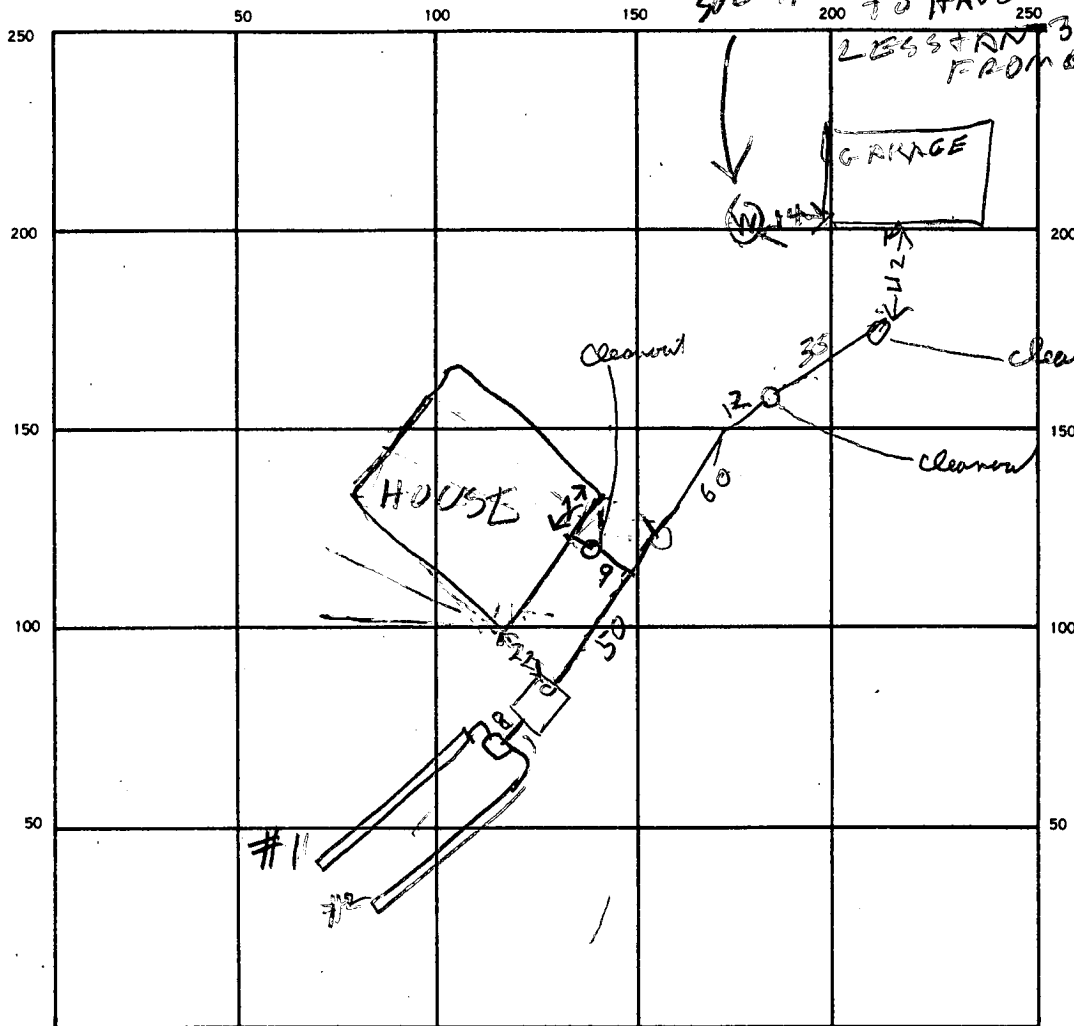

INDICATE NORTH. — NAME ADJOINING ROADWAY AS BASE LINE.

ST	HOUSE SEWER	HOUSE SEWER	HOUSE SEWER
OK	OK	OK	OK

SEPTIC TANK, LEVEL OK 1500

CLEANOUTS

DISTRIBUTION BOX, LEVEL _____

DRAIN FIELD/TILE FIELD, DEPTH #1 9 1/2 FT. TRENCH WIDTH #1 2 1/2 FT. INLET DEPTH _____ FT.

EFFECTIVE GRAVEL DEPTH 5.5 FT. TOTAL LENGTH 88 FT.

NUMBER OF TRENCHES 2 ONE SIDEWALL/BOTTOM AREA 164 SQ. FT.

DRYWELL INSIDE DIAMETER _____ FT. EFFECTIVE DEPTH BELOW INLET _____ FT.

ABSORBENT AREA _____ SQ. FT.

REMARKS 6/1/87 - TRENCHES DUG & SOME PIPE CONNECTED R/H
6/1/87 - TRENCH #2 FINISHED COMPLETELY, FIRST 60 FT OF
TRENCH #1 FINISHED. FINISH ADDING STONE & COVER
ALL WORK

DATE SYSTEM APPROVED

5/2/87

INSPECTOR

Raymond Hodges

APPLICATION

SEWAGE DISPOSAL TESTING

STATE OF MARYLAND - DEPARTMENT OF HEALTH AND MENTAL HYGIENE

HOWARD COUNTY HEALTH DEPARTMENT
ENVIRONMENTAL HEALTH SERVICES

P. O. BOX 473 ELLICOTT CITY, MARYLAND 21043
TELEPHONE: 992-2330

A 31352

P _____

DISTRICT 5th

DATE APRIL 29, 1981

TO: THE COUNTY HEALTH OFFICER
ELLICOTT CITY, MARYLAND

I, HEREBY, APPLY FOR THE NECESSARY TEST IN ORDER TO CONSTRUCT (OR RECONSTRUCT) A SEWAGE DISPOSAL SYSTEM.

PROPERTY OWNER MANGLITZ AND ASSOCIATES JAMES POTTS

ADDRESS P.O. BOX 701 ADELPHI, MARYLAND 20783 PHONE 653-0804

PROPERTY LOCATION:

SUBDIVISION JOCELYN ACRES LOT NO. 4 near 4 sect I

ROAD AND DESCRIPTION NORTHWEST CORNER OF HIGHLAND ROAD AND MINK HOLLOW ROAD
6542 Mink Hollow Rd.

SIZE OF LOT 3.2 AC.± TYPE BLDG. SINGLE FAMILY
(NUMBER OF BEDROOMS)

THE SYSTEM INSTALLED UNDER THIS APPLICATION IS ACCEPTABLE ONLY UNTIL PUBLIC FACILITIES BECOME AVAILABLE. I FULLY UNDERSTAND THE

FEE CONNECTED WITH THE FILING OF THIS PERC TEST APPLICATION IS NON-REFUNDABLE UNDER ANY CIRCUMSTANCES. I ALSO AGREE TO COMPLY

WITH ALL M.O.S.H.A. REQUIREMENTS IN TESTING THIS LOT. Charles J. Conrad Jr.
(SIGNATURE OF APPLICANT)

APPROVED BY Stephen Kriel FOR Day Well & Trench DATE 1-26-82

REJECTED BY _____ FOR _____ DATE _____

HOLD PENDING FURTHER TESTS Stephen Kriel DATE 5/6/81

REASONS FOR REJECTION OR HOLDING held for certified holes under house
note - SK-1

BLDG. PERMIT SIGNED




BLDG. PERMIT SIGNED AND RETURNED 5/3/81
AND RETURNED 12/2/81 Permit # 70114

S. Phil
BP # 9202 2 car garage


THIS IS NOT A PERMIT

#4

① + 2
SOIL PROFILE

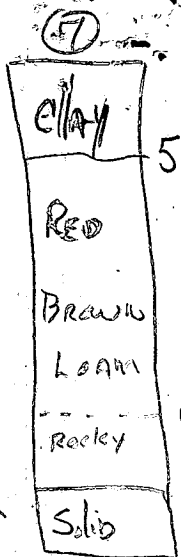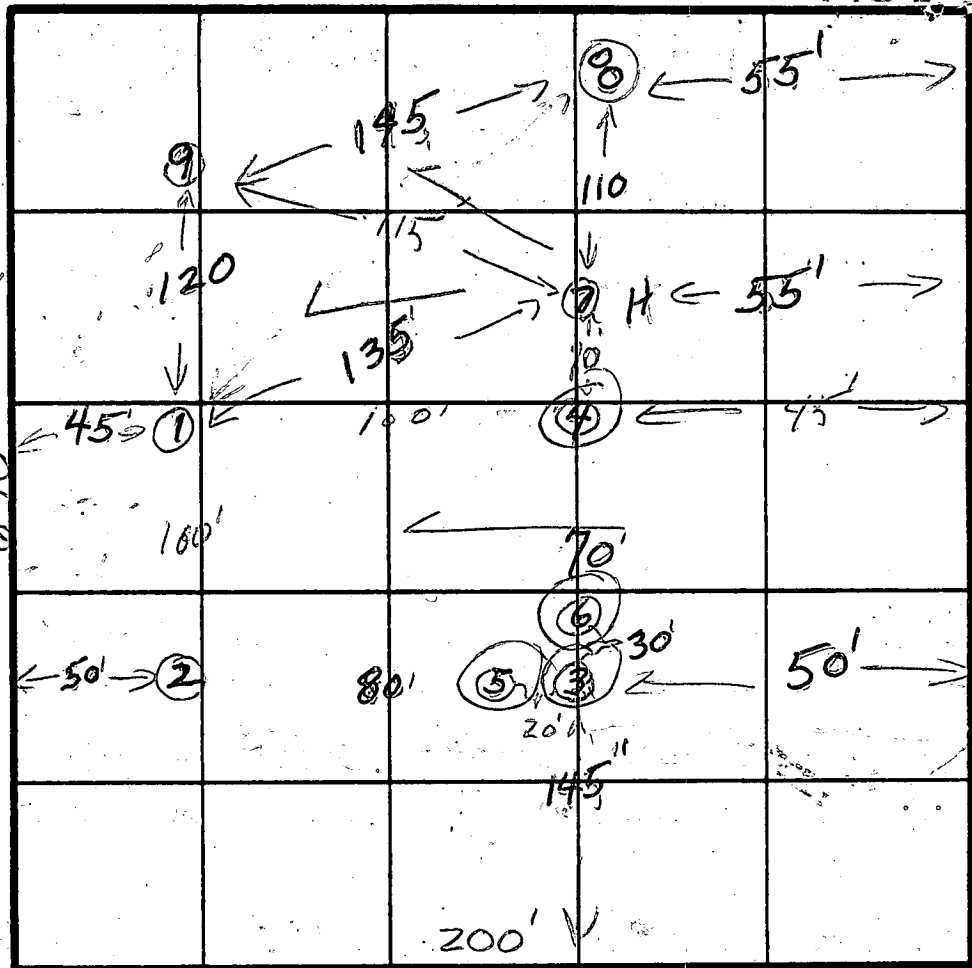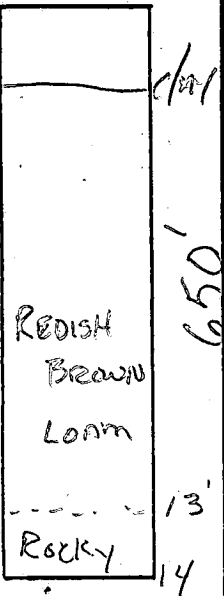

T = 12
inlet 1/2

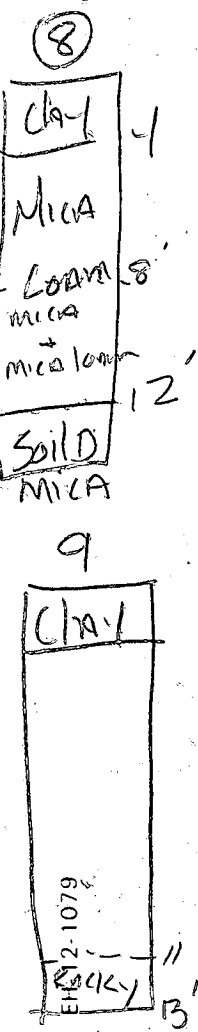

INDICATE NORTH, NAME ADJOINING ROADWAY AS BASE LINE.
Mink Hollow Rd

DATE	TEST NO.	DEPTH	PRE-WET		TEST - 1" DROP		TIME
			START	STOP	START	STOP	
5/6/8	1 S	3 1/2'	1:13	1:37	1:37	1:57	1:57
	1 M	8 1/2'	1:12	1:18	1:18	1:32	12
	1 D	14'					
	2 S	4'	1:33	X XV	X XV	X XV	1/2
	2 M	8'	1:31	1:34	1:34	1:40	6
	2 D						
	③ S	Solid Rock at 8'					
	③ M						
	③ D						
	④ S	Solid Rock at 8'					
	④ M						
	④ D						
	⑤	Solid Rock at 8'					
	⑥	Clay at 6' Solid Rock at 12'					
	1 SA	4 1/2'	1:59	2:12	2:12	2:42	30
	7 S	5'	2:27	2:34	2:34	2:45	11
	7 M	9'	2:53	2:58	2:58	3:05	7

Little Rock 7/4

Fail

REMARKS: WOOD LOT ALL LINES STAKED

TYPE OF SOIL

TESTED BY: SK 5/6/8

ALSO PRESENT: JOE MOREAU F.C.C.
Skip & Bob on Rocks


8 S	4	3:06	3:09	3:15	6 min
8 M	9	3:06	3:09	3:17	8'
8 D	12'				
9 S	5	3:32	3:38	3:50	12
9 M	9				
9 D	13	3:50	3:52	3:56	4

Joseph A...

STAKE
1044
8/29/5

Hole ① & ②
are about
same elev
& lower than
(PT) old track

STAKE
8/29/5

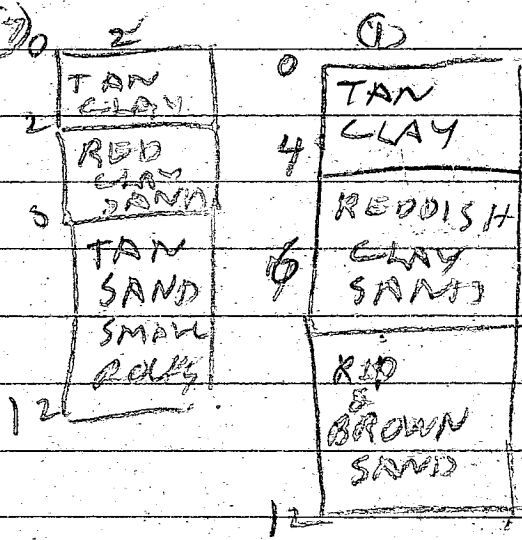

11	15	10	7 1/2	1042	1043	1043	1044	1
		15	5	1145	1149	1149	1156	7
		IV	12	LOOKS	OK	SEE SOIL PROFILE		
		20	8	1217	1218	1218	1225	2
		25	4	1217	1225	1225	1237	12
		2V	12	SEE SOIL PROFILE			LOOKS OK	

Retest

APPLICATION

re test

SEWAGE DISPOSAL TESTING

STATE OF MARYLAND - DEPARTMENT OF HEALTH AND MENTAL HYGIENE

HOWARD COUNTY HEALTH DEPARTMENT
ENVIRONMENTAL HEALTH SERVICES
P. O. BOX 476 ELLICOTT CITY, MARYLAND 21043
TELEPHONE: 992-2330

A 22210

P _____

DISTRICT 5th

DATE 9/29/82

TO: THE COUNTY HEALTH OFFICER
ELLICOTT CITY, MARYLAND

I, HEREBY, APPLY FOR THE NECESSARY TEST IN ORDER TO CONSTRUCT (OR RECONSTRUCT) A SEWAGE DISPOSAL SYSTEM.

PROPERTY OWNER James Potts
ADDRESS 1209 Brandford Rd. PHONE 747 6149

PROPERTY LOCATION: Locelyn Acres.
SUBDIVISION Mink Hollow + Highland Rd. LOT NO. #4
ROAD AND DESCRIPTION _____

SIZE OF LOT 3 ac. TYPE BLDG. SFD 3
(NUMBER OF BEDROOMS)

THE SYSTEM INSTALLED UNDER THIS APPLICATION IS ACCEPTABLE ONLY UNTIL PUBLIC FACILITIES BECOME AVAILABLE. I FULLY UNDERSTAND THE FEE CONNECTED WITH THE FILING OF THIS PERC TEST APPLICATION IS NON-REFUNDABLE UNDER ANY CIRCUMSTANCES. I ALSO AGREE TO COMPLY WITH ALL M.O.S.H.A. REQUIREMENTS IN TESTING THIS LOT.

James Potts
(SIGNATURE OF APPLICANT)


APPROVED BY _____ FOR _____ DATE _____

REJECTED BY _____ FOR _____ DATE _____


HOLD PENDING FURTHER TESTS _____ DATE _____

REASONS FOR REJECTION OR HOLDING _____

THIS IS NOT A PERMIT

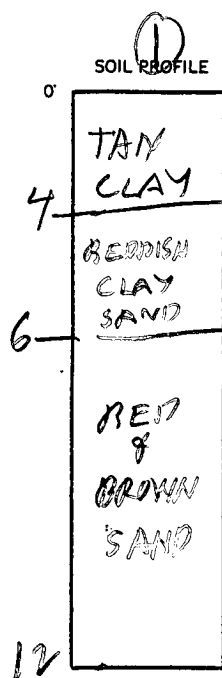

STAKE
LOT 4
LOT 5

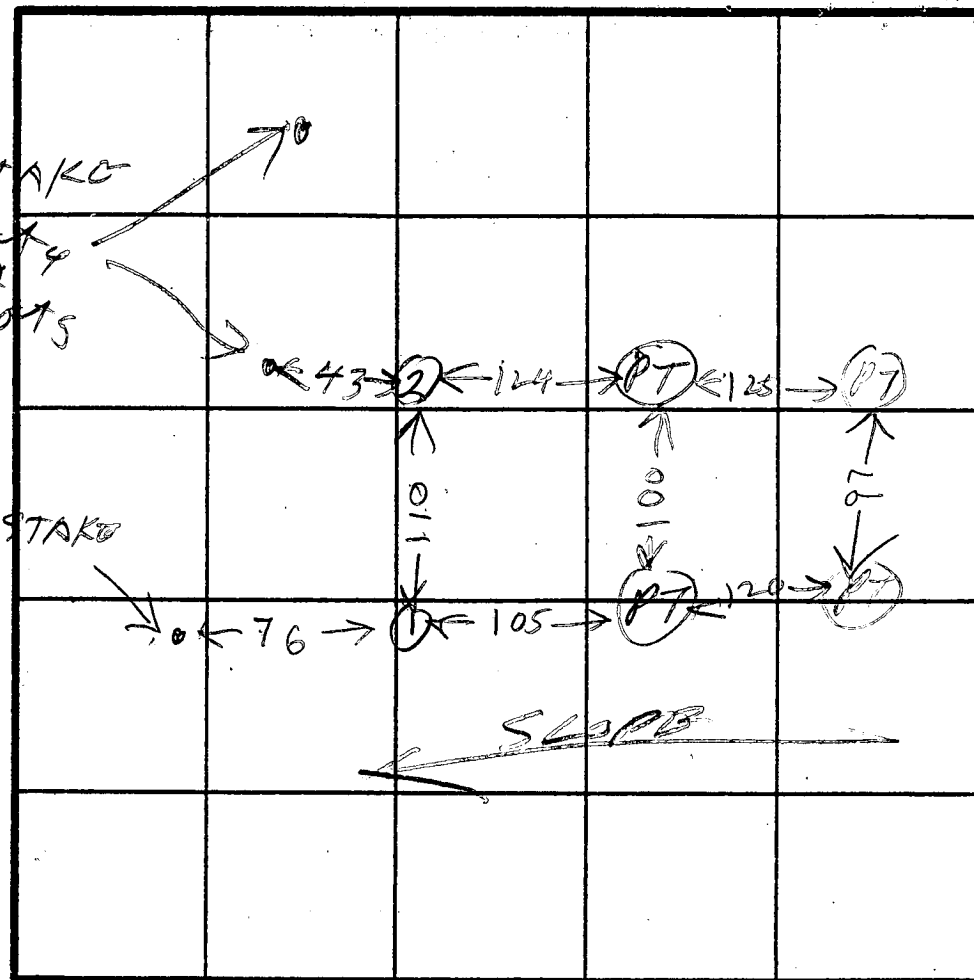

INDICATE NORTH - NAME ADJOINING ROADWAY AS BASE LINE.



DATE	TEST NO.	DEPTH	PRE-WET		TEST - 1" DROP		TIME
			START	STOP	START	STOP	
10/15/82	1D	7 1/2	1142	1143	1143	1144	1
	1S	5	1145	1149	1149	1156	7
	1V	12	LOOKS	OK	SEE	SOIL PROFILE	
	2D	8	1217	1218	1218	1220	2
	2S	4	1217	1225	1225	1237	12
	2V	12	LOOKS	OK	SEE	SOIL PROFILE	

REMARKS

POT

TYPE OF SOIL

TESTED BY

BH

ALSO PRESENT

B DIMMITT
C CISELL

site plan

6542 Mink Hollow Rd

N 39° 10' 50" W

MIN. BLDG. LINE

LOCATION OF FUTURE GARAGE

EXIST. WELL LOCATION

128' 0" SETBACK

x 494.8 ±

491.8 x

S 50° 49' 30" W 325'

MIN. BUILDING LINE

MIN. BLDG. LINE

SEPTIC ZONE

60' SETBACK

30' SETBACK

COMPASS NORTH

TRUE NORTH

MIN. BUILDING LINE

30' SETBACK


N 39° 10' 50" W 321'


SITE PLAN

SCALE: 1" = 20' - 0"

1	11070.678
4	11075.004
2	11145.207



- or pipe stem driveway.
- The coordinates shown hereon are based on an assumed datum.
 - This property is zoned "R" per 10/3/77 comprehensive zoning plan.

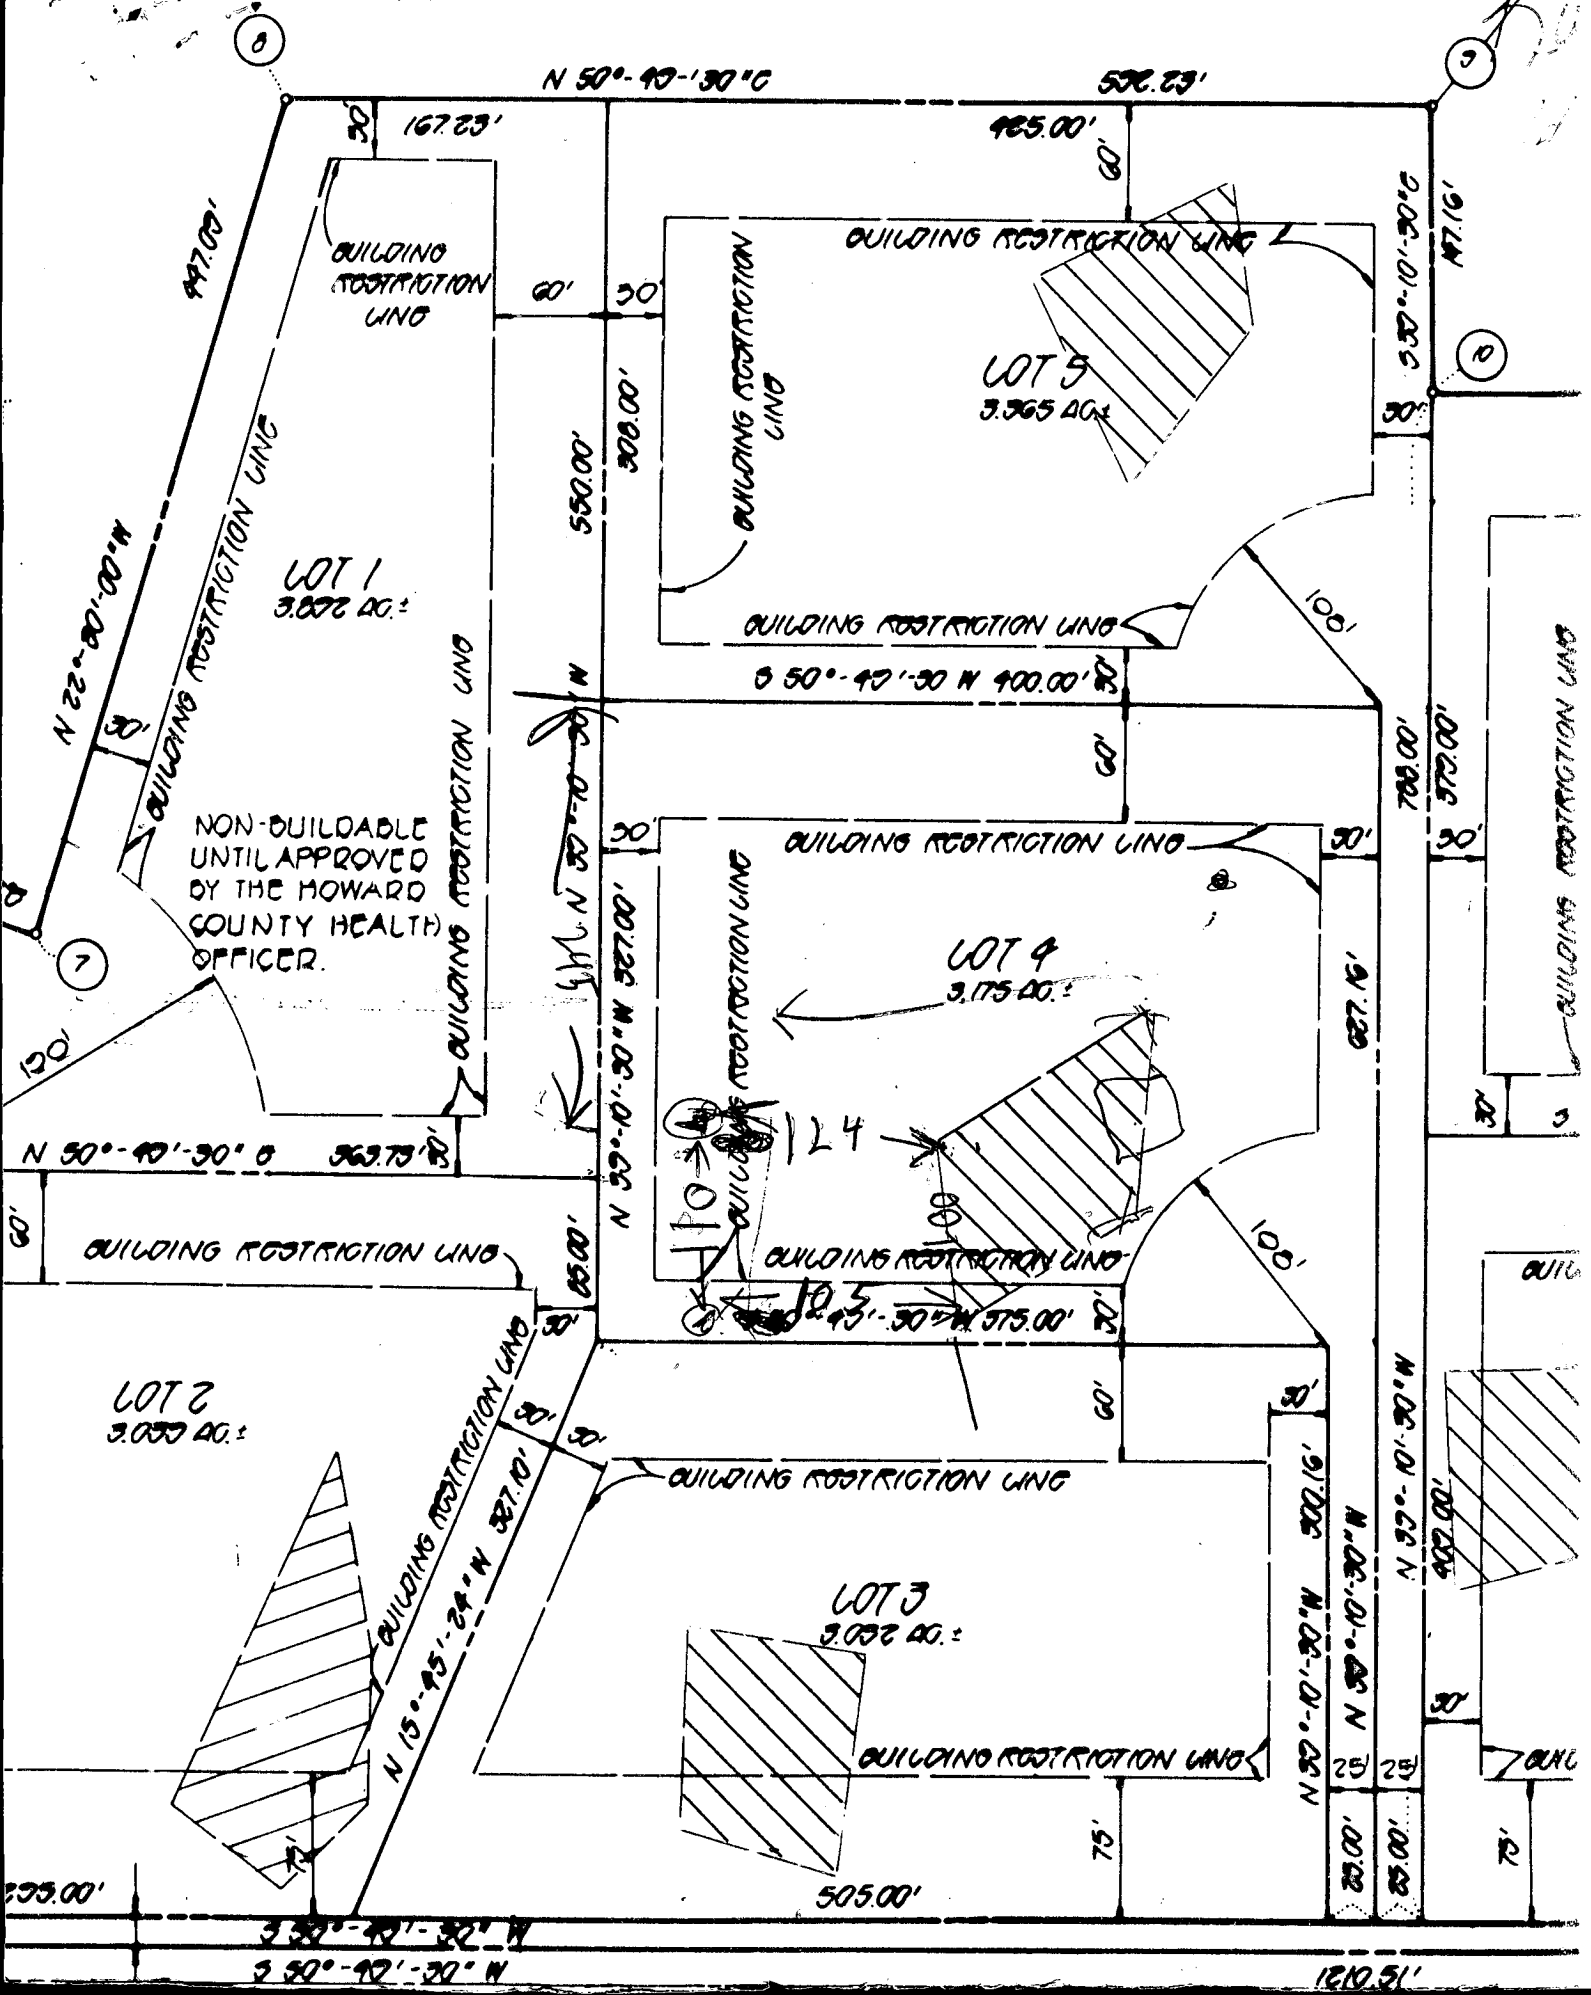

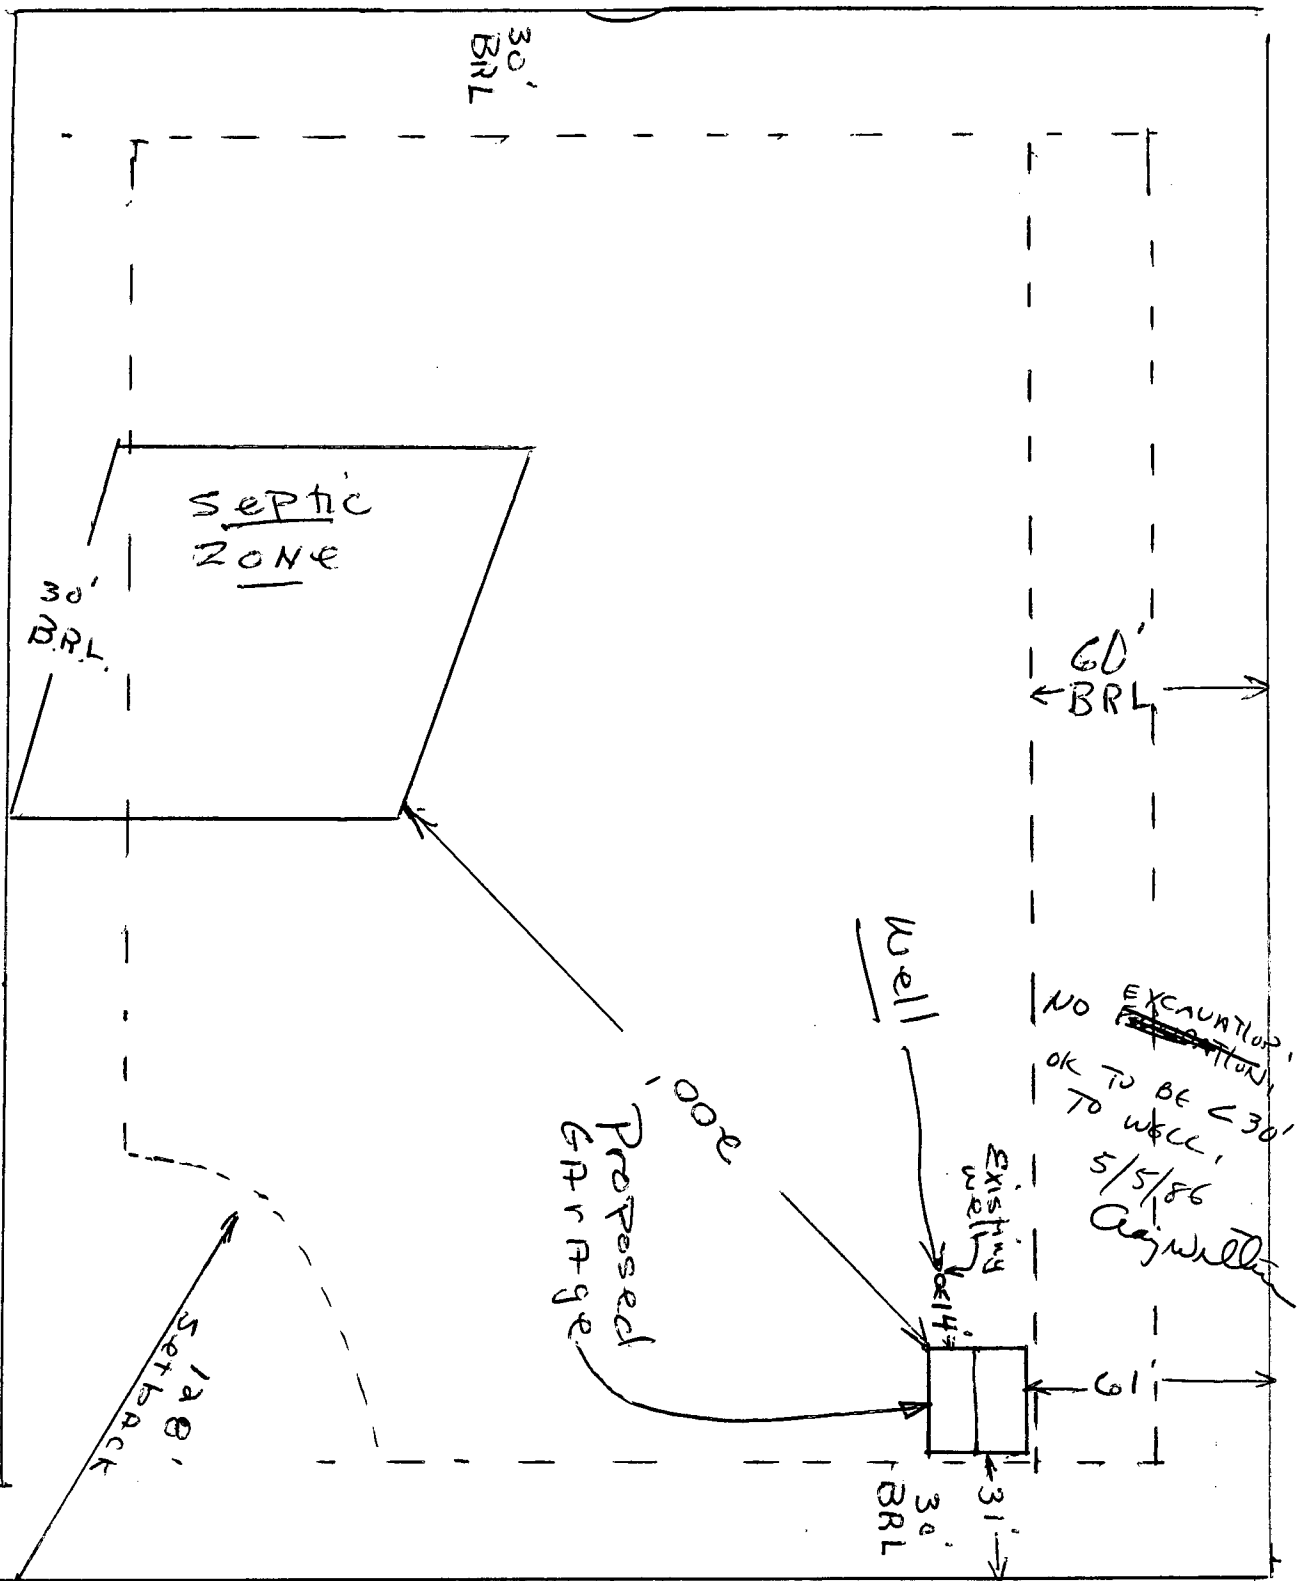

Jim Potts
 6542 Mink Hollow Rd.
 Highland Ind. 47253
 20777

Lot # 4 sec 1 Locelyn Acres
 Parcel 388 Liber 1123 Folio 32
 5th district.

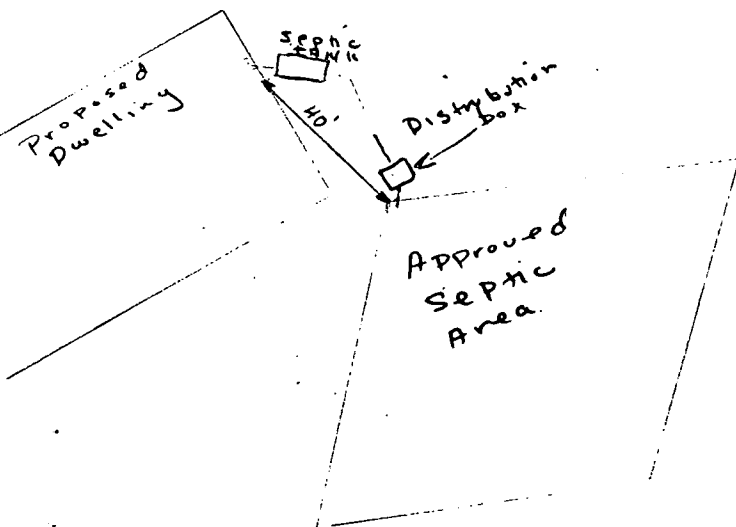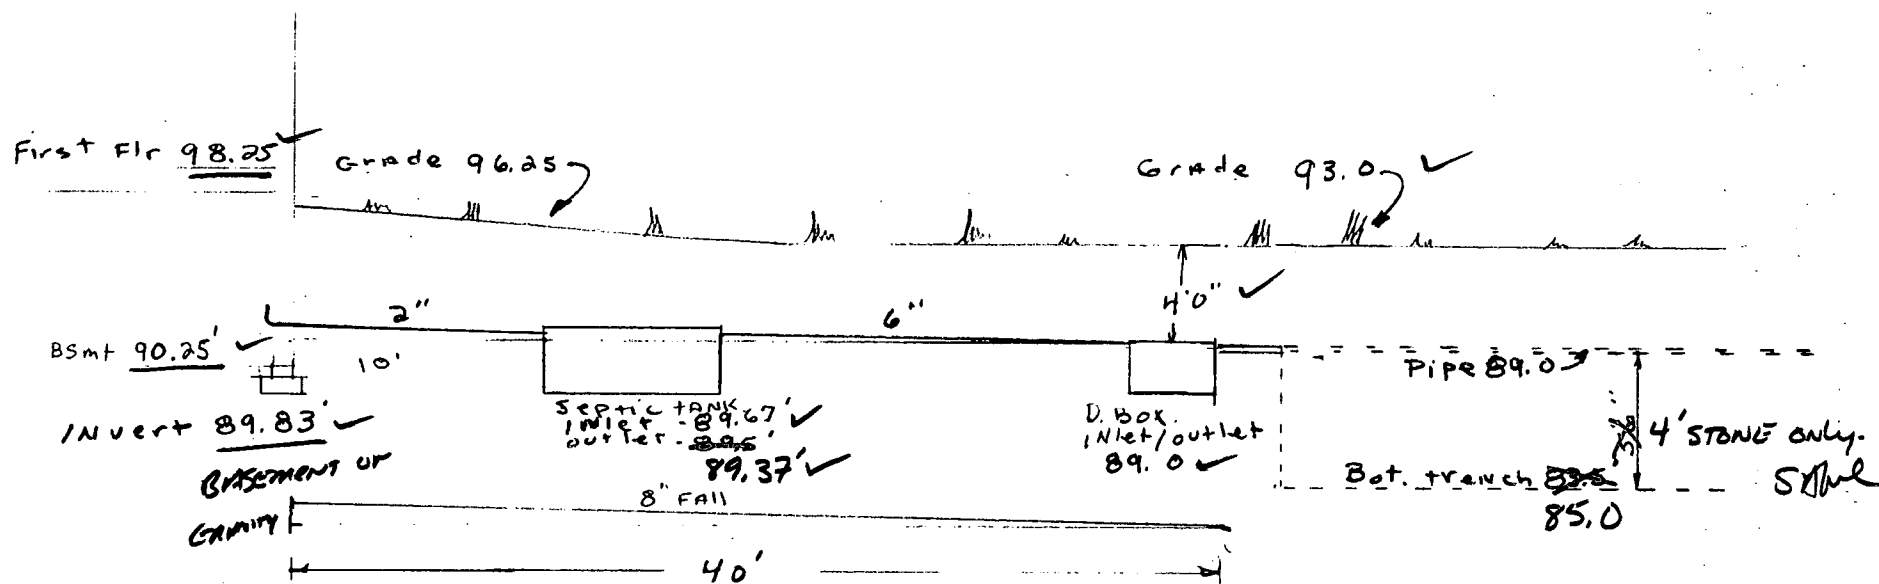

12/2/86
 elevations ok
 w/ changes in
 specs.
 S. Hall

BLDG. PERMIT SIGNED
 AND RETURNED 12/2/86
 S. Hall
 BP # 9202

6542 Mink Hollow Rd.
Highland md 20777
Jocelyn Acres Lot #4 Sec 1
James T & Ann B Potts
1209 Brandford Rd.
Catonsville md 21228
Off. 744-8339 & 747-6149

Pump test to begin at 9:00 A.M. (3 hours)


B 1 12323		SEQUENCE NO. WRA USE ONLY		STATE OF MARYLAND				WRA PERMIT NUMBER			
(THIS NUMBER IS TO BE PUNCHED IN COLS. 3-6 ON ALL CARDS)				APPLICATION FOR PERMIT TO DRILL WELL				H0-73-4284			
				please print or type				fill in this form completely			
DATE RECEIVED 09-27-82		10/6/82		8 (WRA USE ONLY) 13		OWNER INFORMATION		B 3		LOCATION OF WELL	
Potts Construction Company, Inc.		Potts Ann + Jimmy		LAST NAME 15		OWNER 1209 Brandford Road		FIRST NAME 34		COUNTY Howard	
1209 Brandford Rd.		Baltimore Md. 21228		TOWN 57		STATE 76		ZIP 4		SUBDIVISION 23	
B 1 CONTINUED		DRILLER INFORMATION		238		77 LICENSE NO. 80		21		LOT 48	
Joseph L. Wayne		Joseph L. Wayne		Sept 27, 82		DATE		50		NEAREST TOWN Highland	
B 2		WELL INFORMATION		5		AVERAGE DAILY QUANTITY NEEDED (GAL. PER DAY) 14		20		MILES FROM TOWN (enter 0 if in town) 1 1/2	
APPROX. PUMPING RATE (GAL. PER MIN) 5		USE FOR WATER (CIRCLE APPROPRIATE BOX)		24		APPROXIMATE DEPTH OF WELL 200		28		FEET	
☒ HOME (SINGLE OR DOUBLE HOUSEHOLD UNIT ONLY)		☐ FARMING (LIVESTOCK WATERING & AGRICULTURAL IRRIGATION)		☐ INDUSTRIAL, COMMERCIAL, STATE AND FEDERAL GOV. OTHER (REQUIRES APPROPRIATION PERMIT)		☐ PUBLIC OR PRIVATE WATER COMPANY (REQUIRES APPROPRIATION PERMIT AND STATE HEALTH DEPARTMENT APPROVAL)		☐ TEST, OBSERVATION, MONITORING (MAY REQUIRE APPROPRIATION PERMIT)		DIRECTION OF WELL FROM TOWN (CIRCLE BOX)	
APPROXIMATE DIAMETER OF WELL 6		Method of Drilling (circle one)		BORED (OR AUGERED) JETTED JETTED & DRIVEN		30- AIR ROTARY AIR-PERCUSSION ROTARY (HYDRAULIC)		37 CABLE REVERSE ROTARY DRIVE-POINT ROTARY		ON WHICH SIDE OF ROAD (CIRCLE APPROPRIATE BOX)	
REPLACEMENT OR DEEPEENED WELLS (Circle Appropriate Box)		☒ THIS WELL WILL NOT REPLACE AN EXISTING WELL		☐ THIS WELL WILL REPLACE A WELL THAT WILL BE ABANDONED AND SEALED		☐ THIS WELL WILL REPLACE A WELL THAT WILL BE USED AS A STANDBY		☐ THIS WELL WILL DEEPEEN AN EXISTING WELL		NEAR WHAT ROAD Mink Hollow Road	
PERMIT NUMBER OF WELL TO BE REPLACED OR DEEPEENED (IF AVAILABLE) 41		52		NOT TO BE FILLED IN BY DRILLER HEALTH DEPARTMENT APPROVAL		Howard		A31352 A32210		COUNTY NO.	
Not to be filled in by driller (WRA USE ONLY)		APPROX. PERMIT NUMBER 54		GAP		63		EHA SIGNATURE		STATE HEALTH CIRCLE BOX	
FORCE FS		WRITE INITIALS IN BOX		CONDITIONS		H0-73-4284		MO 09 DAY 30 YR 82		DATE	
B 5		SPECIAL CONDITIONS 8-63		(WRA USE ONLY)		NORTH 495		EAST 0806		ELEV. (FT.)	
1 2 3		4 5 6		7 8 9		10 11 12		13 14 15		16 17 18	

Jim + Ann Potts
1209 Brandford Rd
Catonville VA
20228

Proposed well 9/28/82 wellsite rejected

MENTS INTO THE PRIVATE SEWAGE E
TION OF A MODIFIED SEWAGE EASEM
NECESSARY.

WILLIAM L. KAPLAN
AND PAUL J. DEMMIT
K82/057

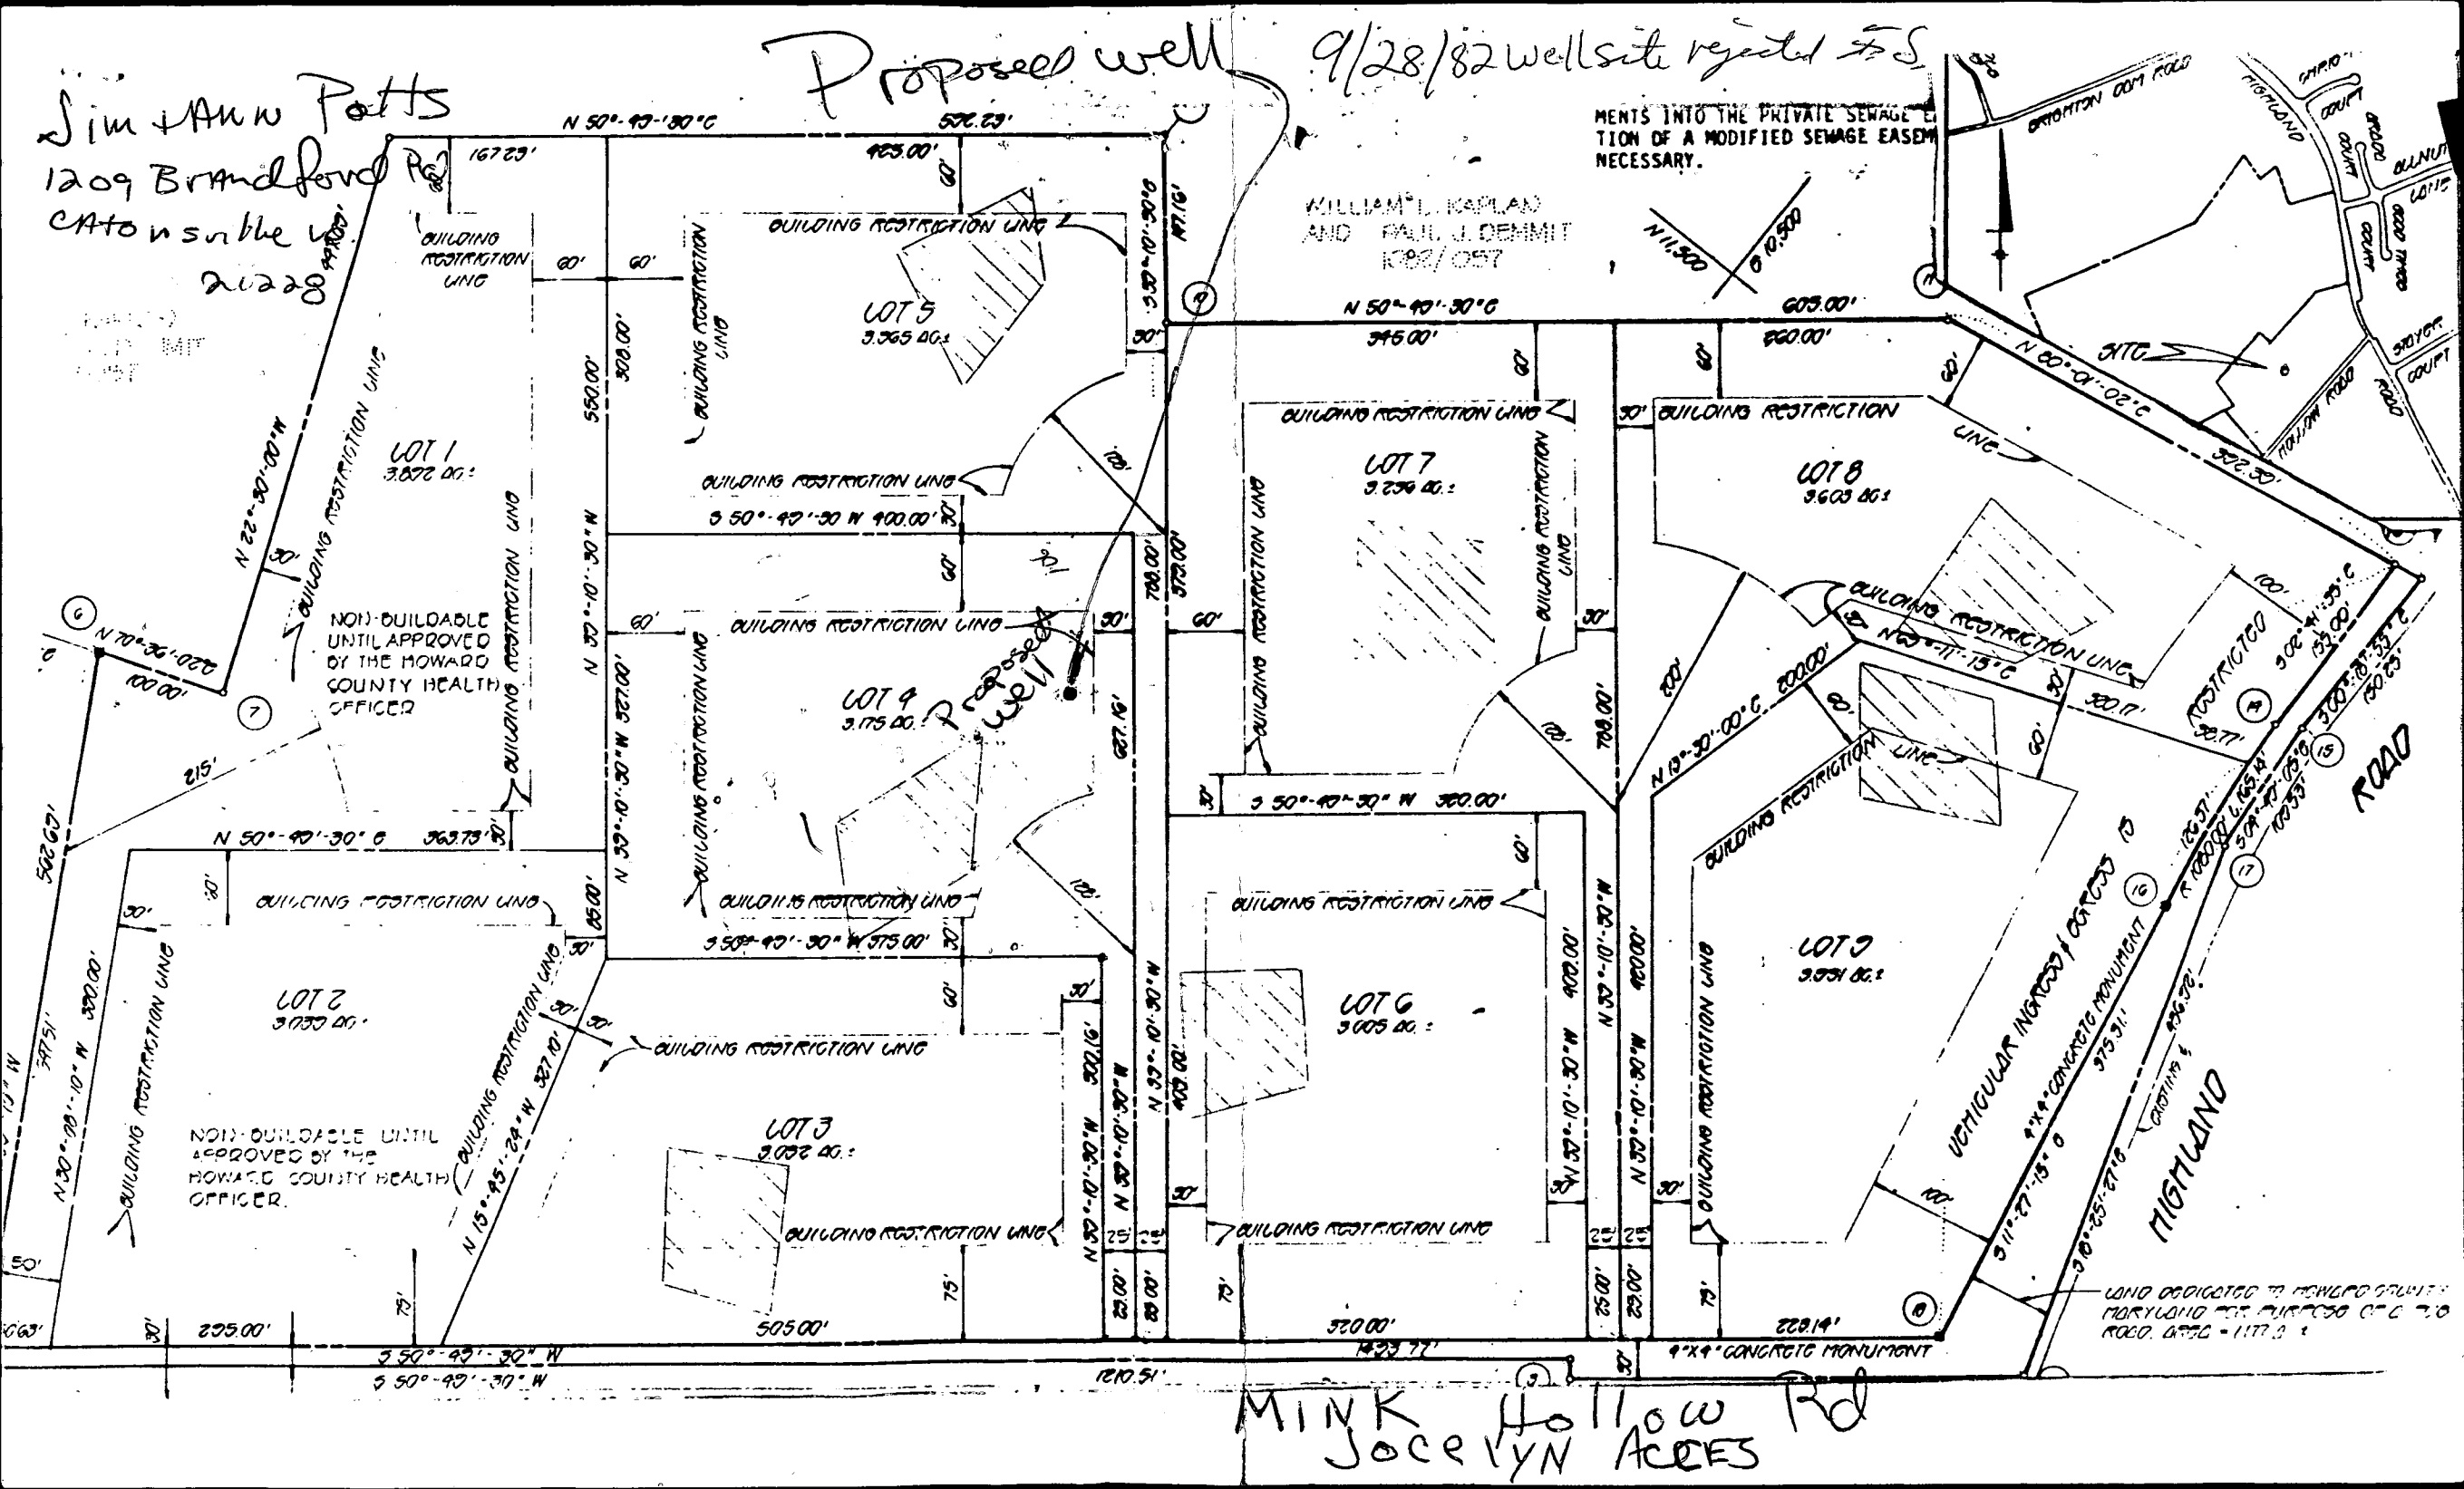

initialed: A.P.
9-30-82

9/30/82
Revised Well Site OK
J.S.

25' EASEMENT
FOR INGRESS AND
EGRESS TO LOTS 3, 4 AND 5

[illegible]

C-1 4168	SEQUENCE NO. (OEP USE ONLY)	STATE OF MARYLAND WELL COMPLETION REPORT FILL IN THIS FORM COMPLETELY PLEASE PRINT OR TYPE	THIS REPORT MUST BE SUBMITTED WITHIN 45 DAYS AFTER WELL IS COMPLETED. COUNTY NUMBER A 31352A 32210
----------	--------------------------------	---	---

Date Received (OEP use only)	DATE WELL COMPLETED 10 582	Depth of Well 125 (TO NEAREST FOOT)	PERMIT NO. FROM "PERMIT TO DRILL WELL" HO-73-4284
---------------------------------	-------------------------------	---	---

OWNER last name Potts	first name Ann & Jimmy	TOWN Highland
STREET OR RFD Mink Hollow Rd.	SUBDIVISION Jacelyn Acres	SECTION 1 LOT 4

WELL LOG Not required for driven wells		
STATE THE KIND OF FORMATIONS PENETRATED, THEIR COLOR, DEPTH, THICKNESS AND IF WATER BEARING		
DESCRIPTION (Use additional sheets if needed)	FEET FROM TO	Check if water bearing
Brown Shale 0 22		
Gray mica rock 22 125		

WELL HAS BEEN GROUTED (Circle Appropriate Box)	
YES ☒ Y	NO ☐ N
TYPE OF GROUTING MATERIAL	
CEMENT ☒ CM	BENTONITE CLAY ☒ BC
NO. OF BAGS 5	NO. OF POUNDS 420
GALLONS OF WATER 30	
DEPTH OF GROUT SEAL (to nearest foot) from 0 ft. to 24 ft.	
Casing types insert appropriate code below	
STEEL ☒ ST	CONCRETE ☐ CO
PLASTIC ☐ PL	OTHER ☐ OT
MAIN CASING TYPE	
ST 6	26
OTHER CASING (if used) diameter (inch) depth (feet) to	
EACH CASING	

SCREEN RECORD		
screen type or open hole	insert appropriate code below	
STEEL ☒ ST	BRASS ☐ BR	OPEN HOLE ☐ HO
PLASTIC ☐ PL	OTHER ☐ OT	

C 2	
DEPTH (nearest ft.)	
1 125	2 24
3	
SLOT SIZE	
DIAMETER OF SCREEN (NEAREST INCH)	
GRAVEL PACK	
IF WELL DRILLED WAS FLOWING WELL CIRCLE BOX ☒ F	

CIRCLE APPROPRIATE BOX	
☒ A	A WELL WAS ABANDONED AND SEALED WHEN THIS WELL WAS COMPLETED
☐ E	ELECTRIC LOG OBTAINED
☐ P	TEST WELL CONVERTED TO PRODUCTION WELL
I HEREBY CERTIFY THAT THIS WELL HAS BEEN CONSTRUCTED IN ACCORDANCE WITH COMAR 10.17.13 "WELL CONSTRUCTION" AND IN CONFORMANCE WITH ALL CONDITIONS STATED IN THE ABOVE CAPTIONED PERMIT, AND THAT THE INFORMATION PRESENTED HEREIN IS ACCURATE AND COMPLETE TO THE BEST OF MY KNOWLEDGE.	
DRILLERS IDENT. NO. 238	
DRILLERS SIGNATURE	
SITE SUPERVISOR (sign of driller or journeyman responsible for sitework if different from permittee)	

C 3		
PUMPING TEST		
HOURS PUMPED (nearest hour)	3	
PUMPING RATE (gal. per min. to nearest gal.)	9	
METHOD USED TO MEASURE PUMPING RATE Submersible		
WATER LEVEL (distance from land surface)		
BEFORE PUMPING	23	
WHEN PUMPING	61	
TYPE OF PUMP USED (for test)		
☒ A air	☐ P piston	☐ T turbine
☐ C centrifugal	☐ R rotary	☐ O other (describe below)
☐ J jet	☒ S submersible	

PUMP INSTALLED	
DRILLER WILL INSTALL PUMP (CIRCLE APPROPRIATE BOX)	
YES ☒ Y	NO ☐ N
IF DRILLER INSTALLS PUMP, THIS SECTION MUST BE COMPLETED FOR ALL WELLS EXCEPT HOME USE	
TYPE OF PUMP (WRITE APPROPRIATE LETTER IN BOX - SEE ABOVE: (A, C, J, P, R, S, T, O))	
CAPACITY: GALLONS PER MINUTE (to nearest gallon)	
PUMP HORSE POWER	
PUMP COLUMN LENGTH (nearest ft.)	
CASING HEIGHT (circle appropriate box and enter casing height)	
☒ above	LAND SURFACE
☐ below	2 (nearest foot)

LOCATION OF WELL ON LOT	
SHOW PERMANENT STRUCTURE SUCH AS BUILDING, SEPTIC TANKS, AND/OR LANDMARKS AND INDICATE NOT LESS THAN TWO DISTANCES (MEASUREMENTS TO WELL)	
Back lot line	
47 ft	
Well	
40 ft	
Right lot line	

FIELD DATA SHEET
HOWARD COUNTY WELL YIELD TEST

Well Permit No. HO - 73-4284

Location of property (road) Mink Hollow Rd.

Subdivision Jocelyn Acres Lot 4 Block - Plat - Sec. 1

Well Driller Joseph L. Mayne Owner Ann & Jimmy Potts

Depth of well 125'

Distance of measuring point (M.P.) above ground 1.2

Static water level (S.W.L.) below M.P. 25

1. High rate pumping -- reservoir drawdown

Time pump started 9:00

Pumping rate 9 a.m.

Total time 10:30 to reach pumping water level 61 ft. below M.P.

II. Recovery pump test data - observations to be recorded every 15 minutes

[illegible]

APPLICATION FOR PITLESS ADAPTER, WELL PUMP AND PRESSURE TANK INSTALLATION

Howard County Health Department
Bureau of Environmental Health
3525-H Ellicott Mills Drive
Court House Square
Ellicott City, Md. 21043
461-9933

8/5/86
partial WPI.
(did not leave
sticker)
only 14' from
garage
corner

New Installation ☒
Replacement ☐

Receipt # 37445
Date 8/11/86

Name of Installer David F. Rickle Plumbing & Heating

Telephone 795-1220

License number Ho. Co. #5335

Certified Well Pump Installer ☐ Well Driller ☐ Registered Plumber ☒

Name of Property Owner James T. Potts

Telephone

Subdivision Jocelyn Acres Lot # 4

Well tag # HO-73-4284

Site Address 6542 Mink Hollow Road
Highland, Maryland 20777

Pump

1. Type
 - a. Deep well jet ☐
 - b. Shallow well jet ☐
 - c. Submersible 4" ☒

Motor

1. Horsepower 1/2
2. RPM 3450
3. Voltage ☐
 - a. 110 ☐
 - b. 220 ☒

Pitless Adapter

1. Make Martinson
2. Model # B-10X
3. Depth ☐

2. Make Goulds

3. Model # 7EH05-412

4. Capacity 12 GPM

5. Pump exceeds well capacity Yes ☒ No ☐

6. If Yes, is low pressure cutoff switch installed? Yes ☐ No ☒

7. What methods are used to protect the pump and electrical wiring from vibrations? Torque arrestors ☒ Cable guards ☐ Other ☐

8/5/86 Could not verify
depth - trench
covered, cap secured

Lines +
ground
wire shown

Tank

1. Capacity 42 gallon Ratch
2. Pressure relief
valve? Yes - 1/2"

Piping

1. Type Polybutylene
2. Size 1" I.P.
3. NSF and/or BSCA
ASTM # Code approved D-2662
4. Depth of supply
line ☐

Well data

1. Depth 125 ft.
2. Yield 9 GPM
3. Static water
level 25 ft. in floor
4. Will water supply
be disinfected by
installer? No

coming out
of conduit
in floor

8/5/86
tubing in
seen in
garage
floor by Contractor

I understand that it is my responsibility to notify the Howard County Health Department when the installation is ready for inspection (otherwise this permit is null and void).

All information given above is true to the best of my knowledge.

Signature of Applicant: David F. Rickle

Date: July 21, 1986

Note: A sticker indicating approval/status of the installation will be placed on the well casing at the time of the inspection.

8/5/86
Not in