

Record Detail \* (This section is required.)

<b>Permit Type</b>	<b>Permit Number</b>	<b>Opened Date</b>
Building/Residential/Misc/Porch	B23002230	06/20/2023
<b>Description of Work</b>		
SFD/ CONSTRUCT 20X22 SCREENED PORCH WITH AN 18X10 DECK WITH LANDING AND STAIRS TO GRADE		

[check spelling](#)

Address \* (This section is required.)

Search Reset Clear Get Parcel & Owner

<b>Street #</b>	<b>Street Name</b>	<b>Street Type</b>		
1807	DAVIS BRANCH	RD		
<b>Unit Type</b>	<b>Unit #</b>	<b>X Coordinate</b>	<b>Y Coordinate</b>	
--Select--		-76.87303	39.31989	
<b>City</b>	<b>State</b>	<b>Zip Code</b>	<b>Primary</b>	
WOODSTOCK	MD	21163	Yes	

Parcel \* (This section is required.)

Search Reset Clear Get Address & Owner

GIS ID *	Parcel	Parcel Area	Land Value	Improved Value	Exemption Value	Plan Area
930157	225,287	0.97	195800	0	0	RURAL
<b>Legal Description</b>						
LOT 5 42604 SQ[ ]1807 DAVIS BRANCH ROAD[ ]MYRTUE PROPERTY INCL RSB						

[check spelling](#)

Block	Lot	Census Tract	Council Dist	Inspection Dist	Supervisor Dist	Map #	DAP Zone
	5	603000	5	6			
<b>Plan Area</b>	<b>State Tax Id</b>		<b>Subdivision Name</b>				
	1403352374		Myrtue Property				
<b>Section</b>	<b>Area</b>		<b>Tax Map</b>				
			10				
<b>Grid</b>	<b>Zoning District</b>		<b>ADC Map</b>				
10-24	RC-DEO		4695-A9				
<b>SDP No.</b>	<b>Final Plan No.</b>		<b>WP File No.</b>				
	F-06-104						
<b>Record Plat No.</b>	<b>WS Contract No.</b>		<b>FDP No.</b>		<b>Primary</b>		
19961-1996					Yes		
<b>Owner Occupied</b>	<b>Year Built</b>		<b>Historic District</b>				
<input type="radio"/> Yes <input checked="" type="radio"/> No			<input checked="" type="radio"/> Yes <input type="radio"/> No				
<b>Historic District Registry No.</b>	<b>Stat Area</b>		<b>Flood Plain</b>				
	3-02A		<input type="radio"/> Yes <input checked="" type="radio"/> No				
<b>Building No</b>							

Owner \* (This section is required.)

Search Reset Clear

**Name \***  
SWENSON SHANNON E

**Address Line 1**  
5631 ROUNDTREE LANE

**Address Line 2**

**Address Line 3**

<b>Mail City</b> COLUMBIA	<b>Mail State</b> MD	<b>Mail Zip Code</b> 21045
<b>Phone</b> 301-674-3604	<b>Primary</b> Yes	
<b>E-mail</b>		
<b>Cell Number</b>	<b>Fax Number</b>	

**Professionals** (This section is not required.)

<b>License # *</b> 08010095285	<b>Business Name</b> TIMELESS CONSTRUCTION		
<b>License Type *</b> MHIC Ind	<b>First Name</b> DAVID	<b>Middle Name</b>	<b>Last Name</b> BENFER
<b>Primary</b> Yes	<b>Address Line 1</b> 5364 HESPERUS DRIVE		
	<b>Address Line 2</b>		
	<b>City</b> COLUMBIA	<b>State</b> MD	<b>ZIP Code</b> 21044-0000
	<b>Phone 1</b> 3016743604	<b>Phone 2</b>	<b>Fax</b> 4432838022
	<b>E-mail</b> DCBENFER@GMAIL.COM		

**Applicant** (This section is not required.)

Search    As Owner    As Lic. Prof    As Contact


Type *	First Name	MI	Last Name
Applicant	DAVID	CHRIS	BENFER
<b>Relationship</b> --Select--	<b>Full Name</b> DAVID CHRISTOPHER BENFER		
<b>Primary</b> Yes	<b>Organization Name</b> TIMELESS CONSTRUCTION		
	<b>Street Address</b> 5364 HESPERUS DRIVE		
	<b>Address Line 2</b>		
	<b>City</b> COLUMBIA	<b>State</b> MD	<b>Zip Code</b> 21044(-1846)
	<b>Phone</b> 301-674-3604	<b>Cell</b>	<b>Fax</b>
	<b>E-mail *</b> DCBENFER@GMAIL.COM		

**Addtl Info**

<b>Est Construction Cost *</b> 50000	<b>Housing Units *</b> 0	<b>Number of Buildings *</b> 0	<b>Public Owned</b> No
<b>Construction Type</b> --Select--			


**PORCH INFORMATION**

**PORCH INFORMATION**

<b>Capital Project-No Fee *</b>	<b>Capital Project Number</b>	<b>Fee Exempt</b>	<b>Roadside Tree Project Permit *</b>	<b>Roadside Tree Project Permit #</b>
<input type="radio"/> Yes <input checked="" type="radio"/> No		<input type="radio"/> Yes <input checked="" type="radio"/> No	<input type="radio"/> Yes <input checked="" type="radio"/> No	
<b>Existing Use *</b>	<b>Type of Porch *</b>	<b>Type of Porch Foundation *</b>	<b>Total Square Footage *</b>	
SFD	▼ Screened Porch	New Deck	▼ 440	SQFT
<b>Water Supply</b>	<b>Sewage Disposal</b>	<b>Expiration Date</b>		
▼ Private	▼ Private	12/18/2023 		


Submit

Cancel

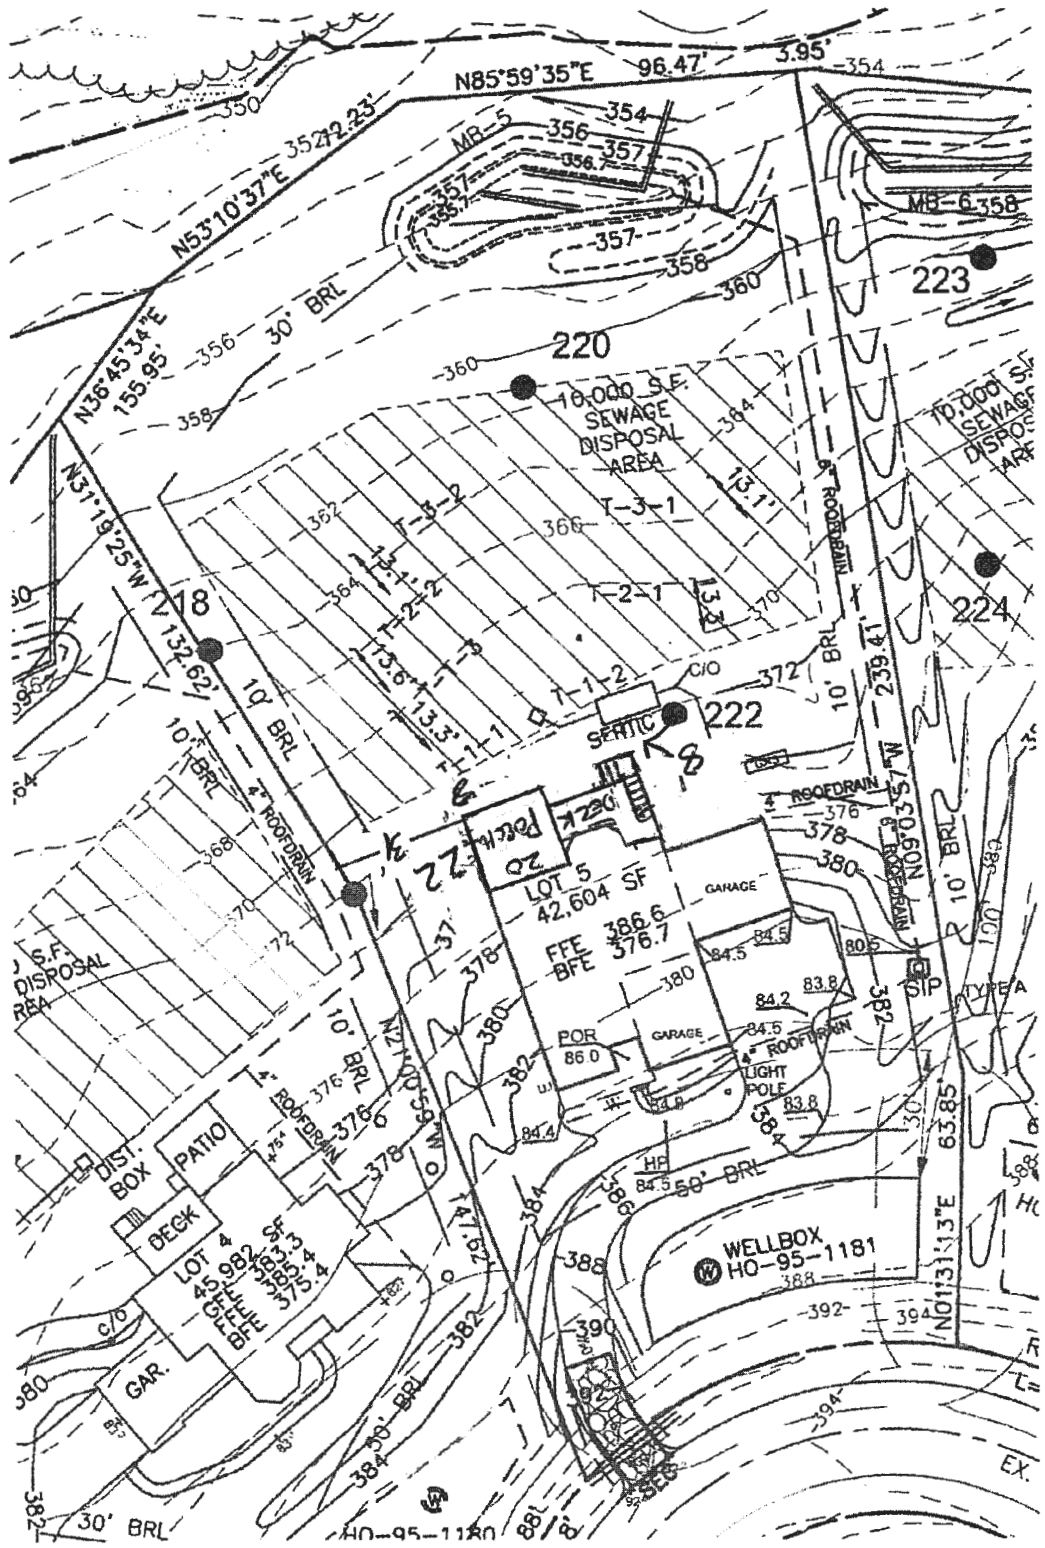

**PLAN VIEW**

1" = 40'

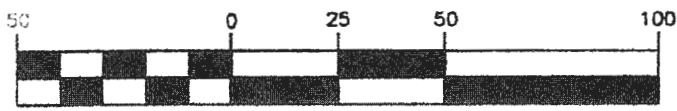

(IN FEET)