


NOTE: CONTRACTOR SHALL PROVIDE POSITIVE DRAINAGE AWAY FROM FOUNDATION AT ALL TIMES.

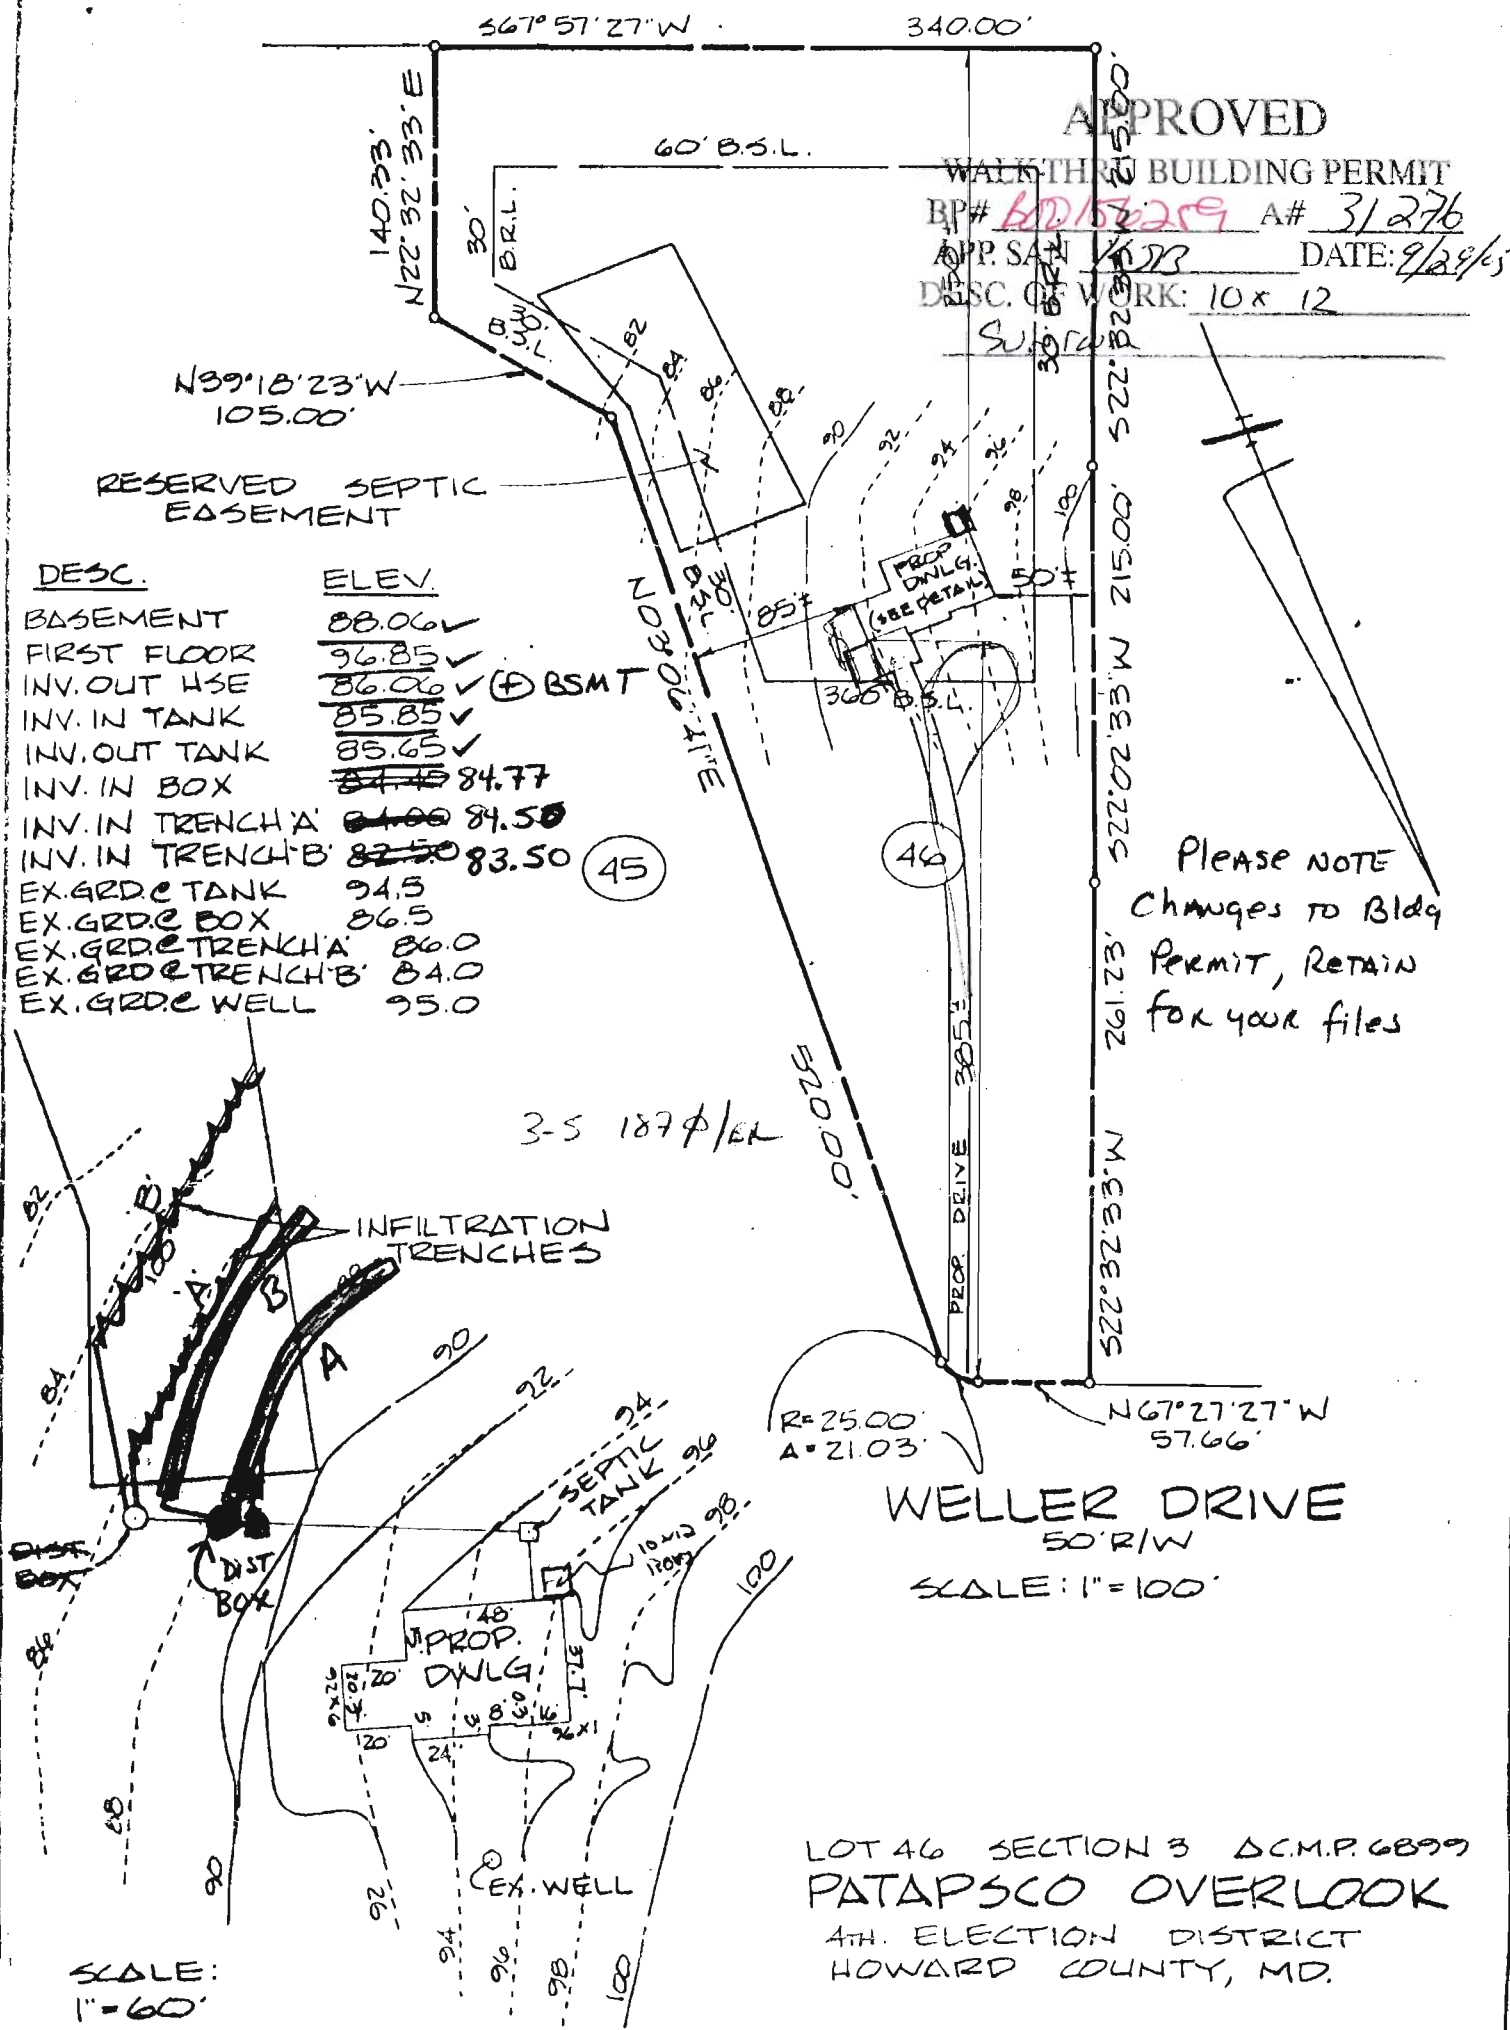

SITE PLAN
#710 WELLER DRIVE

VT ASSOCIATES, INC.

SURVEYING & ENGINEERING

3132 E. JOPPA RD. BALTIMORE, MARYLAND 21234

668-0090

date	4.14.87
scale	AS SHOWN
job no.	P. 4
drawn	IKE
checked	YSD.