

APPLICATION

A 26050

P _____

SEWAGE DISPOSAL TESTING

STATE OF MARYLAND - DEPARTMENT OF HEALTH AND MENTAL HYGIENE

HOWARD COUNTY HEALTH DEPARTMENT
ENVIRONMENTAL HEALTH SERVICES
P. O. BOX 476, ELLICOTT CITY, MARYLAND 21043
TELEPHONE: 465-5000, EXT. 356

DISTRICT 3rd
DATE 6/7/77

TO: THE COUNTY HEALTH OFFICER
ELLICOTT CITY, MARYLAND

I, HEREBY, APPLY FOR THE NECESSARY TEST IN ORDER TO CONSTRUCT (OR RECONSTRUCT) A SEWAGE DISPOSAL SYSTEM.

PROPERTY OWNER William B. Ridgely

ADDRESS Spring Meadow Farm Cooksville, Md. 21728 PHONE Carol Clark

531-5115

PROPERTY LOCATION:

SUBDIVISION Ridgely Property (Friendship Manor) LOT NO. 27

ROAD AND DESCRIPTION Rte. 144 - Rte. 32

SIZE OF LOT ? TYPE BLDG. 3 or 4 bedroom
NUMBER OF BEDROOMS

IF NOT SINGLE RESIDENCE DESCRIBE _____

THE SYSTEM INSTALLED UNDER THIS APPLICATION IS ACCEPTABLE ONLY UNTIL PUBLIC FACILITIES BECOME AVAILABLE.

SIGNATURE OF APPLICANT /s/ Albert Scheel

APPROVED BY R.M. & D.O.M. FOR SW DATE 6-28-77 & 2-23-78
(KIND OF SYSTEM)

REJECTED BY _____ FOR _____ DATE _____
(KIND OF SYSTEM)


HOLD PENDING FURTHER TESTS _____ DATE _____

REASONS FOR REJECTION OR HOLDING _____

THIS IS NOT A PERMIT

0 some clay
 mixed
 3-4 sandy loam
 13

Lot 27

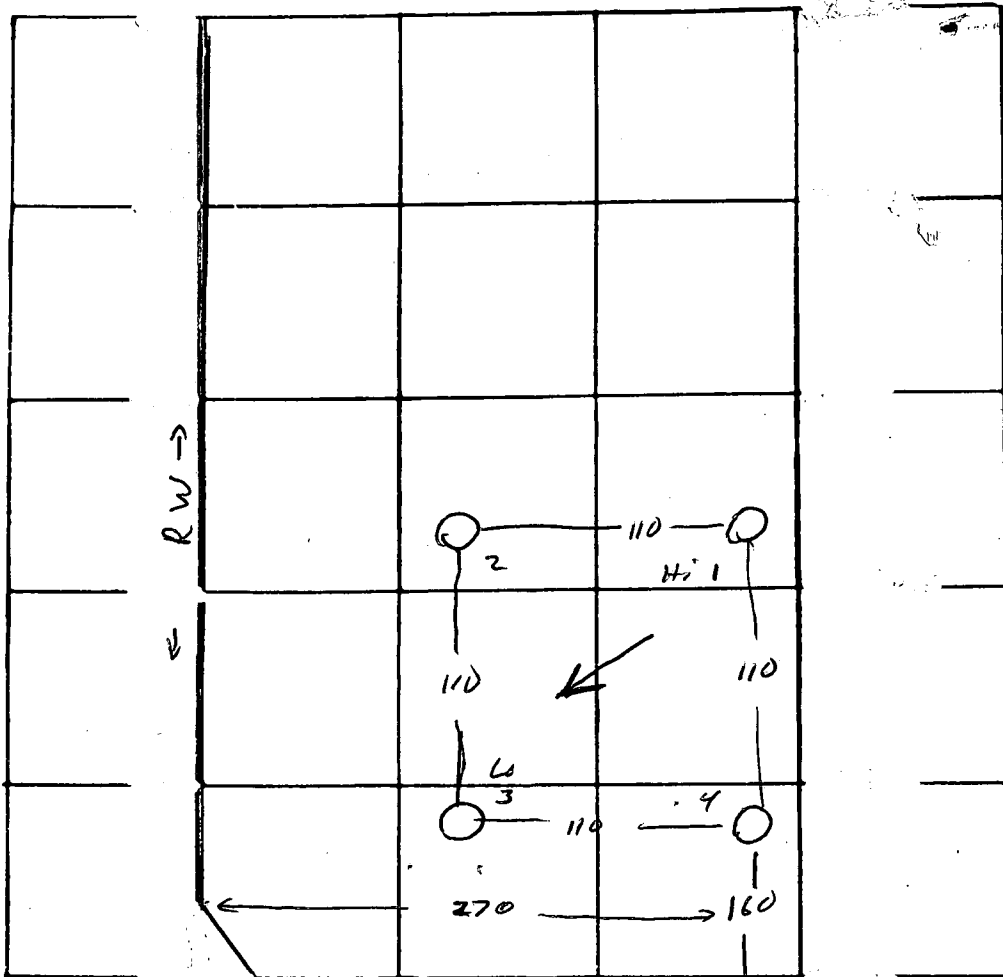

NORTH - NAME ADJOINING ROADWAY AS BASE
 ← RT 144 →

DATE	TEST NO.	DEPTH	PRE-WET		TEST - 1" DROP		TIME
			START	STOP	START	STOP	
28 June 77	1	4	2 35	2 36	2 36	2 38	2
	1A	13	2 35	2 36	2 36	2 41	5
	2	13	vis	-	same	-	-
	3	4	2 47	2 49	2 49	2 53	4
	3A	13	"	2 49	2 48	2 53	4
	4	4	2 48	2 50	2 50	2 54	4
	4A	13	2 48	2 50	2 50	2 55	5

REMARKS _____
 TYPE OF SOIL sandy loam
 TESTED BY M ALSO PRESENT: Scheel