

APPLICATION

PERCOLATION TESTING

A 26050

P _____

HOWARD COUNTY HEALTH DEPARTMENT
BUREAU OF ENVIRONMENTAL HEALTH
3525-H ELLICOTT MILLS DRIVE/ELLICOTT CITY, MARYLAND 21043
TELEPHONE: 313-2840

*Confirmation
test hole*

DISTRICT _____

DATE 5/21/03

TO: THE COUNTY HEALTH OFFICER
ELLICOTT CITY, MARYLAND

I HEREBY APPLY FOR THE NECESSARY TEST PRIOR TO APPLICATION FOR PERMIT TO CONSTRUCT (OR RECONSTRUCT) A SEWAGE DISPOSAL SYSTEM.

PROPERTY OWNER Thomas Twiss

ADDRESS _____ PHONE _____

AGENT OR PROSPECTIVE BUYER _____

ADDRESS _____ PHONE _____

PROPERTY LOCATION:

SUBDIVISION Friendship Manor LOT NO. 33

ROAD AND DESCRIPTION Rt 144, 1st left past Wellworth Way

TAX MAP _____ PARCEL # _____

SIZE OF LOT _____ TYPE BLDG. _____
(SINGLE FAMILY DWELLING OR COMMERCIAL)

THE SYSTEM INSTALLED UNDER THIS APPLICATION IS ACCEPTABLE ONLY UNTIL PUBLIC FACILITIES BECOME AVAILABLE. I FULLY UNDERSTAND THE FEE CONNECTED WITH THE FILING OF THIS PERC TEST APPLICATION IS NON-REFUNDABLE UNDER ANY CIRCUMSTANCES. I ALSO AGREE TO COMPLY WITH ALL M.O.S.H.A. REQUIREMENTS IN TESTING THIS LOT.

(SIGNATURE OF APPLICANT)

APPROVED BY _____ FOR _____ DATE _____

DISAPPROVED BY _____ FOR _____ DATE _____

HOLD PENDING FURTHER TESTS _____

REASONS FOR REJECTION OR HOLDING _____

PERCOLATION TEST PLAT/PRELIMINARY PLAT - TITLE OR I.D. # _____ DATE _____

SITE DEVELOPMENT PLAN/FINAL PLAT - TITLE OR I.D. # _____ DATE _____

THIS IS NOT A PERMIT

518006

COUNTY #

SOIL PROFILE

Center hole

Strong
Org. red
CL Lm

1'

org sil
Lm

2 1/2'

tan, greyish
brn 2.5YR 4/1
10YR 4/2

Subtle
mottles
SiCl Lm

5'

Restrictive
Cl 2.5Y 7/6

6'

beige brn
Micaceous
Lms


9'

Micac. fine S


TOTAL Rx

THROUGH HOLE

10% or
less

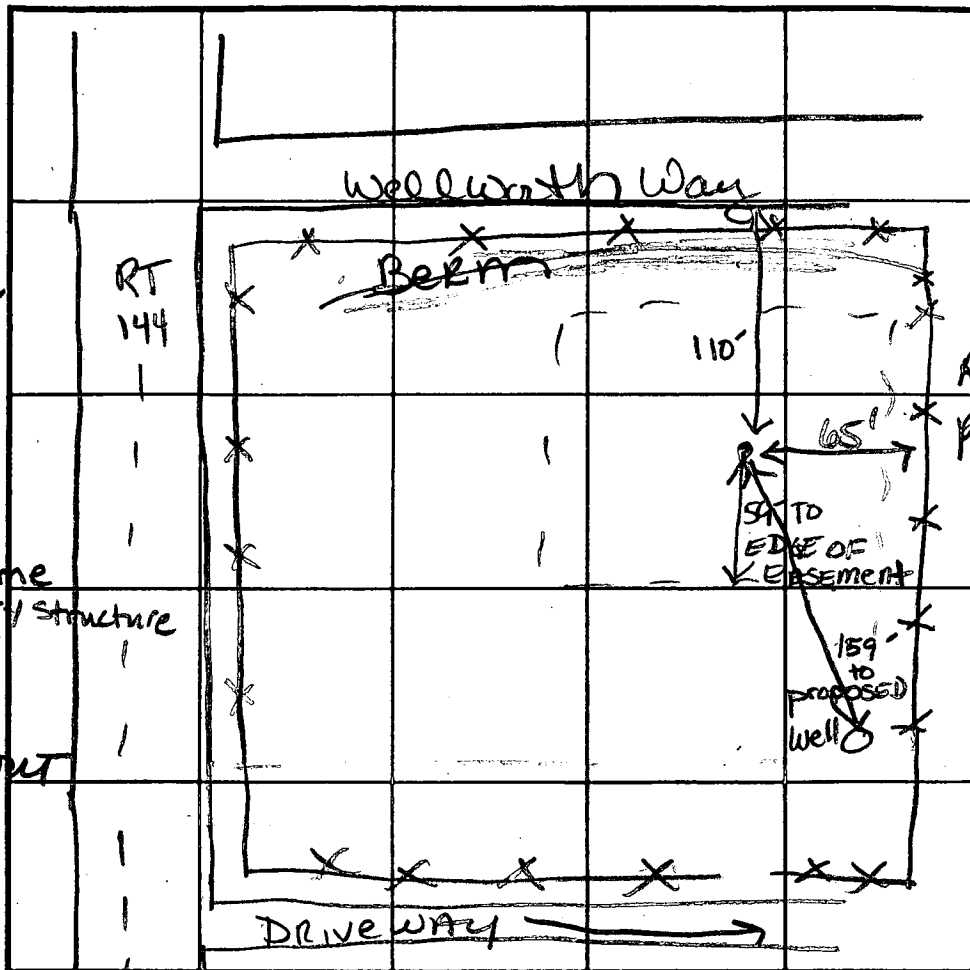

SOIL PROFILE

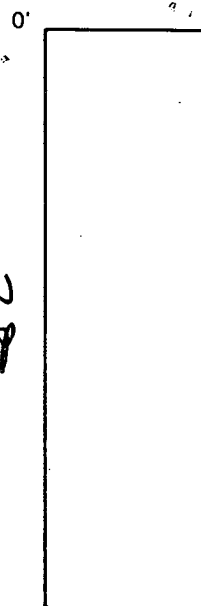

INDICATE NORTH - NAME ADJOINING ROADWAY AS BASE LINE.

DATE	TEST NO.	DEPTH	PRE-WET		TEST - 1" DROP		TIME
			START	STOP	START	STOP	
5-21	Center hole	6 1/2'	9:11 ⁴⁵	9:19 ¹⁵	9:19 ¹⁵	9:37	18 min

REMARKS Previously dug holes - No soil (detailed)
 TYPE OF SOIL description. may have undocumented
 TESTED BY CLAY @ 6' ALSO PRESENT _____
 TRENCH DESIGN DATA: AVERAGE PERCOLATION TIME _____ TRENCH WIDTH 3'
 INLET DEPTH 6 MAXIMUM BOTTOM DEPTH 8 SQ. FT/BEDROOM 210