

4/25/61 - ck/out

PERMIT

SEWAGE DISPOSAL SYSTEM

MARYLAND STATE DEPARTMENT OF HEALTH

HOWARD COUNTY

ELLICOTT CITY

DISTRICT 6

DATE 4-19-61

P 03608

A 00979

INDEXED

18 head

Excavating Contractors _____ IS PERMITTED TO INSTALL ALTER _____

ADDRESS Mt. Hebron, Ellicott City PHONE Ho. 5-3849

A SEWAGE DISPOSAL SYSTEM LOCATED AT _____

SUBDIVISION Donleigh ROAD Westleigh Drive LOT 14 A.

PROPERTY OWNER Mt. Rolling Development Corp.

ADDRESS 430 Westshire Drive, Balto. Md.

SPECIFICATIONS

DRAIN FIELD _____ DEPTH _____ FEET, BOTTOM AREA _____ SQ. FT.

SEEPAGE PITS _____ ABSORBENT SIDE-WALL AREA _____ SQ. FT.

SEPTIC TANK CAPACITY 750 GALLONS

FOR GARBAGE GRINDER, INCREASE DISPOSAL AREA 22% & TANK CAPACITY 50%.

OTHER Leaching bed 528 sq. ft. 4 to 5 ft. depth 20ft. from left side property line and 50 ft. from rd.


Septic tank cannot be installed more than 3 feet below original grade.

PLANS APPROVED BY Raymond Hodges DATE 1/6/61

FILL SEPTIC TANK AND DISTRIBUTION BOX WITH WATER BEFORE CALLING FOR AN INSPECTION. COVER NO WORK UNTIL INSPECTED AND APPROVED.

NEITHER THE HOWARD COUNTY COMMISSIONERS NOR THE HEALTH DEPARTMENT IS RESPONSIBLE FOR THE SUCCESSFUL OPERATION OF ANY SYSTEM.

A 00979

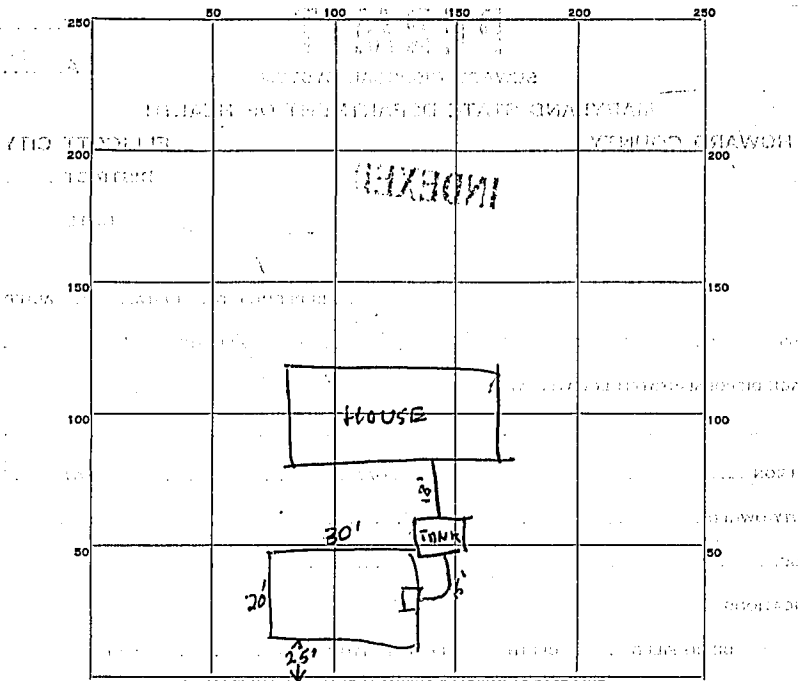

INDICATE NORTH - NAME ADJOINING ROADWAY AS BASE LINE.
 WESTLEIGH OR.

PERMIT CARD _____

SEPTIC TANK, LEVEL _____ CLEANOUTS _____

DISTRIBUTION BOX, LEVEL _____

TILE FIELD, DEPTH _____ FT. TRENCH WIDTH _____ FT.

GRAVEL DEPTH _____ IN. TOTAL LENGTH _____ FT.

NUMBER OF TRENCHES _____ TOTAL BOTTOM AREA _____

SEEPAGE PITS, INSIDE DIAMETER _____ FT. DEPTH BELOW INLET _____ FT.

ABSORBENT AREA _____ SQ. FT.

REMARKS leaching bed, 600 square feet total bottom area

DATE SYSTEM APPROVED complete 4/24/61 INSPECTOR Walter T. Joery