

only 1 application with the "checked" items completed

APPLICATION

SEWAGE DISPOSAL TESTING

STATE OF MARYLAND - DEPARTMENT OF HEALTH AND MENTAL HYGIENE

HOWARD COUNTY HEALTH DEPARTMENT
ENVIRONMENTAL HEALTH SERVICES

P. O. BOX 476 ELLICOTT CITY, MARYLAND 21043
TELEPHONE: 992-2330

A 35708

P _____

DISTRICT 5th

DATE 2-13-85

TO: THE COUNTY HEALTH OFFICER
ELLICOTT CITY, MARYLAND

I, HEREBY, APPLY FOR THE NECESSARY TEST IN ORDER TO CONSTRUCT (OR RECONSTRUCT) A SEWAGE DISPOSAL SYSTEM.

PROPERTY OWNER

~~William E. Larkin~~ LARKIN
Teral International, % Mrs. Gabriela M. Arroyo

ADDRESS

1310 Eighteenth St., N.W., Washington, D.C., 20036 PHONE 202-457-0727

PROPERTY LOCATION:

WATERFORD Section 3

SUBDIVISION

Huntington Estates - Section 2

LOT NO.

1X LOT 13

ROAD AND DESCRIPTION

North side of Brighton Dam Road approximately 3400

feet west of Ten Oaks Road (13230 WESTMEATH LANE)

SIZE OF LOT

3+ acres

TYPE BLDG.

Residence

(NUMBER OF BEDROOMS)

THE SYSTEM INSTALLED UNDER THIS APPLICATION IS ACCEPTABLE ONLY UNTIL PUBLIC FACILITIES BECOME AVAILABLE. I FULLY UNDERSTAND THE

FEE CONNECTED WITH THE FILING OF THIS PERC TEST APPLICATION IS NON-REFUNDABLE UNDER ANY CIRCUMSTANCES. I ALSO AGREE TO COMPLY

WITH ALL M.O.S.H.A. REQUIREMENTS IN TESTING THIS LOT.

Charles C. Coughlin

(SIGNATURE OF APPLICANT)

APPROVED BY

Siching Abel

FOR

Shallow tile fields

DATE

4-2-87

REJECTED BY

FOR

DATE

HOLD PENDING FURTHER TESTS

DATE

REASONS FOR REJECTION OR HOLDING

3-20-85. Perc. Results SATISFACTORY, HOLD FOR CERTIFIED

HOLE LOCATION, HOUSE AND well SITE. S. Abel

BLDG. PERMIT SIGNED

AND RETURNED


3/10/85
Serial # 52581 SFD

THIS IS NOT A PERMIT

Y. B. B. B.

① ②
SOIL PROFILE

0"	A1-3
6"	BROWN CLAY LOAM 100% SAPROLITE
4'	LIGHT BROWN SAND SILT 10-20% SAPROLITE
12'	SAPROLITE 20-30%
13'	

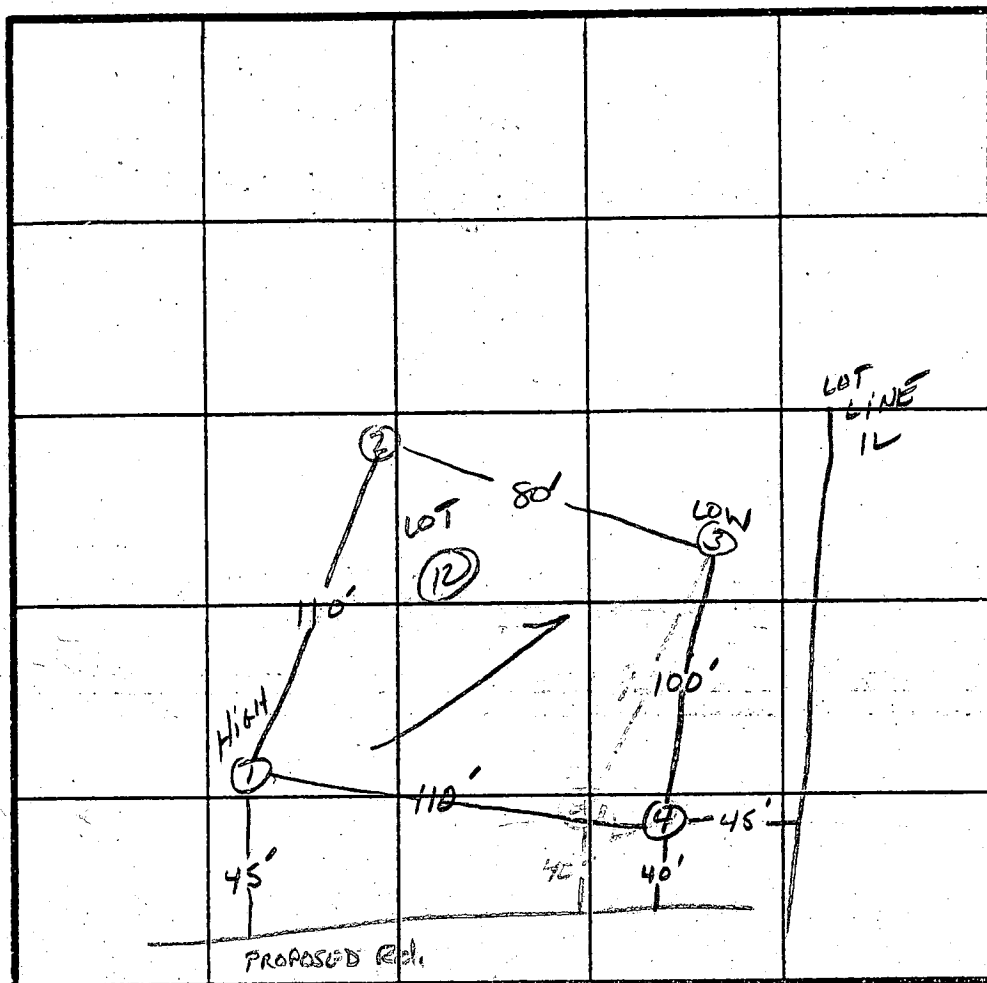

X PERC 17
INLET 4
BOTTOM 6

210 #/BR

INDICATE NORTH - NAME ADJOINING ROADWAY AS BASE LINE.

BRIGHTON DAM

DATE	TEST NO.	DEPTH	PRE-WET		TEST - 1" DROP		TIME
			START	STOP	START	STOP	
3/29/85	1S	4'	11:03	11:14	11:14	11:34	20min
	1V	13'	VARYING SOIL STRUCTURE SEE PROFILE				
	2S	4'	11:07	11:09	11:09	11:14	5min
	2V	12.5'	SAME AS HOLE #1				
	3S	3'	11:18	11:32	11:32	12:00	28min
	3V	13'	UNIFORM SOIL STRUCTURE Below 3'				
	4S	4.5'	11:35	11:41	11:41	11:53	12min
	4V	13'	UNIFORM SOIL STRUCTURE Below 4'				

REMARKS

HOLES PER PLAT APPROXIMATELY

TYPE OF SOIL

Sabel

SKIP, LBS, TERRY