

Recorded

APPLICATION

SEWAGE DISPOSAL TESTING

MARYLAND STATE DEPARTMENT OF HEALTH

HOWARD COUNTY

ELLICOTT CITY

DISTRICT 5

DATE 5/14/65

*5/18/65 accept no more appointments
for this lot ~~as~~ as it has been given
a final rejection. sums*

TO: THE COUNTY HEALTH OFFICER
ELLICOTT CITY, MARYLAND

I, HEREBY, APPLY FOR THE NECESSARY TESTS IN ORDER TO CONSTRUCT (OR RECONSTRUCT) A SEWAGE DISPOSAL SYSTEM.

PROPERTY OWNER Norman Sealing

ADDRESS Box 105 - Brookeville, Md. PHONE AT 6-2206

PROPERTY LOCATION:

SUBDIVISION Highland Acres LOT NO. 16, Sec. 3

ROAD AND DESCRIPTION West Nugget Court

OCCUPANT _____ PHONE _____

PERSON TO CONSTRUCT SYSTEM _____

ADDRESS _____ PHONE _____

SIZE OF LOT 55,088 sq. ft. TYPE BLDG. 3
NUMBER OF BEDROOMS

IF NOT SINGLE RESIDENCE DESCRIBE _____

SIGNATURE OF APPLICANT Norman A. Sealing


APPROVED BY _____ FOR _____ DATE _____

REJECTED BY D.W. Monaghan FOR Septic System DATE 5-18-65
(KIND OF SYSTEM)

HOLD PENDING FURTHER TESTS _____ DATE _____

REASONS FOR REJECTION OR HOLDING 5-18-65 - water at 11ft. inadequate penetration
at depth from 4ft to 7ft. - Pen Soil from top of ground to 7ft or better (mostly clay)

THIS IS NOT A PERMIT

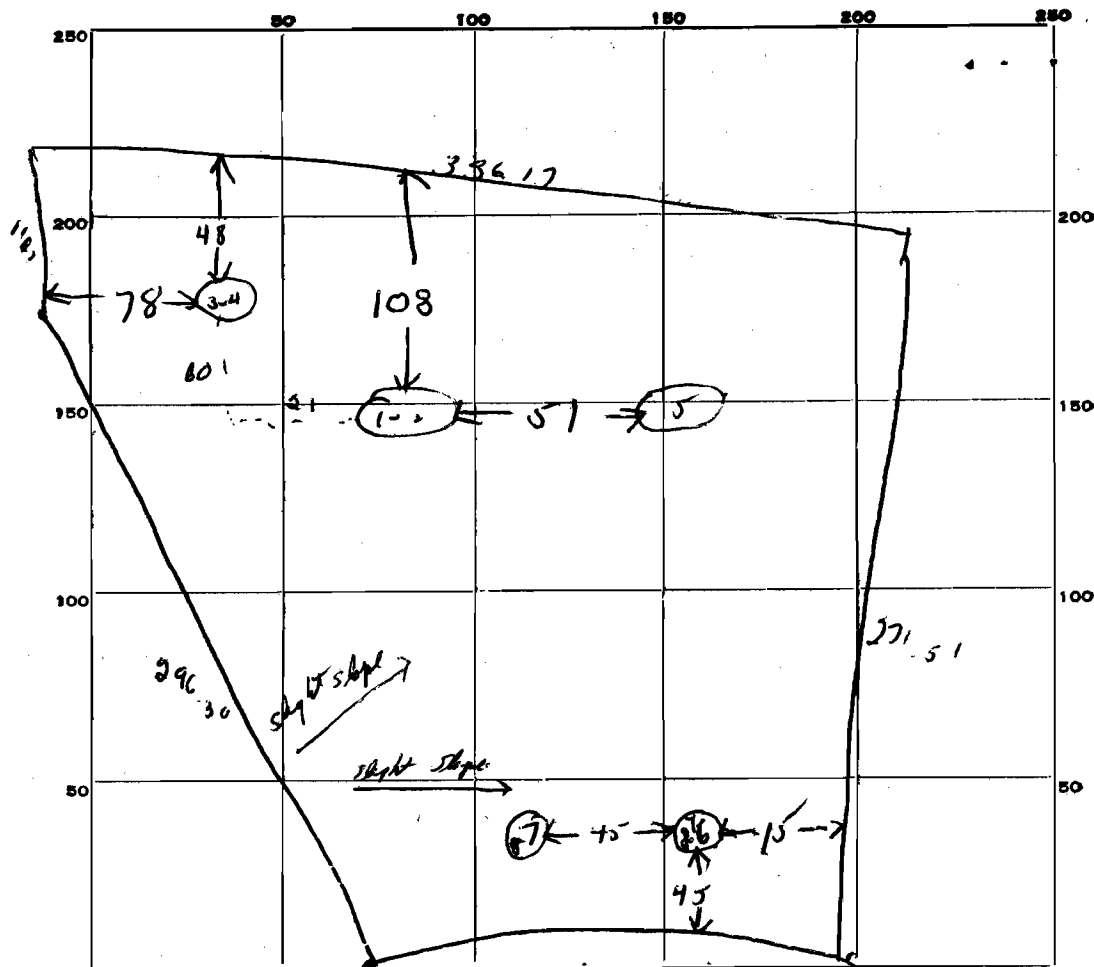

DATE	TEST NO.	DEPTH	PRE-WET		TEST - 1" DROP		TIME
			START	STOP	START	STOP	
5/18/65	1	8 ft	9 <u>48</u>	10 <u>04</u>	10 <u>04</u>	slightly wet at about 1/2 in depth	10 35
	2	4 1/2 ft	9 <u>49</u>	9 <u>55</u>	9 <u>55</u>	slightly wet at no pore	10 30
	3	8 ft	9 <u>58</u>	slightly wet	10 <u>28</u>	no percolation	
	4	4 ft	9 <u>59</u>	10 <u>02</u>	10 <u>02</u>	10 <u>18</u>	16 min
	5		all clay				
	6	10 ft	10 <u>34</u>	10 <u>32</u>	10 <u>37</u>	10 <u>43</u>	6 min
	7	11 ft	10 <u>53</u>	11 <u>03</u>	11 <u>03</u>	11 <u>16</u>	13 min
		5 ft	11 <u>06</u>	no percolation			
actual depth: 7 ft	same pit whole hole 6-8 in. leak	17 ft	11 <u>25</u>	little pore. stop test less than 1/2 unit in 20 min.			

SOIL AUGER FINDING: hole #6 - first 4 ft is clay. 4 to 5 ft clay, red clay.

REMARKS. hole # 6 dug out 1 ~~1~~^{1 1/2} ft. ^{ht.} water

N. Sealing