


THIS IS TO CERTIFY THAT WE HAVE
MADE A LOCATION SURVEY OF THE
IMPROVEMENTS, AND THAT THEY ARE
LOCATED ON THE LOT AS SHOWN HEREON.

William D. Hartel

REQ. NO. **9436**

11/11/75

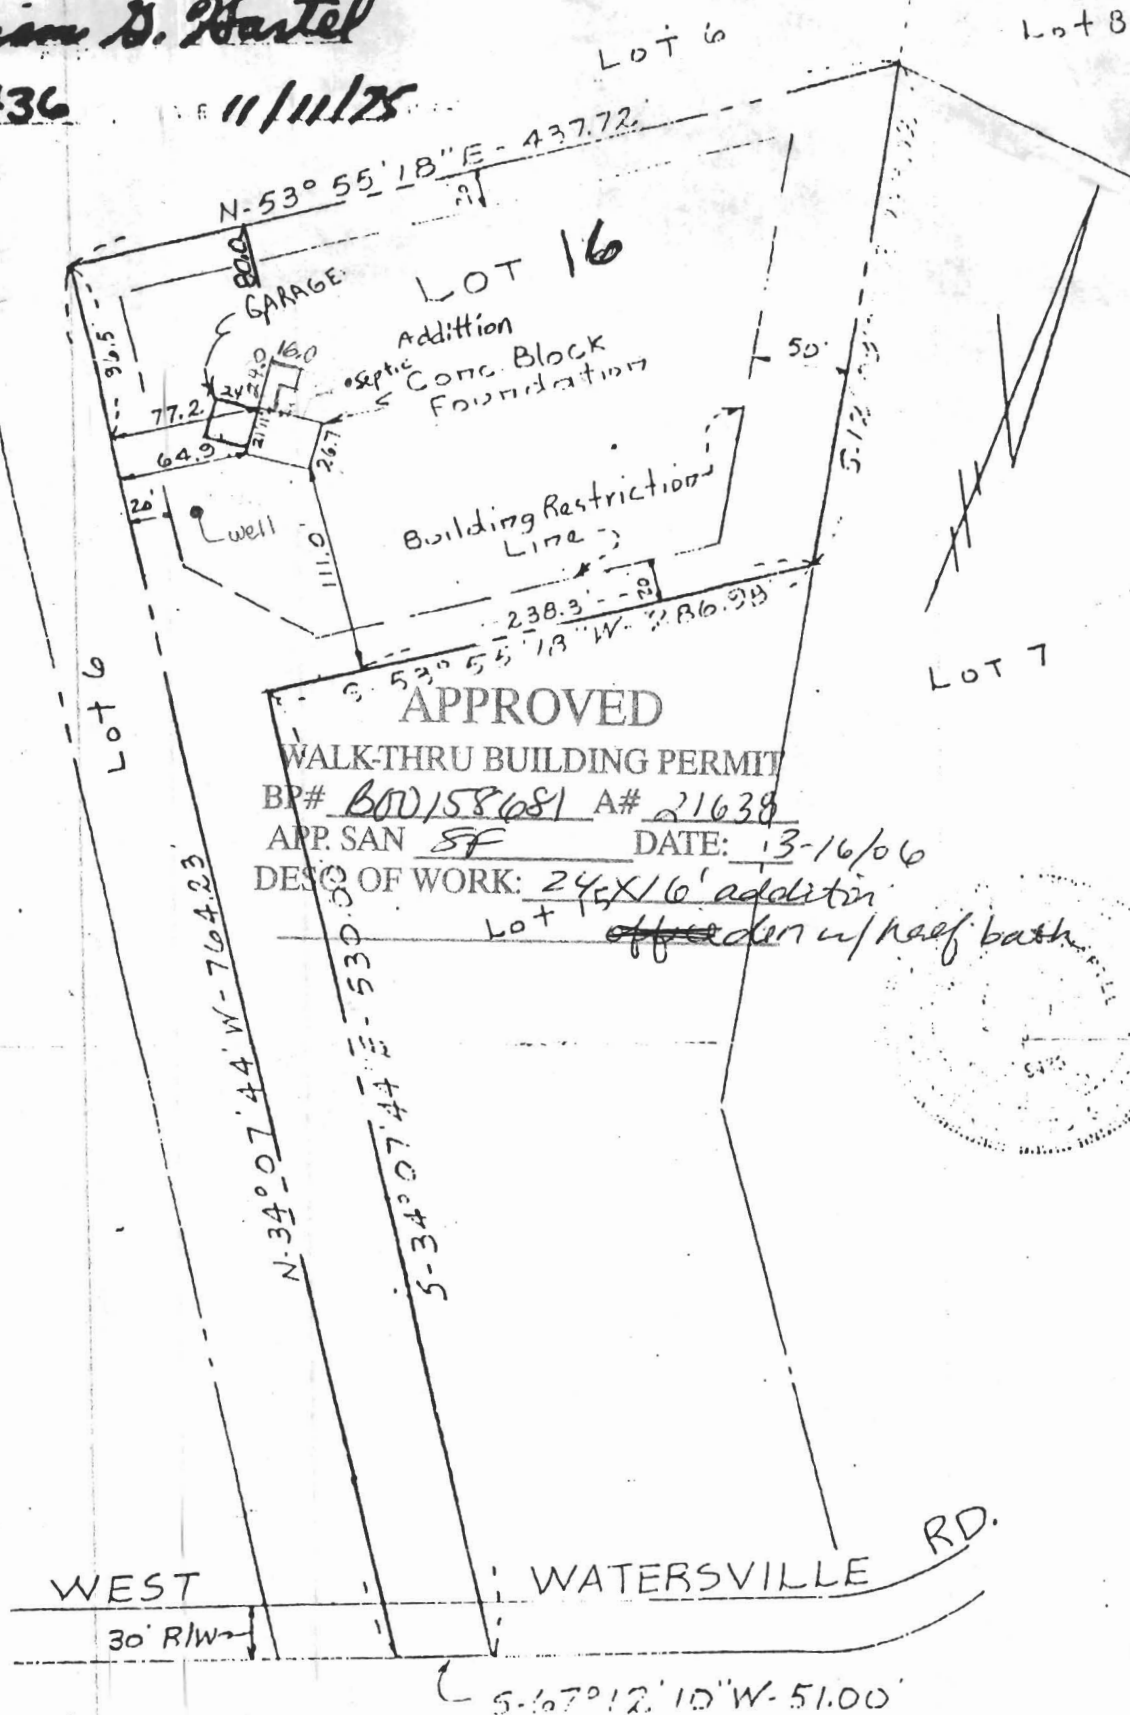

APPROVED
WALK-THRU BUILDING PERMIT
BP# 600158681 A# 21638
APP. SAN SF DATE: 13-16/66
DESC OF WORK: 24'x16' addition
off feeder w/ half bath



TITLE

FOUNDATION CERTIFICATION

PROJECT

LOT 16 - DICKEY FARMS, INC.

LOCATION

4TH ELECTION DISTRICT, HOWARD CO., MD.

DATE:

11/11/75

DES. BY:

—

DRAWN BY:

WGH

CHKD. BY:

—

SCALE:

1" = 100'

JOB NO.

7423-3

DRWG. NO.:

1 of 1

ENGINEERING
PLANNING
SURVEYING
BY

**BOENDER
ASSOCIATES
INC.**

BALTIMORE, MD. 465-7777
SALISBURY, MD. 749-1288
WESTMINSTER, MD. 848-6588