

APPLICATION

A 21638

P _____

SEWAGE DISPOSAL TESTING

STATE OF MARYLAND - DEPARTMENT OF HEALTH AND MENTAL HYGIENE

HOWARD COUNTY HEALTH DEPARTMENT
ENVIRONMENTAL HEALTH SERVICES
P. O. BOX 476, ELLICOTT CITY, MARYLAND 21043
TELEPHONE: 465-5000, EXT. 356

DISTRICT 4

DATE 6/23/75

4-12' Lateral in 10,000 ft
6/24/75 9:30
3 B.R. 1000 gal. septic tank | *4 B.R. 1250 gal. septic tank*
Dry Well - 148 sq. ft. absorbent sidewalk area per bedroom to begin below the first 4 ft of original grade. Max depth permitted for Dry Well is 11 ft below original grade.

Please Dry Well 148 ft from left sideline and 100 ft from rear lot line as seen when facing lot from W. Watersville Rd.

TO: THE COUNTY HEALTH OFFICER
ELLICOTT CITY, MARYLAND

** manhole top of element to grade level on septic tank must be provided*

I, HEREBY, APPLY FOR THE NECESSARY TESTING, ORDER TO CONSTRUCT (OR RECONSTRUCT) A SEWAGE DISPOSAL SYSTEM.

PROPERTY OWNER William C. Birely, Jr.

ADDRESS 6603 Copper Ridge Drive, Baltimore, Md. 21209 PHONE 484-4623

PROPERTY LOCATION:

SUBDIVISION _____ LOT NO. 16

ROAD AND DESCRIPTION West Watersville Road (see plat for directions)

SIZE OF LOT 2.788 acres TYPE BLDG. 3
NUMBER OF BEDROOMS

IF NOT SINGLE RESIDENCE DESCRIBE _____

THE SYSTEM INSTALLED UNDER THIS APPLICATION IS ACCEPTABLE ONLY UNTIL PUBLIC FACILITIES BECOME AVAILABLE.

SIGNATURE OF APPLICANT /s/ William C. Birely, Jr.

✓ APPROVED BY John M. Hays FOR Dry Well DATE 7-29-75
(KIND OF SYSTEM)


REJECTED BY _____ FOR _____ DATE _____
(KIND OF SYSTEM)

HOLD PENDING FURTHER TESTS WW2 & FS DATE 6/24/75

REASONS FOR REJECTION OR HOLDING final plat w/ certified test holes

BLDG. PERMIT SIGNED
AND RETURNED 9/5/75

THIS IS NOT A PERMIT

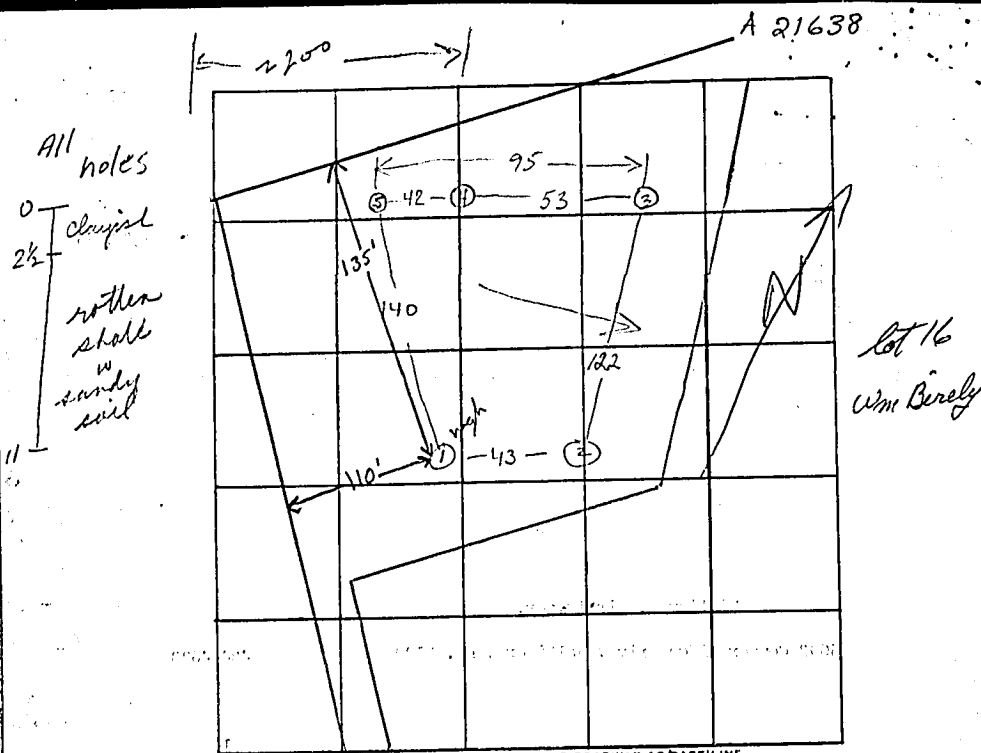

INDICATE NORTH - NAME ADJOINING ROADWAY AS BASELINE

740 W. Waterville Rd.

DATE	TEST NO.	DEPTH	PRE-WET		TEST - 1" DROP		TIME
			START	STOP	START	STOP	
6/24/75	1	4 1/2	10:27	10:30	10:30	10:36	6
	1-A	12	10:26	10:29	10:29	10:38	9
	2	3 1/2	10:36	10:42	10:42	11:00	18
	2-A	10 1/2	10:33	10:34	10:34	10:37	3
	3	3	10:45	10:59	10:59	11:26	27
	3-A	10 1/2	10:41	10:46	10:46	11:00	14
	4	4	11:02	11:06	11:06	11:12	10
	4-A	11	Visual; same to 1-F				
	5	11	Visual; same to 1-F				

REMARKS

System in hole #1

TYPE OF SOIL

Sandy soil w rotten shale

TESTED BY

FS & WWZ

ALSO PRESENT: