


778 W. WATERSVILLE RD

Carolyn "Nicky" Ratliff  
778 W. Watersville Rd.  
Mount Airy, MD 21771

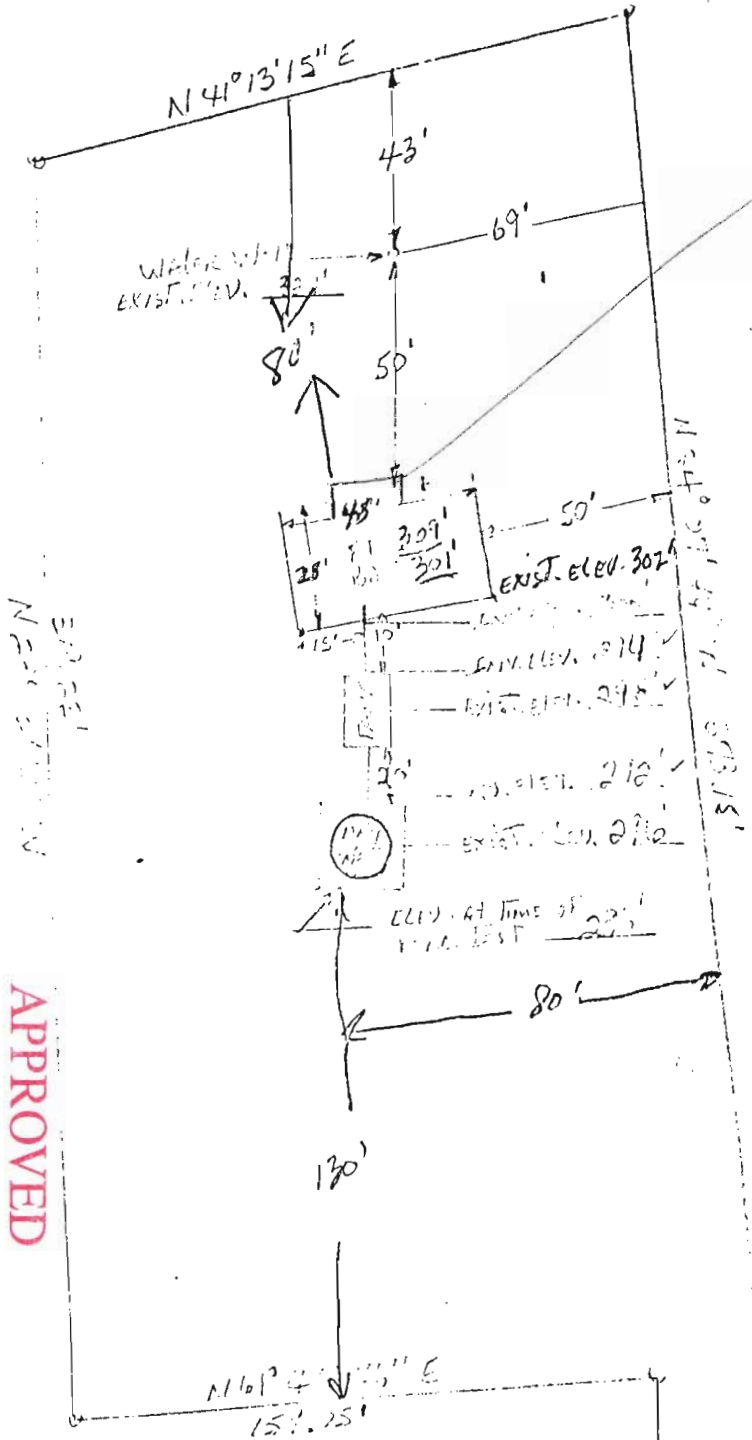

Proposed  
Cement patio  
13' x 18'  
w/ 30" footers

Approved by  
9/14/05  
07(B00155815)

appears ok 9/21/06  
C.B.S.

APPROVED

WALK-THRU BUILDING PERMIT

BP# 600155815 A# 517934-A

APP. SAN 5FD DATE: 9/2/05

DESC. OF WORK: Patio Enclosure

13 x 18 over cement patio

Scale 1" = 50'

Hand-drawn site plan showing the proposed patio and existing features. The plan includes various measurements and annotations for the proposed structure and existing features.