

# PERMIT

004721

SEWAGE DISPOSAL SYSTEM

A \_\_\_\_\_

MARYLAND STATE DEPARTMENT OF HEALTH

HOWARD COUNTY

ELLICOTT CITY

DISTRICT \_\_\_\_\_

## INDEXED

DATE 2-16-59

Walter D. Bowman IS PERMITTED TO INSTALL ALTER

ADDRESS Mr. City PHONE Sykes 36394

A SEWAGE DISPOSAL SYSTEM LOCATED AT 1/2 mile Mc Kendrick Church Rd.  
S. of Rt. 144

SUBDIVISION \_\_\_\_\_ ROAD \_\_\_\_\_ LOT \_\_\_\_\_

PROPERTY OWNER Ridgely, Warren

ADDRESS Glady

### SPECIFICATIONS

DRAIN FIELD \_\_\_\_\_ DEPTH \_\_\_\_\_ FEET, BOTTOM AREA 150 - 2 ft. wide SQ. FT.

SEEPAGE PITS \_\_\_\_\_ ABSORBENT SIDE-WALL AREA \_\_\_\_\_ SQ. FT.

SEPTIC TANK CAPACITY 450 GALLONS

FOR GARBAGE GRINDER, INCREASE DISPOSAL AREA 22% & TANK CAPACITY 50%.


OTHER \_\_\_\_\_

PLANS APPROVED BY Palmer J. Ueno DATE 2-14-59

FILL SEPTIC TANK AND DISTRIBUTION BOX WITH WATER BEFORE CALLING FOR AN INSPECTION. COVER NO WORK UNTIL INSPECTED AND APPROVED.

NEITHER THE HOWARD COUNTY COMMISSIONERS NOR THE HEALTH DEPARTMENT IS RESPONSIBLE FOR THE SUCCESSFUL OPERATION OF ANY SYSTEM.

004721

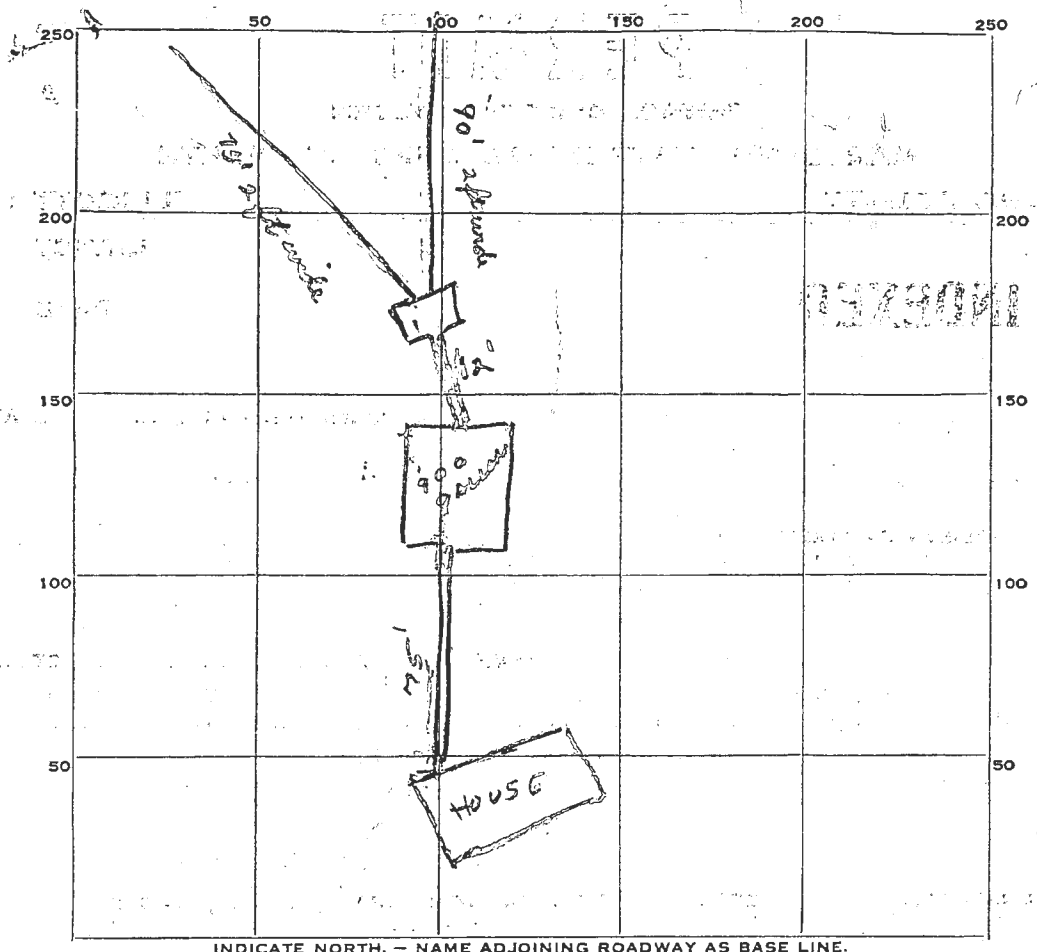

INDICATE NORTH. - NAME ADJOINING ROADWAY AS BASE LINE.

27  
3  
74  
  
80  
9  
10  
164

PERMIT CARD \_\_\_\_\_

SEPTIC TANK, LEVEL O.K. OVERSIDE CLEANOUTS \_\_\_\_\_

DISTRIBUTION BOX, LEVEL OK \_\_\_\_\_

TILE FIELD, DEPTH 3 FT. TRENCH WIDTH 2 FT.

GRAVEL DEPTH 1.5 IN. TOTAL LENGTH 165 FT.

NUMBER OF TRENCHES 2 TOTAL BOTTOM AREA 330

SEEPAGE PITS, INSIDE DIAMETER \_\_\_\_\_ FT. DEPTH BELOW INLET \_\_\_\_\_ FT.

ABSORBENT AREA \_\_\_\_\_ SQ. FT.

REMARKS \_\_\_\_\_

\_\_\_\_\_

\_\_\_\_\_

\_\_\_\_\_

\_\_\_\_\_

DATE SYSTEM APPROVED 2/25/59


INSPECTOR Raymond Hodges

90 135  
75 225  
670  
295  
30030

SITE INSPECTION SHEET

OWNER: Beth PHONE #: talk+omebeth@hotmail.com  
ADDRESS: 10222 Brady CONTRACTOR: \_\_\_\_\_  
WELL TAG #: \_\_\_\_\_  
SUBDIVISION: \_\_\_\_\_ LOT: \_\_\_\_\_ COUNTY #: \_\_\_\_\_  
PROPOSAL: Called and inquired about clean ups

LOCATION DIAGRAM

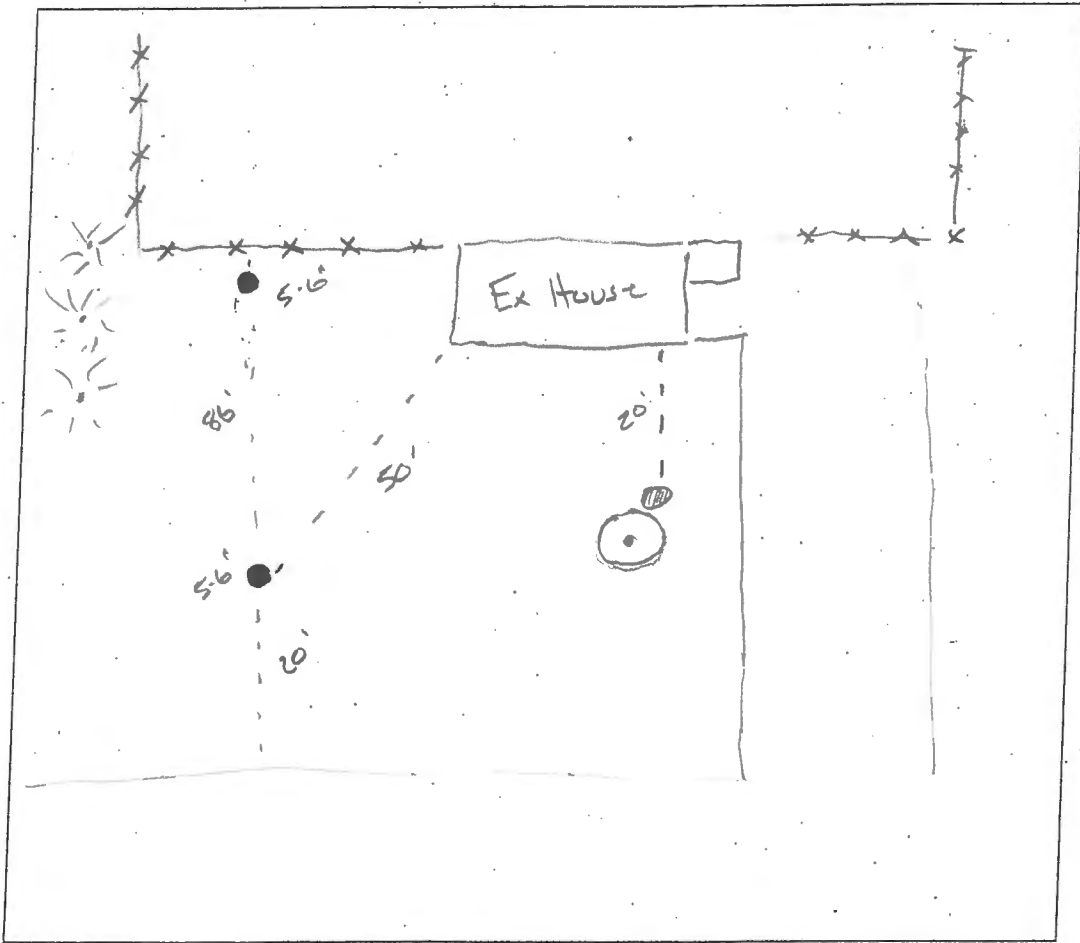

COMMENTS: \_\_\_\_\_  
\_\_\_\_\_  
\_\_\_\_\_  
\_\_\_\_\_

DATE: \_\_\_\_\_ INSPECTOR: RSF

**Freemon, Robert**

---

**From:** Robert Freemon <[REDACTED]>  
**Sent:** Wednesday, August 16, 2017 8:29 AM  
**To:** Freemon, Robert  
**Subject:** Pics







Sent from my iPhone

